


5200 Block Salem Turnpike Project

Replaced existing m.H.

MAIN LINE IS 8" SDR 35

Laterals are 4" SDR 35

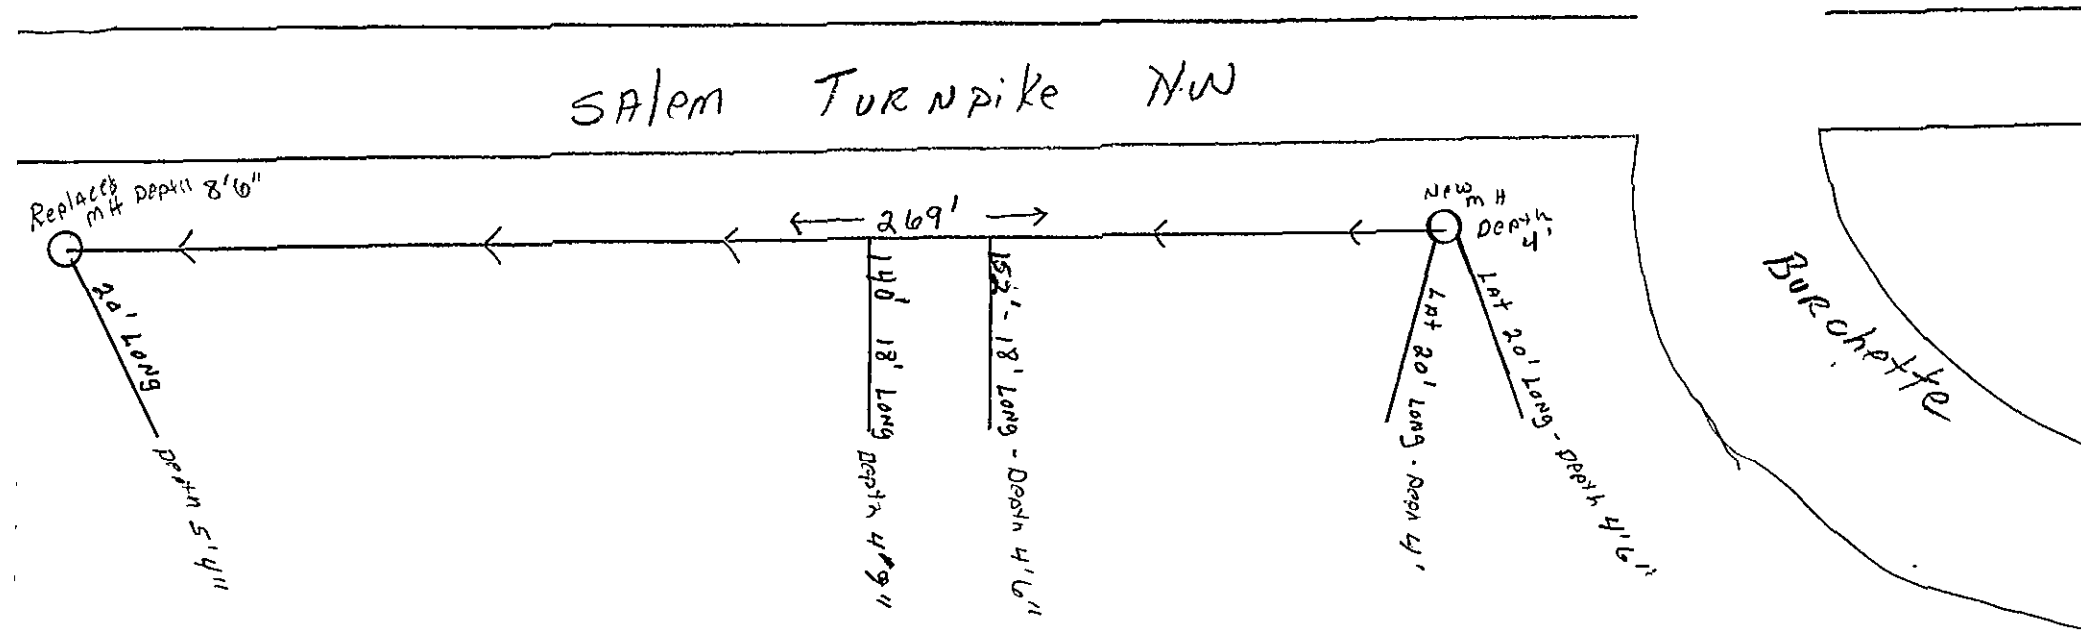

As-Built Draw
Mark Simx
9.29.04

TAF 11.22.04