
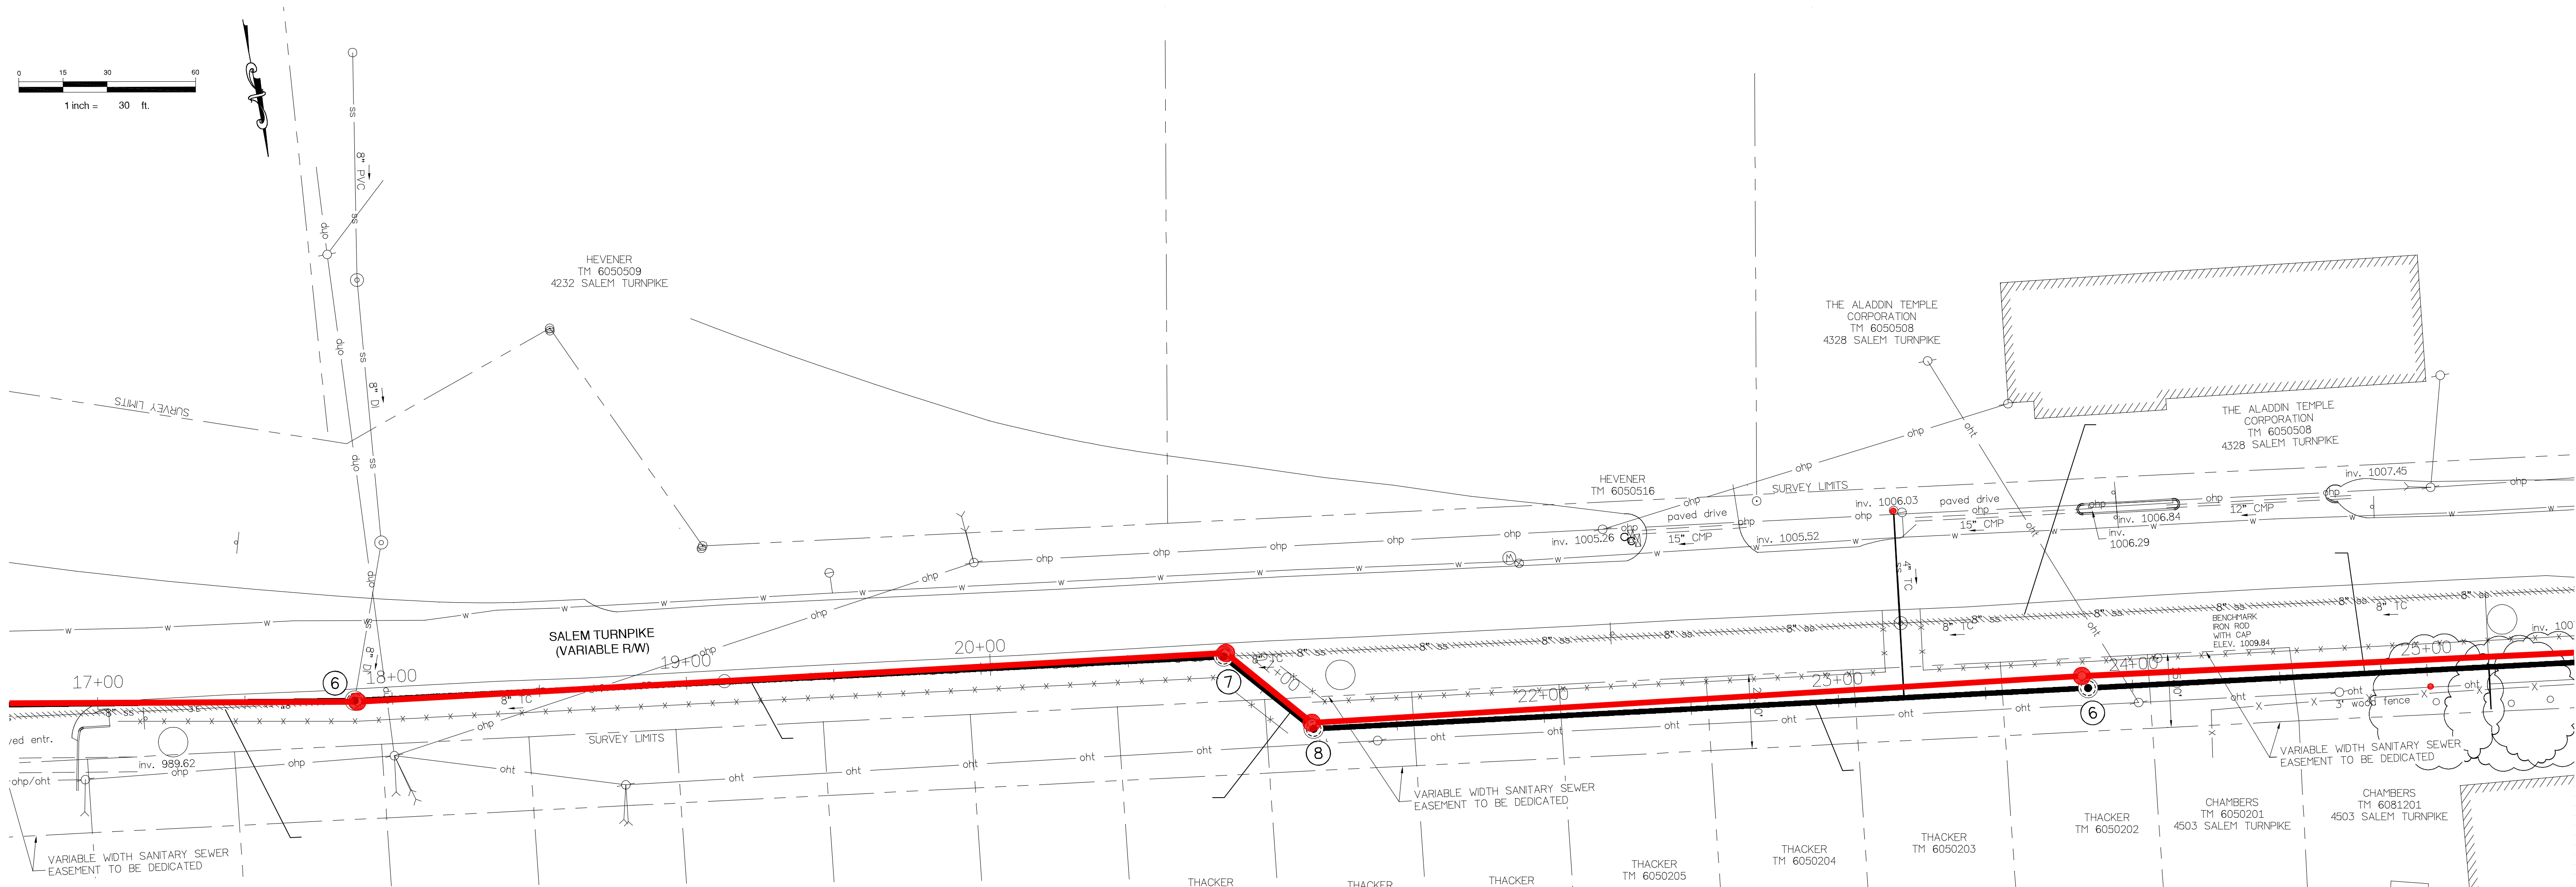


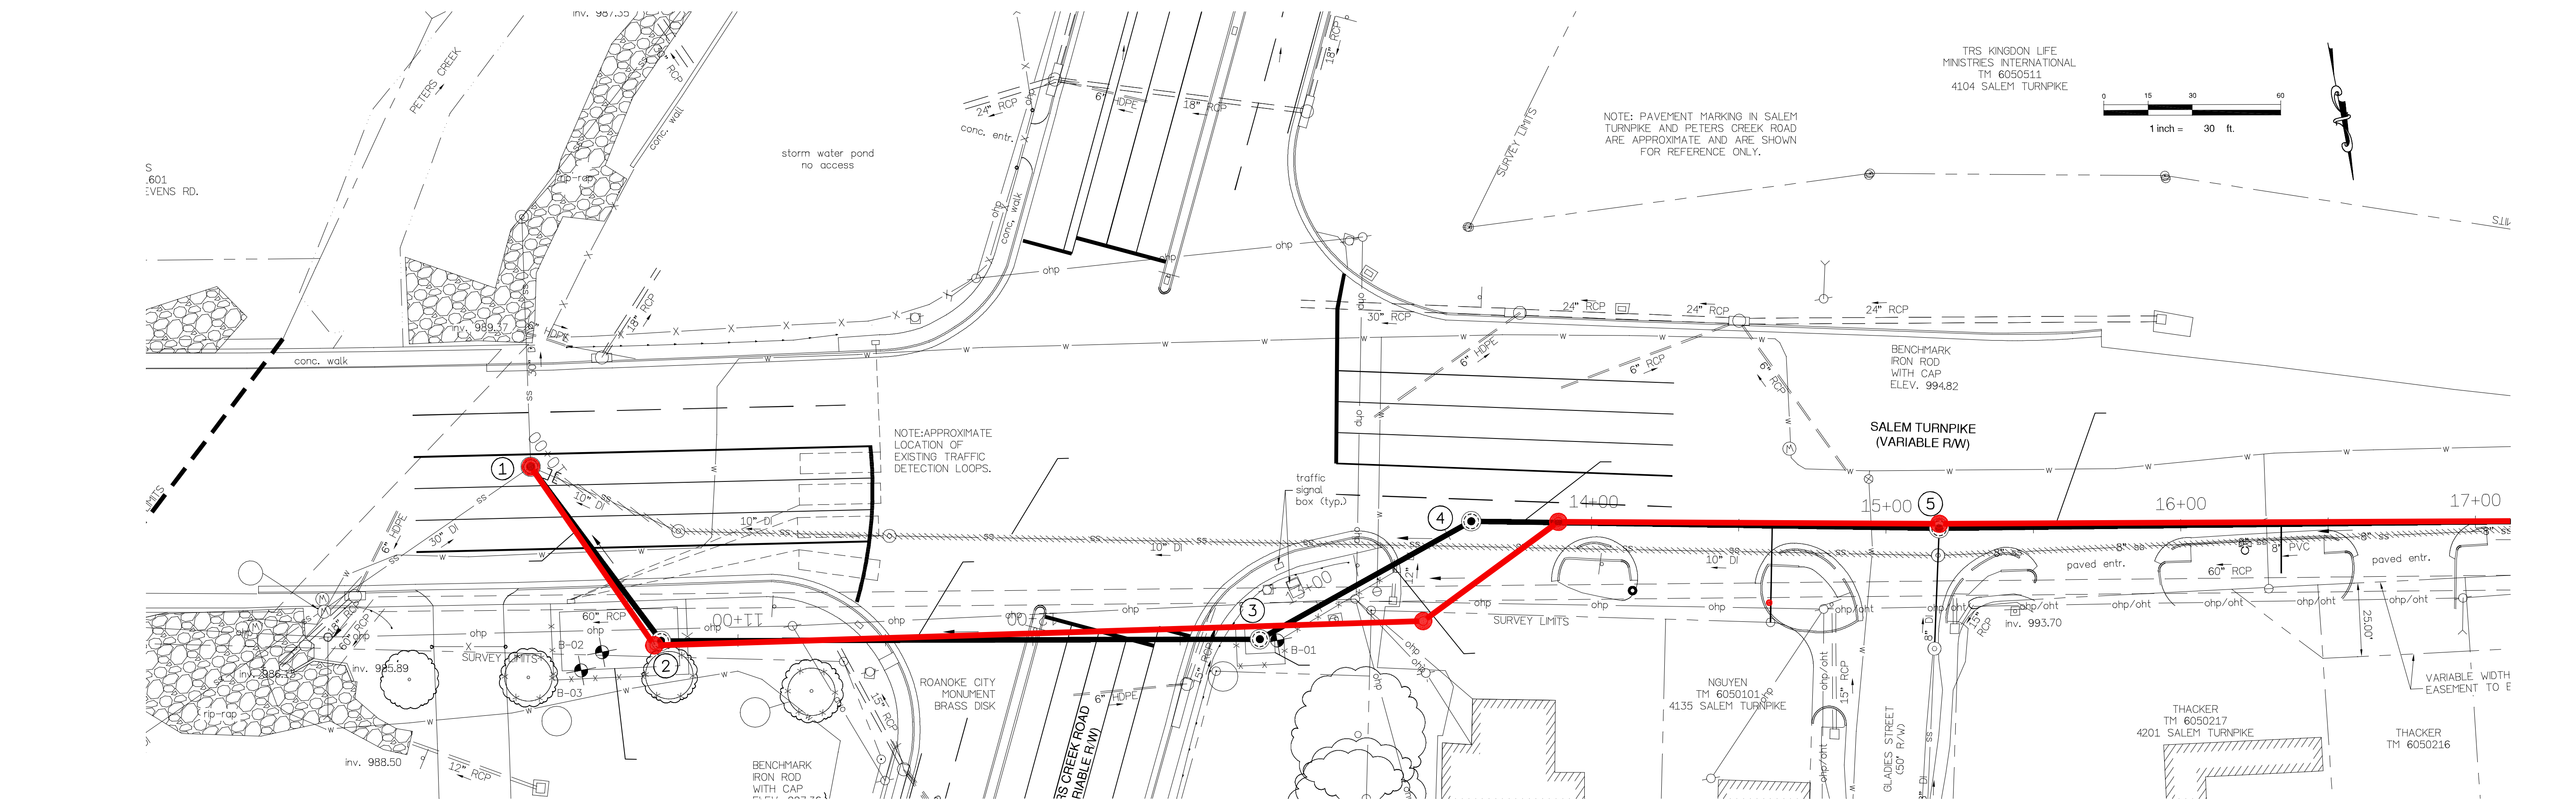


BYER, BENNETT & ASSOCIATES, P.L.C.
4008 RIVER RD., UNIT A
RIVER, VIRGINIA 24149
(540) 381-7004

JOB NO.: C-19-04
DATE: APRIL 20, 2020
SCALE: 1" = 30'

CHECKED BY: DRB
DRAFTED BY: SRB

REVISIONS	DATE	BY

SALEM TURNPIKE SANITARY SEWER IMPROVEMENT
ROANOKE, VIRGINIA
AS-BUILT SURVEY

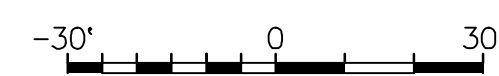

SHEET
1
OF 2

