

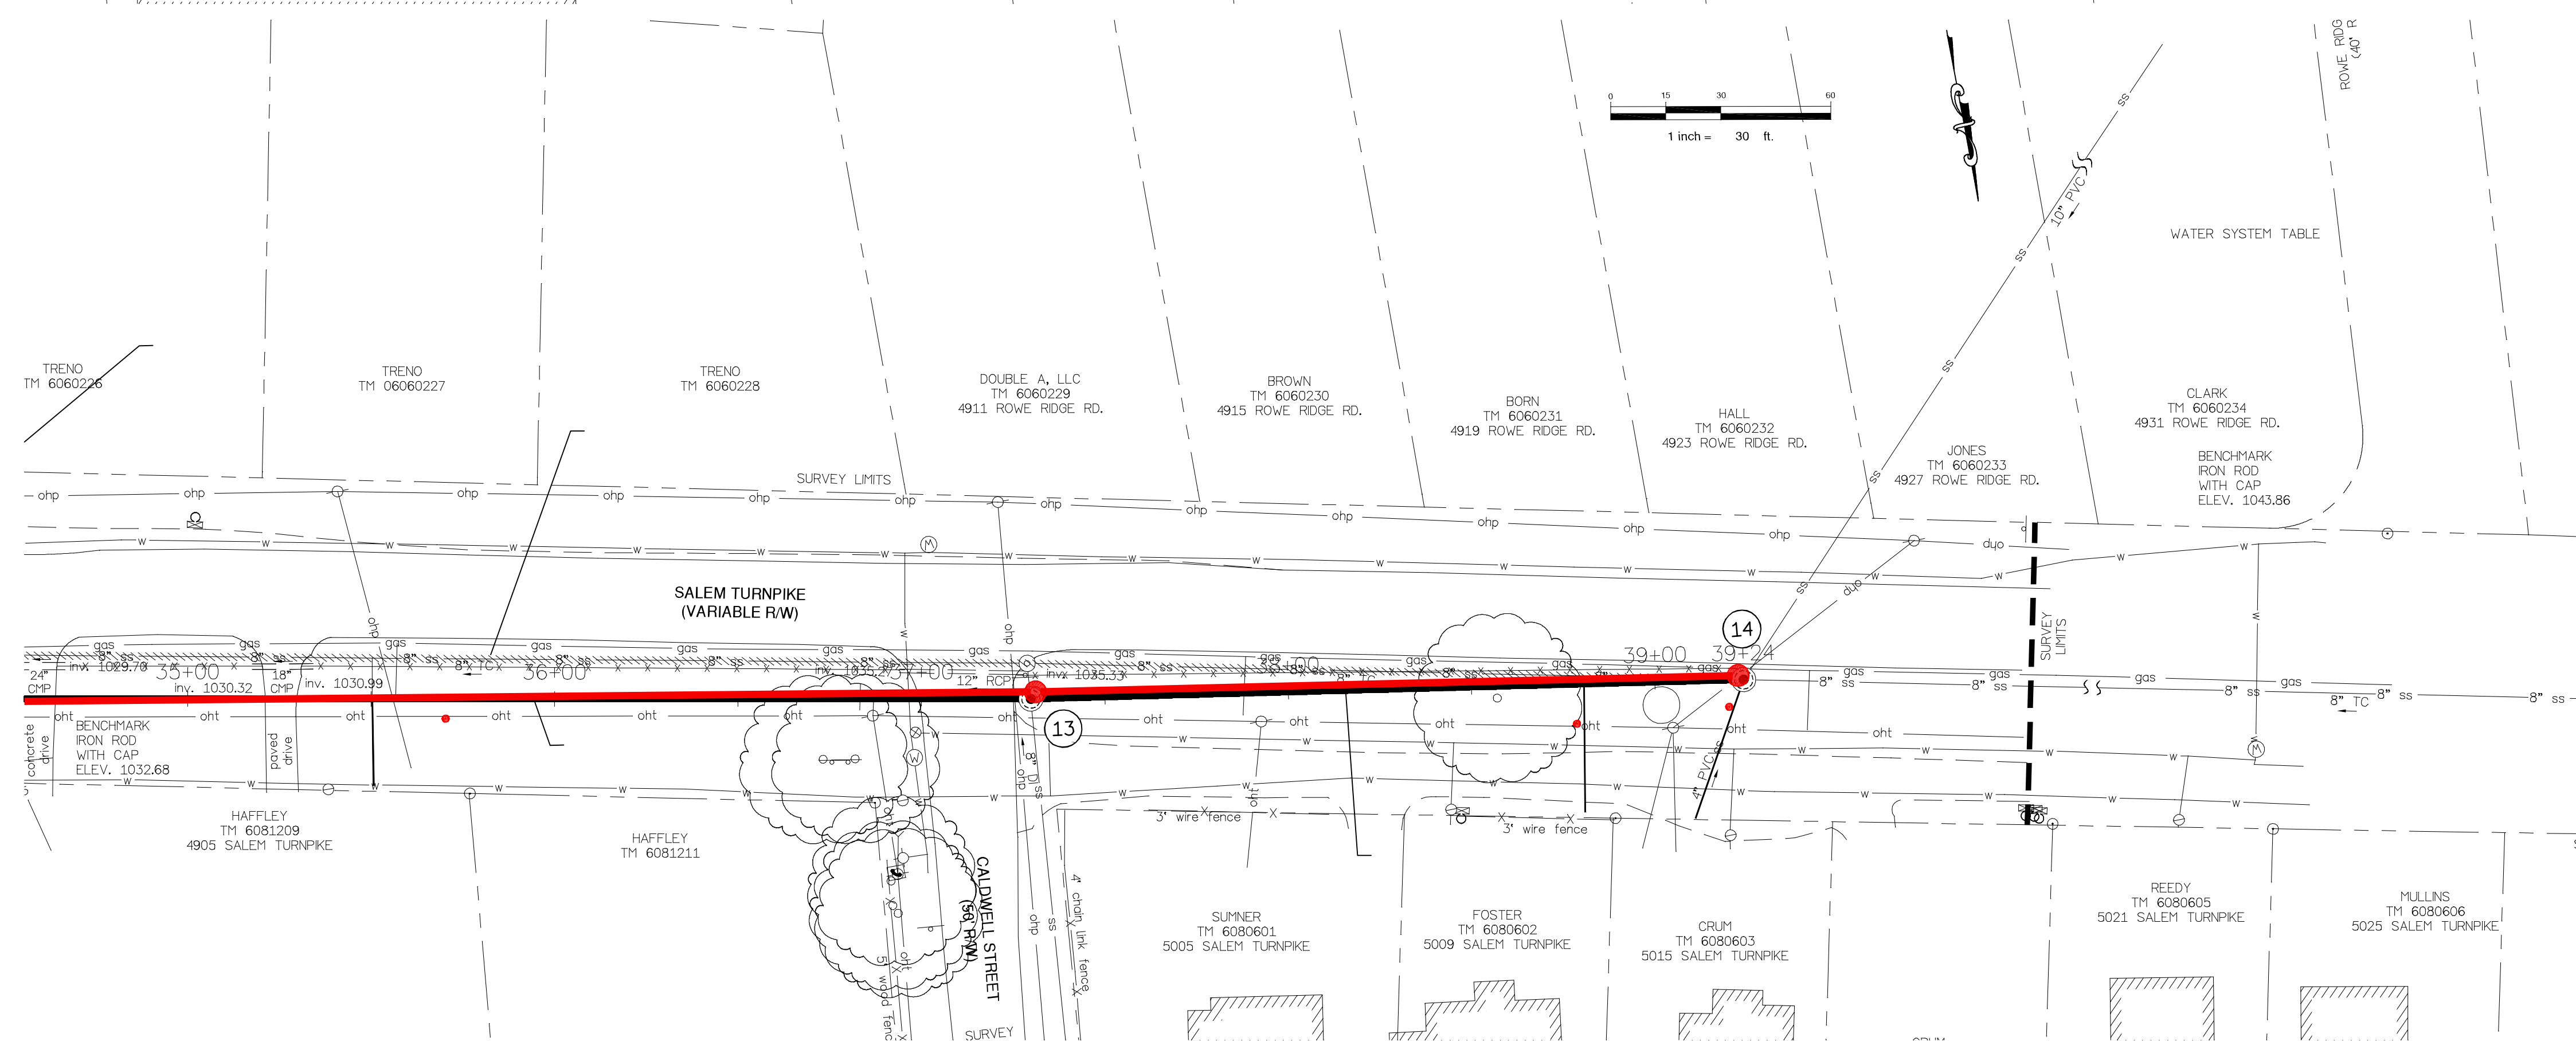
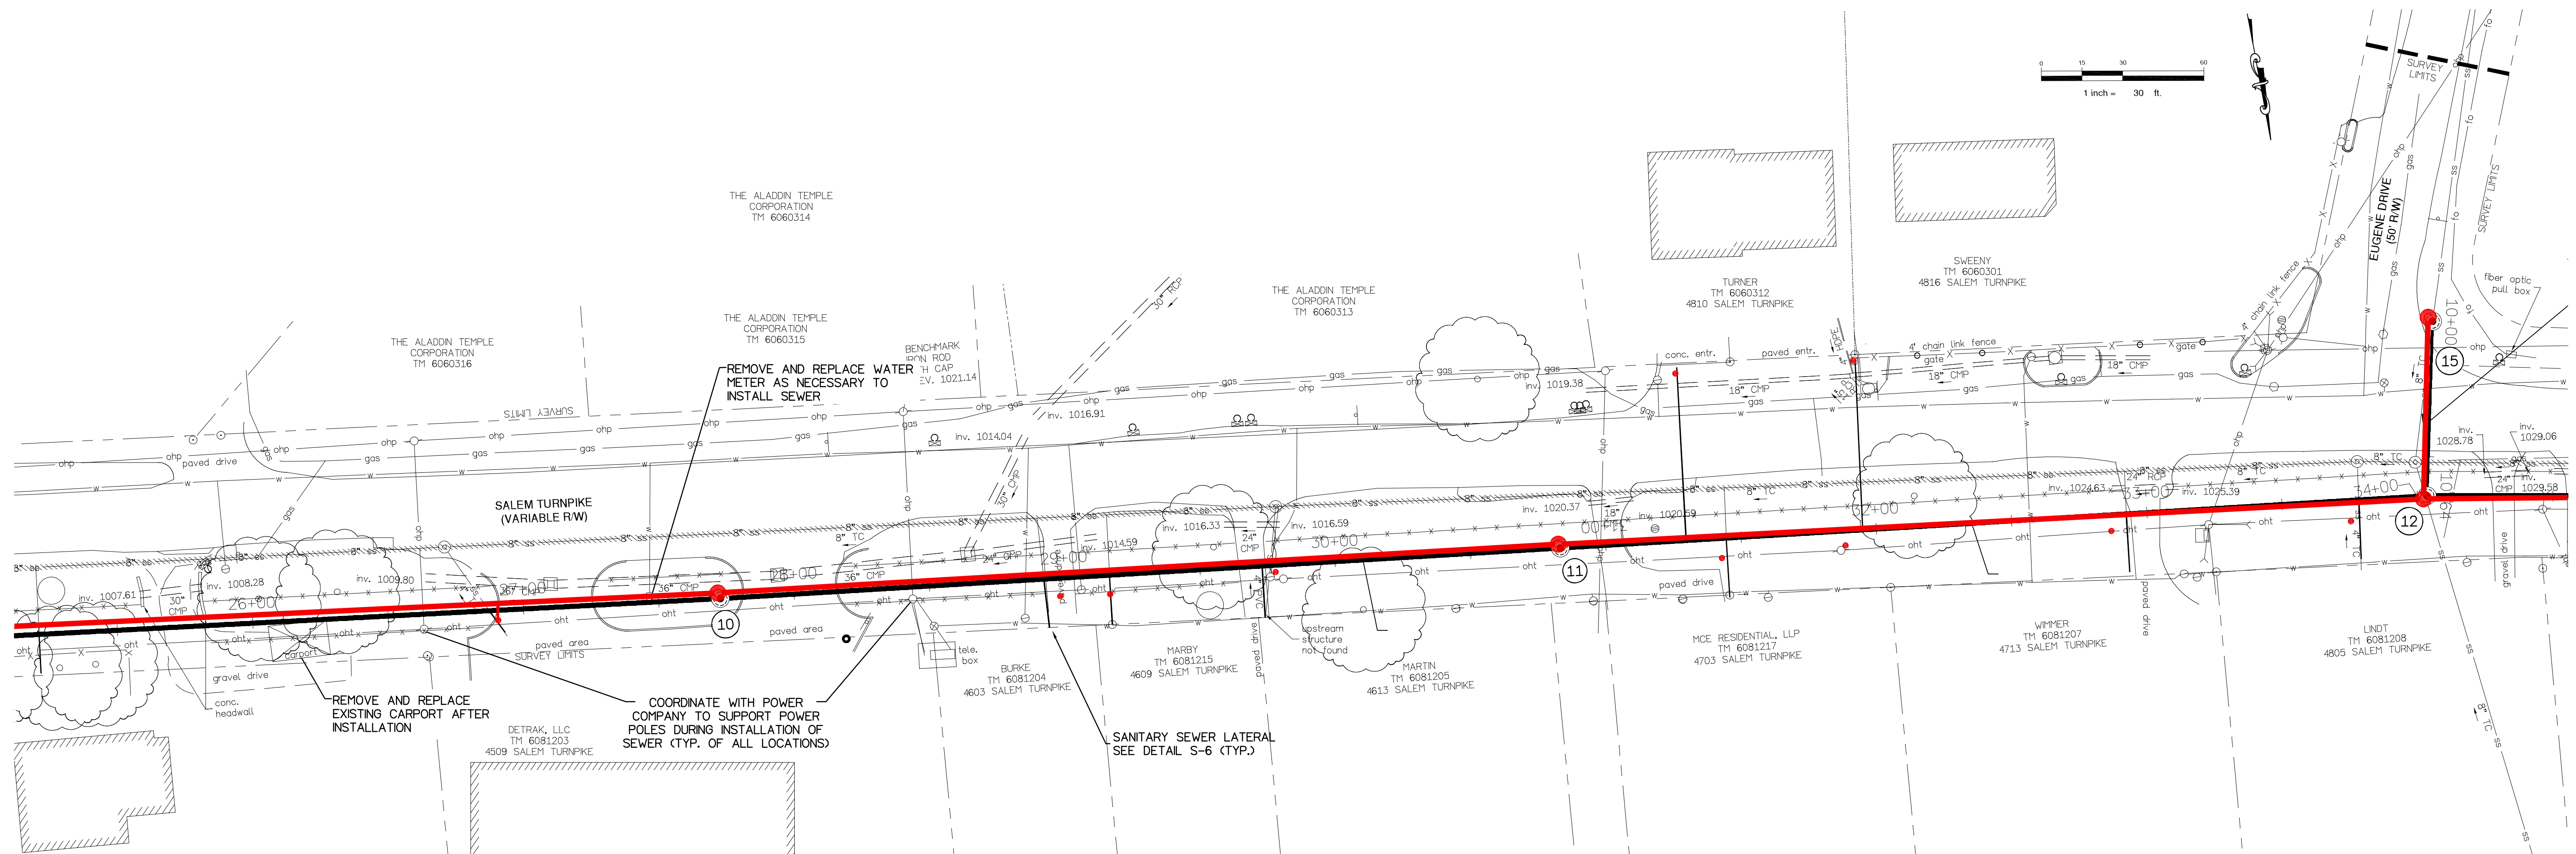


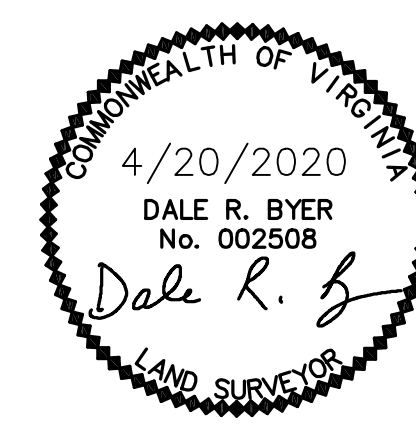

BYER, BENNETT & ASSOCIATES, P.L.C.
4008 RINER RD, UNIT A
RINER, VIRGINIA 24149
(540) 381-7004

JOB NO. :	C-19-04	CHECKED BY:	DRB	REVISIONS	DATE	BY
DATE	APRIL 20, 2020	DRAFTED BY:	SRB			
SCALE	1" = 30'					

SALEM TURNPIKE SANITARY SEWER IMPROVEMENT
ROANOKE VIRGINIA
AS-BUILT SURVEY

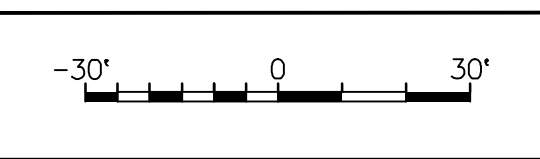

SHEET
2
OF 2