


EROSION AND SEDIMENT CONTROL SYMBOLS

(CIP)		CULVERT INLET PROTECTION
(IP)		STORM DRAIN INLET PROTECTION
(DV)		DIVERSION
(ST)		TEMPORARY SEDIMENT TRAP
(CE)		TEMPORARY GRAVEL CONSTRUCTION ENTRANCE
(RR)		RIPRAP
(SF)		SILT FENCE
(TP)		TREE PROTECTION
(TS)		TEMPORARY SEEDING
(PS)		PERMANENT SEEDING

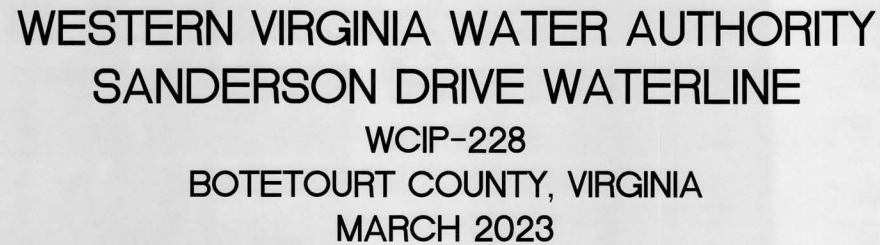

1	COVER SHEET	10	PLAN & PROFILE - 12" WATERLINE
2	GENERAL NOTES & LEGEND	11	PLAN & PROFILE - 12" WATERLINE
3	SURVEY NOTES	12	DETAILS
4	INDEX SHEET / PRV PLAN AND PROFILE	13	DETAILS
5	PLAN & PROFILE - 12" WATERLINE	14	OVERALL MOT PLAN
6	PLAN & PROFILE - 12" WATERLINE	15	READ MOUNTAIN ROAD MOT PLAN
7	PLAN & PROFILE - 12" WATERLINE	16	CONSTRUCTION SEQUENCING PLAN
8	PLAN & PROFILE - 12" WATERLINE	17	EROSION & SEDIMENT CONTROL
9	PLAN & PROFILE - 12" WATERLINE	18	FIRE HYDRANT SERVICE RANGE EXHIBIT

LIMITS OF DISTURBANCE:
0.51 ACRES

WYWA INSPECTOR AS-BUILTS
CHARLES CRUSH
01-30-2024

These plans have been reviewed and approved under WVWA AS&S.
Approved By: Joseph W. Arthur, DCA 0104 Exp. 10/02/2023
Signature: Joseph W. Arthur Date: 3/27/2023

