
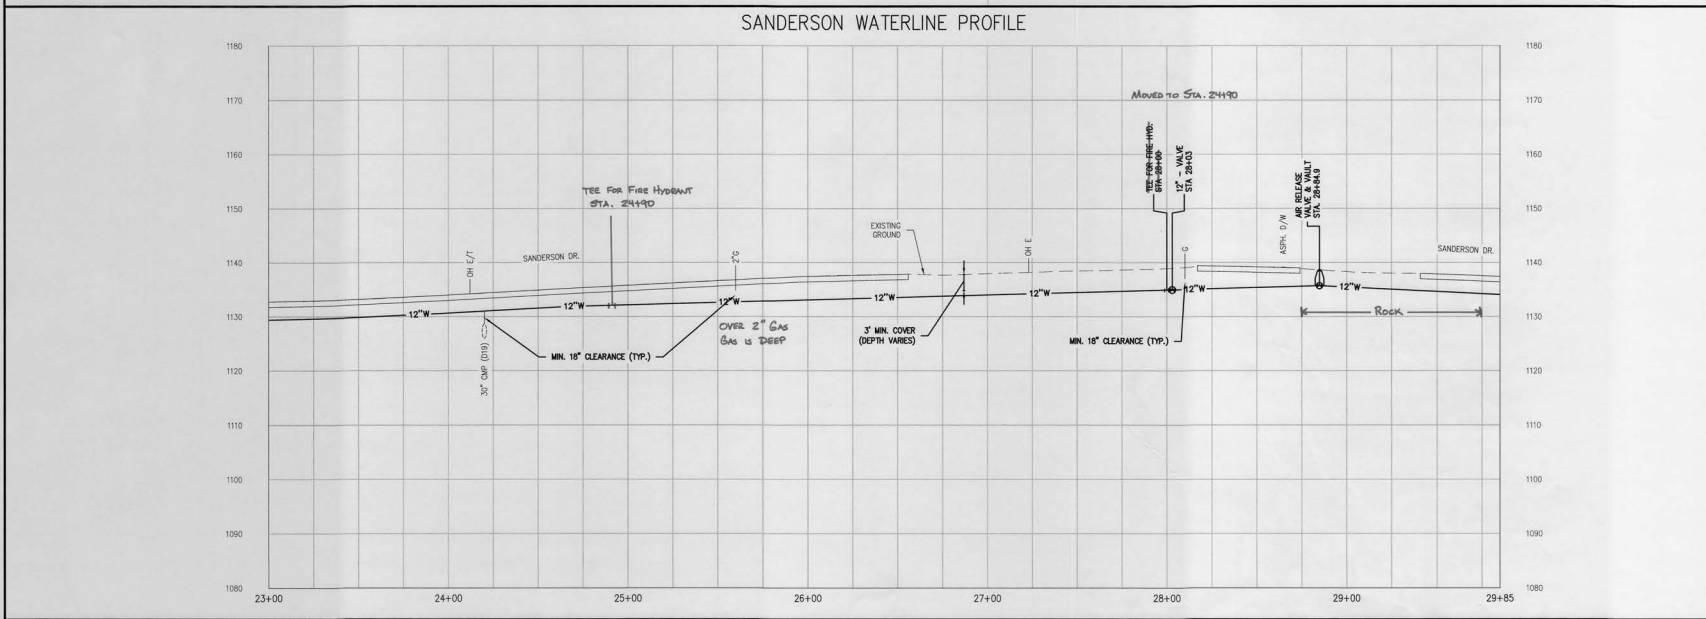


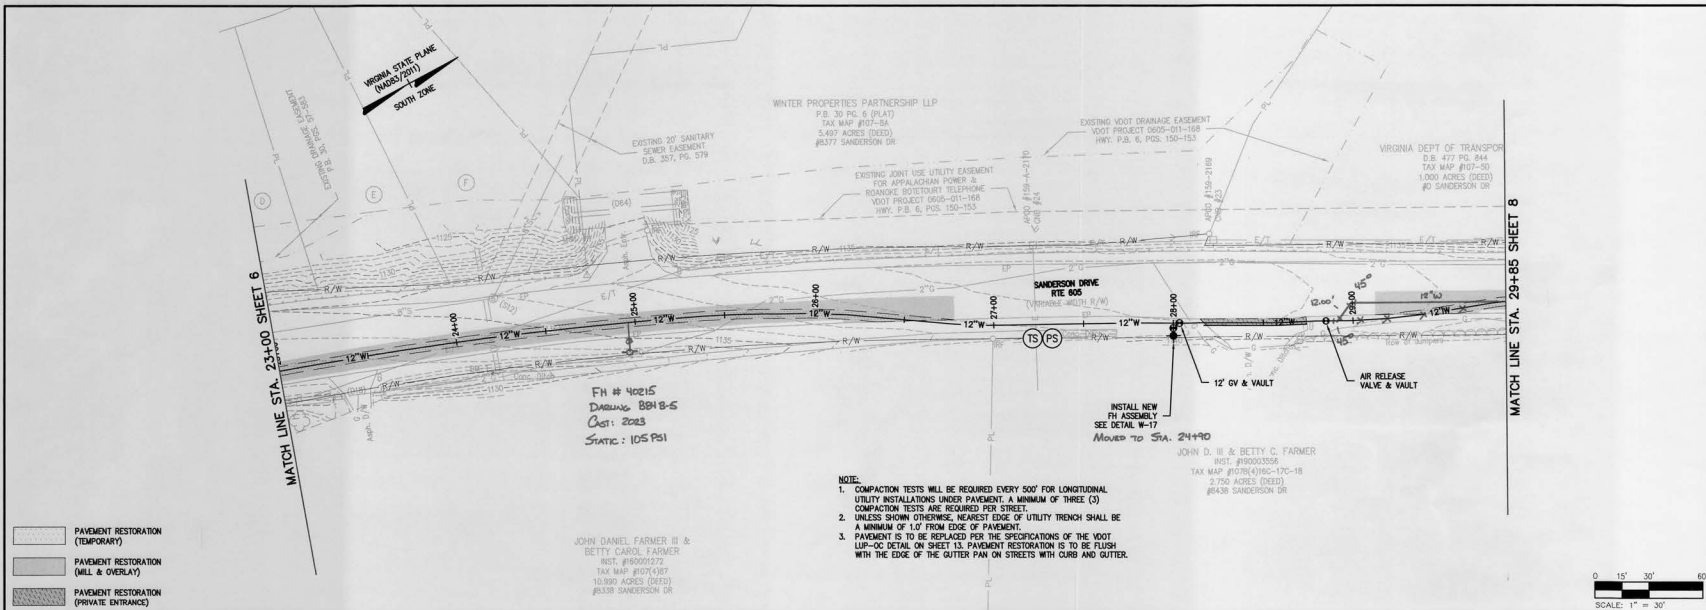

Issue Date:	Mar. 30, 2023
Drawn By:	M.C.
Designed By:	R.K.
Checked By:	R.K.
Date:	03/20/23
Mattern & Craig CIVIL ENGINEERS & ARCHITECTS 701 FIRST STREET, S.W. ROANOKE, VIRGINIA 24010 PHONE: (540) 345-3881 FAX: (540) 345-3881	
SANDERSON DRIVE WATERLINE PLAN & PROFILE - 12" WATERLINE BOTETOURT COUNTY, VIRGINIA	
Vertical Scale:	1"=10'
Horizontal Scale:	1"=30'
Commission Number:	4230B
Sheet No.:	7