

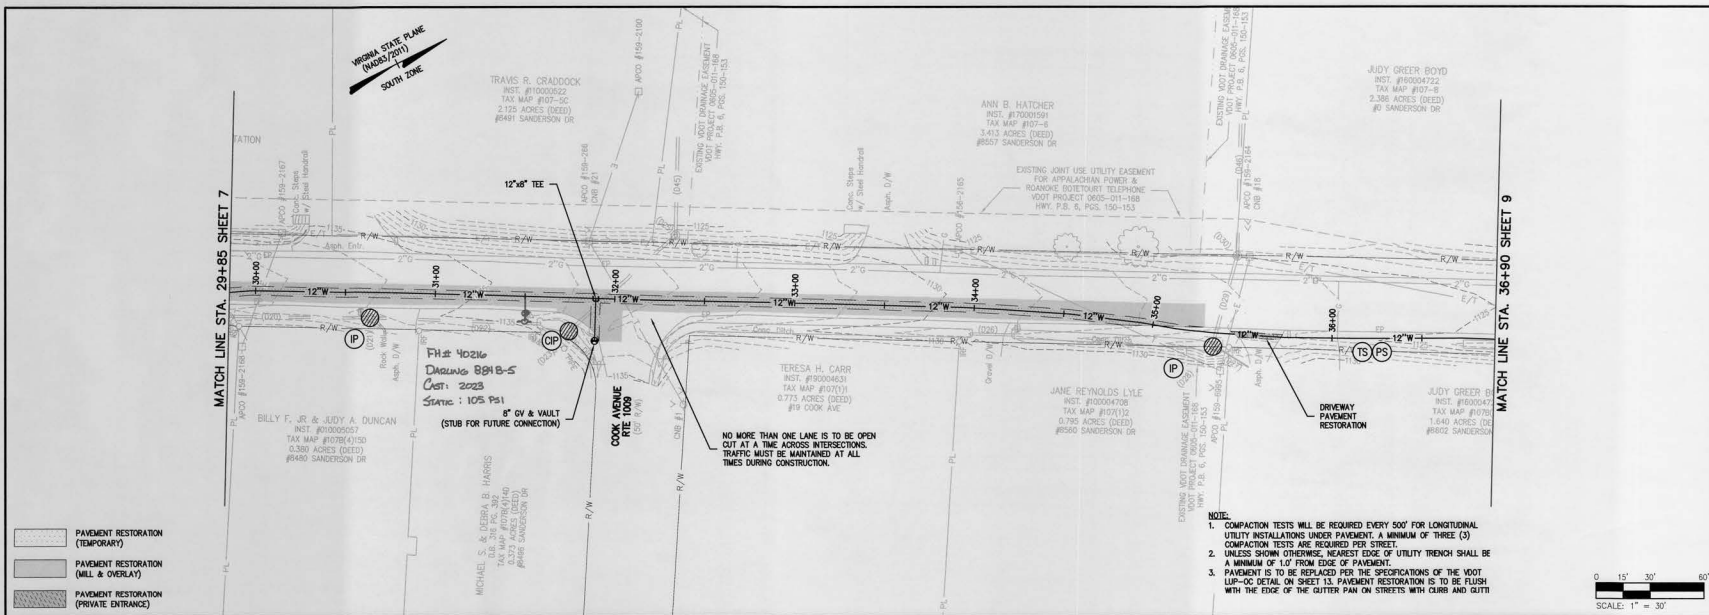


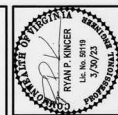

SANDERSON WATERLINE PROFILE

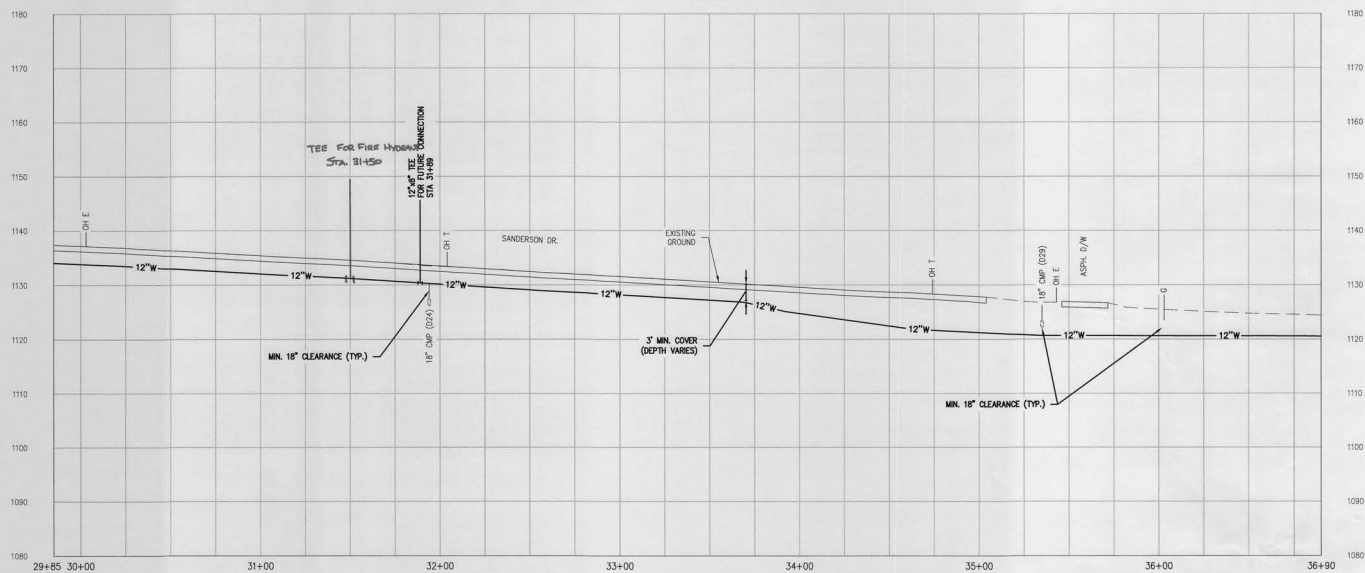

Revisions	Date

Drawn By: MLC	Designed By: RPK	Checked By: RPK	Date: 03/20/23
Drawn: MAR 20, 2023			

Matern & Craig
ENGINEERS/ARCHITECTS
201 WEST STREET, S.W.
ROANOKE, VA 24004
TEL: (540) 945-5442
FAX: (540) 945-5881



**SANDERSON DRIVE WATERLINE
PLAN & PROFILE - 12" WATERLINE**
BOTETOURT COUNTY, VIRGINIA

Vertical Scale: 1"=10'	Horizontal Scale: 1"=30'	Commission Number: 4230B	Sheet No.: 8
---------------------------	-----------------------------	-----------------------------	------------------------