



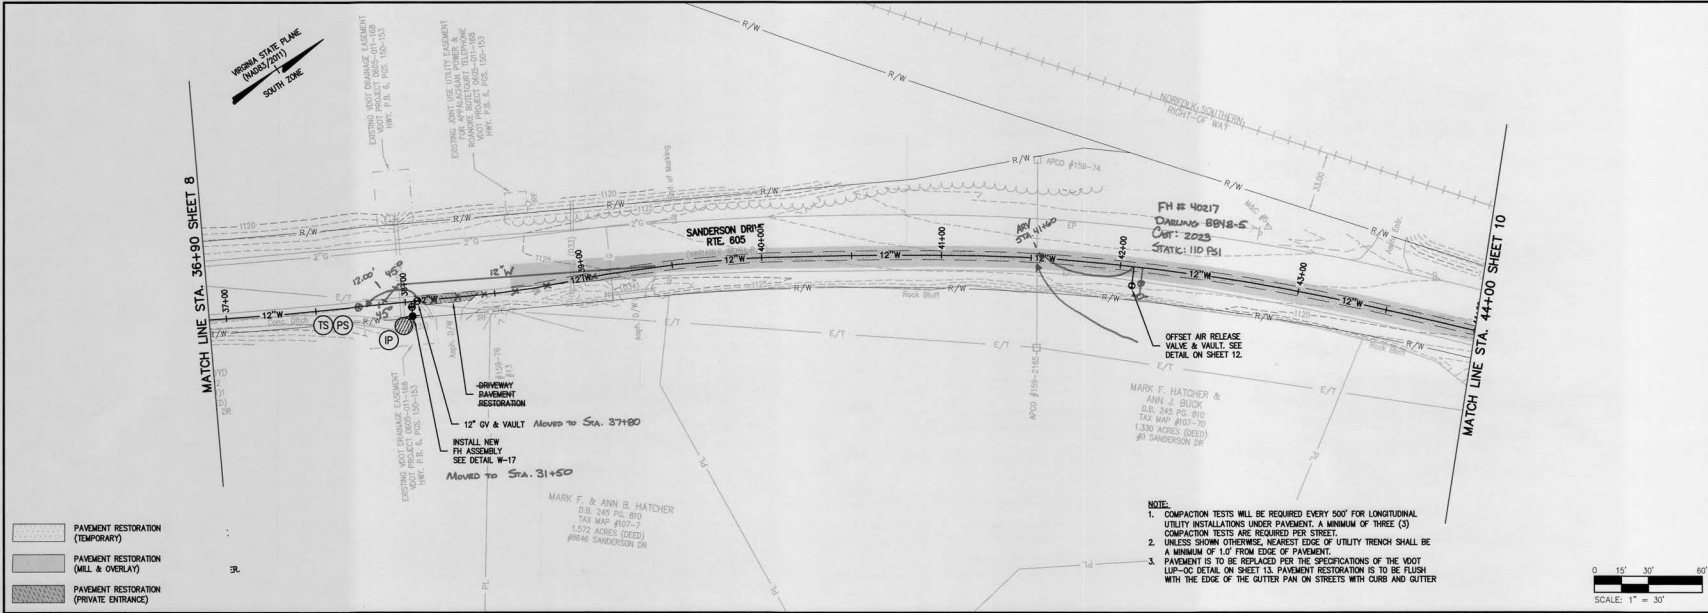

SANDERSON WATERLINE PROFILE

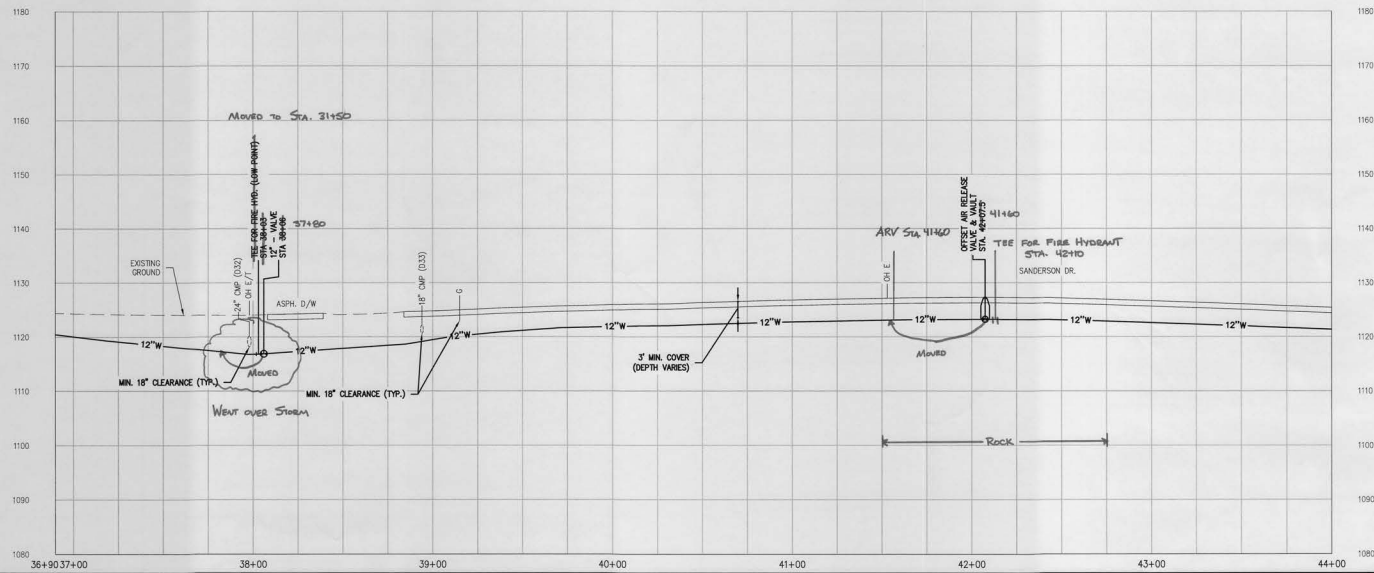

STATE OF VIRGINIA
RYAN P. O'NEAL
GOVERNOR
JAN 15, 2021

Issue Date: **MAR. 30, 2023**

Drawn By: M.C.

Designed By: RPK

Checked By: RPK

Date: 03/29/23

Matern & Craig
ENGINEERS/SURVEYORS
701 FIRST STREET, S.W.
ROANOKE, VIRGINIA 24012
(540) 545-5512
FAX (540) 545-7891

SANDERSON DRIVE WATERLINE

PLAN & PROFILE - 12" WATERLINE

BOYD/COURT COUNTY, VIRGINIA

Vertical Scale:
1"=10'

Horizontal Scale:
1"=30'

Commission Number:
4230B

Sheet No.:
9