
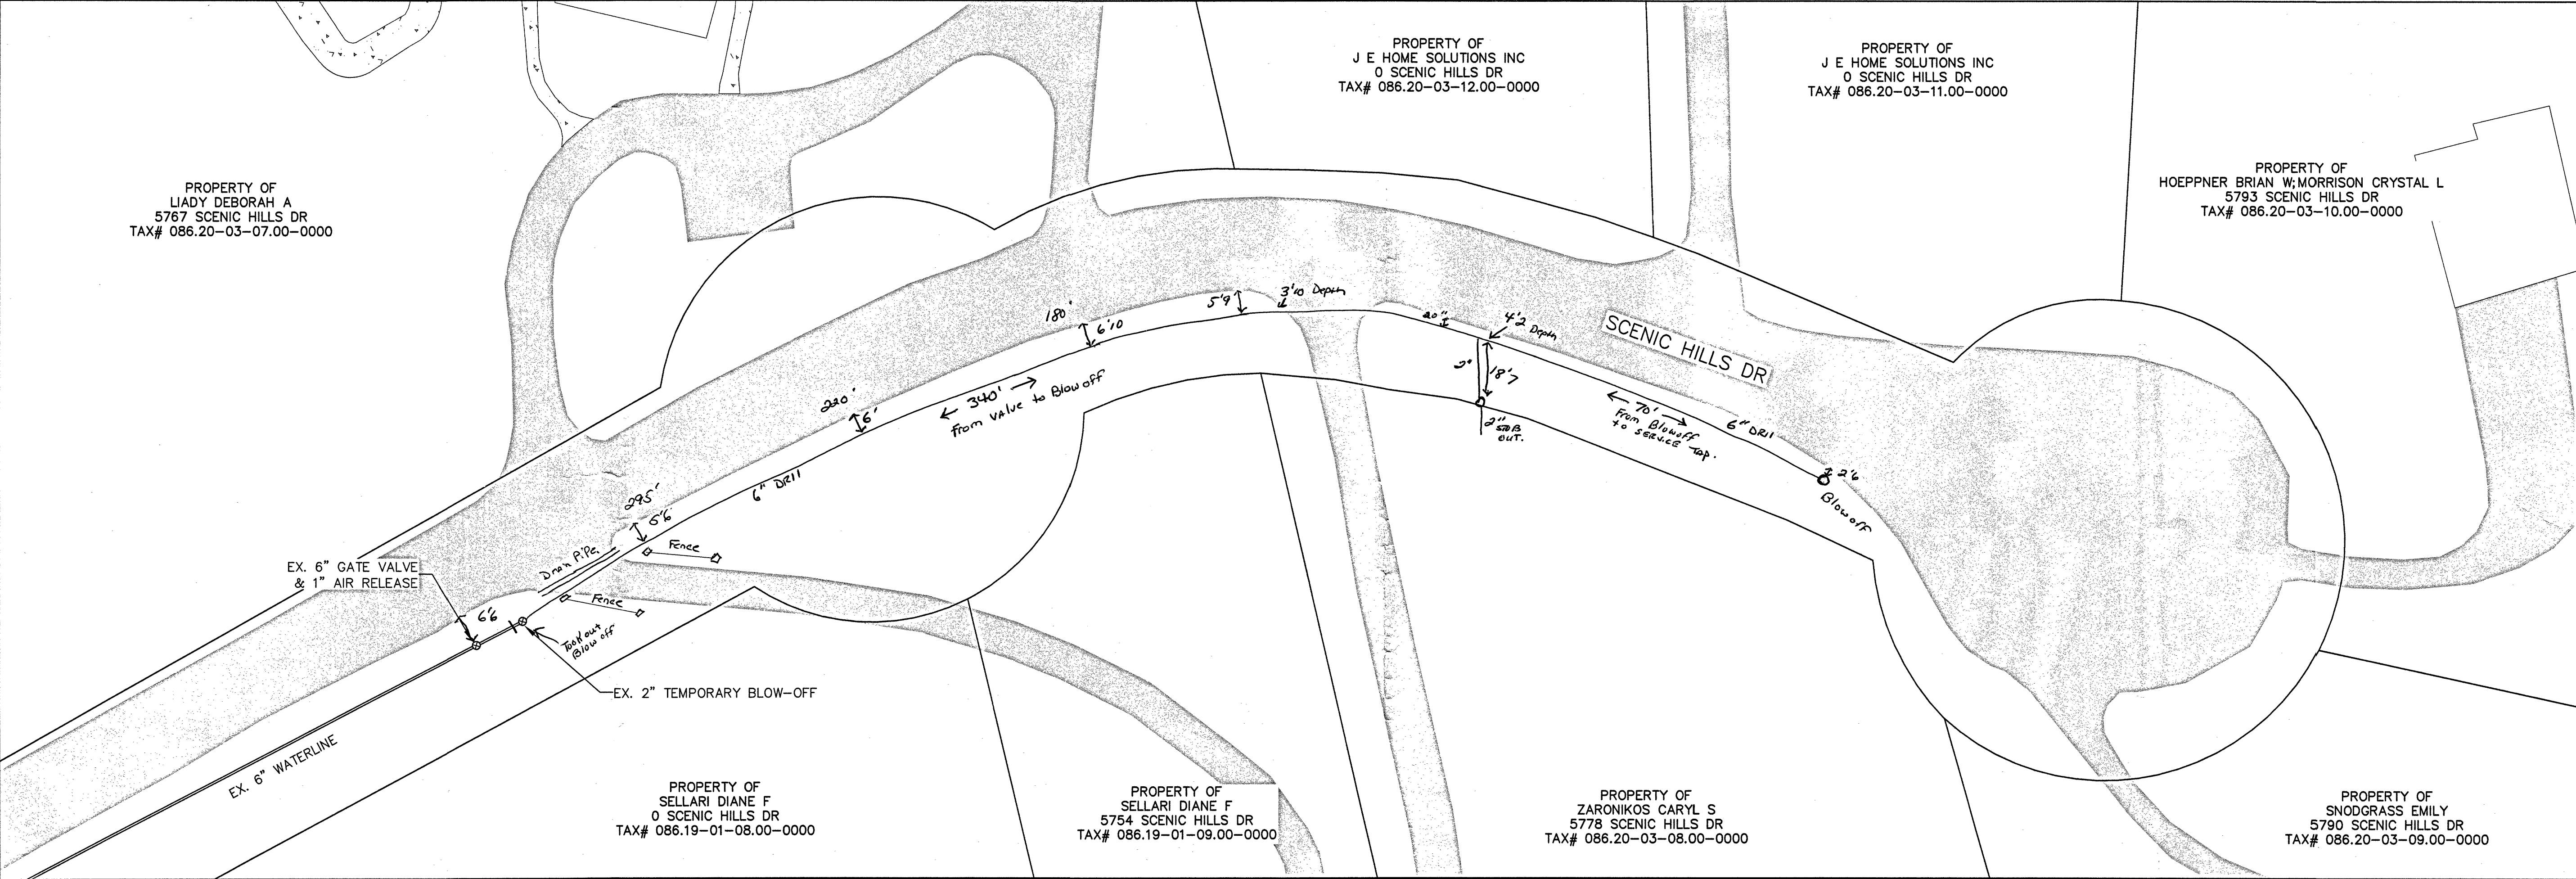


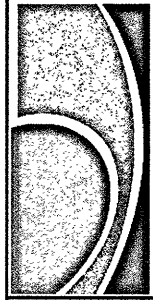

WESTERN VIRGINIA

WATER AUTHORITY

ENGINEERING SERVICES
601 S JEFFERSON ST, SUITE 300
ROANOKE, VA 24011
540-853-5700


SCENIC HILLS DRIVE
WATERLINE EXTENSION

PLAN

Project Name	
Install Contractor	
Install Date	
Water Main(s)	
Manufacturer	
Diameter	
Pipe Class	
Material	
Comments	
Water Service(s)	
Manufacturer	
Diameter	
Pipe Class	
Material	
Comments	

Water Valve(s) 1	
Manufacturer	
Valve Type	
Diameter	
Direction to Open / Turns to Close	
Comments	
Water Valve (s) 2	
Manufacturer	
Valve Type	
Diameter	
Direction to Close / Turns to Close	
Comments	
Hydrant(s)	
Authority ID #	
Manufacturer	
Model	
Cast Date	
Static Pressure	
Comments	

As-built
April, 2017

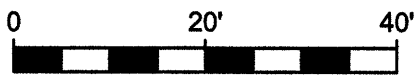

By					
Date					
Description					
Rev					
Designed:					
Drawn: DRJ					
Checked:					
Approved:					
Date: APR 2017					
Project:					
1					
Sheet 1 of 1					