
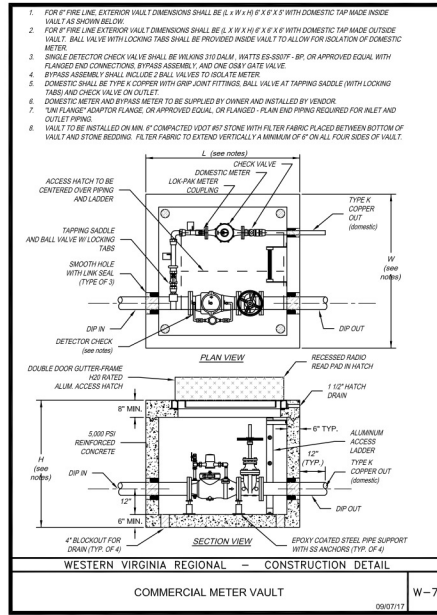
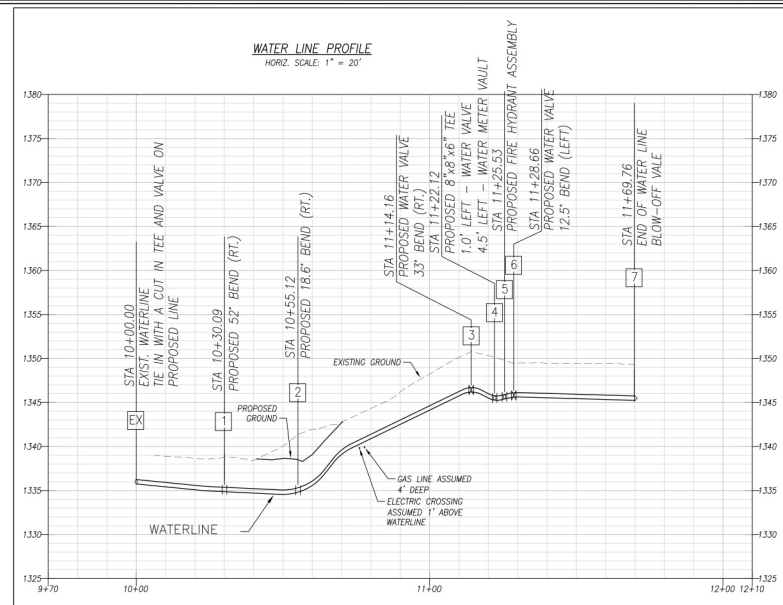


This document, together with the proposals and designs presented herein, is an instrument of service, in that it is prepared by the Engineer for the specific purpose and project for which it was prepared. It is intended only for the specific purpose and project for which it was prepared. It is not to be used for any other purpose without the written consent of the Engineer. It is the responsibility of the Engineer to ensure that the information contained herein is accurate and complete. It is the responsibility of the client to ensure that the information is used for the purpose for which it was prepared. It is the responsibility of the client to ensure that the information is used for the purpose for which it was prepared.

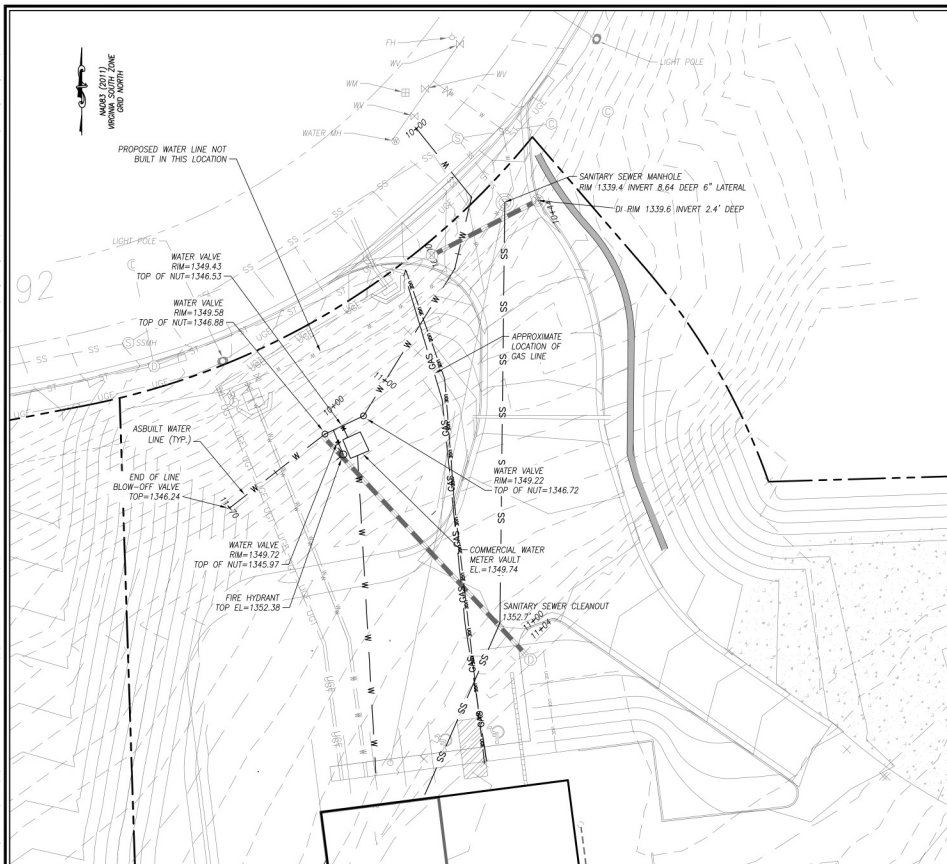

94 GREENFIELD STREET
DALEVILLE, VIRGINIA 24093
540.473.1253

No.	Description	Date

SECURE STORE
DALEVILLE, VIRGINIA
WATER LINE AS-BUILT
PLAN AND PROFILE



0 20 40
GRAPHIC SCALE
PROJECT: 18028
1