


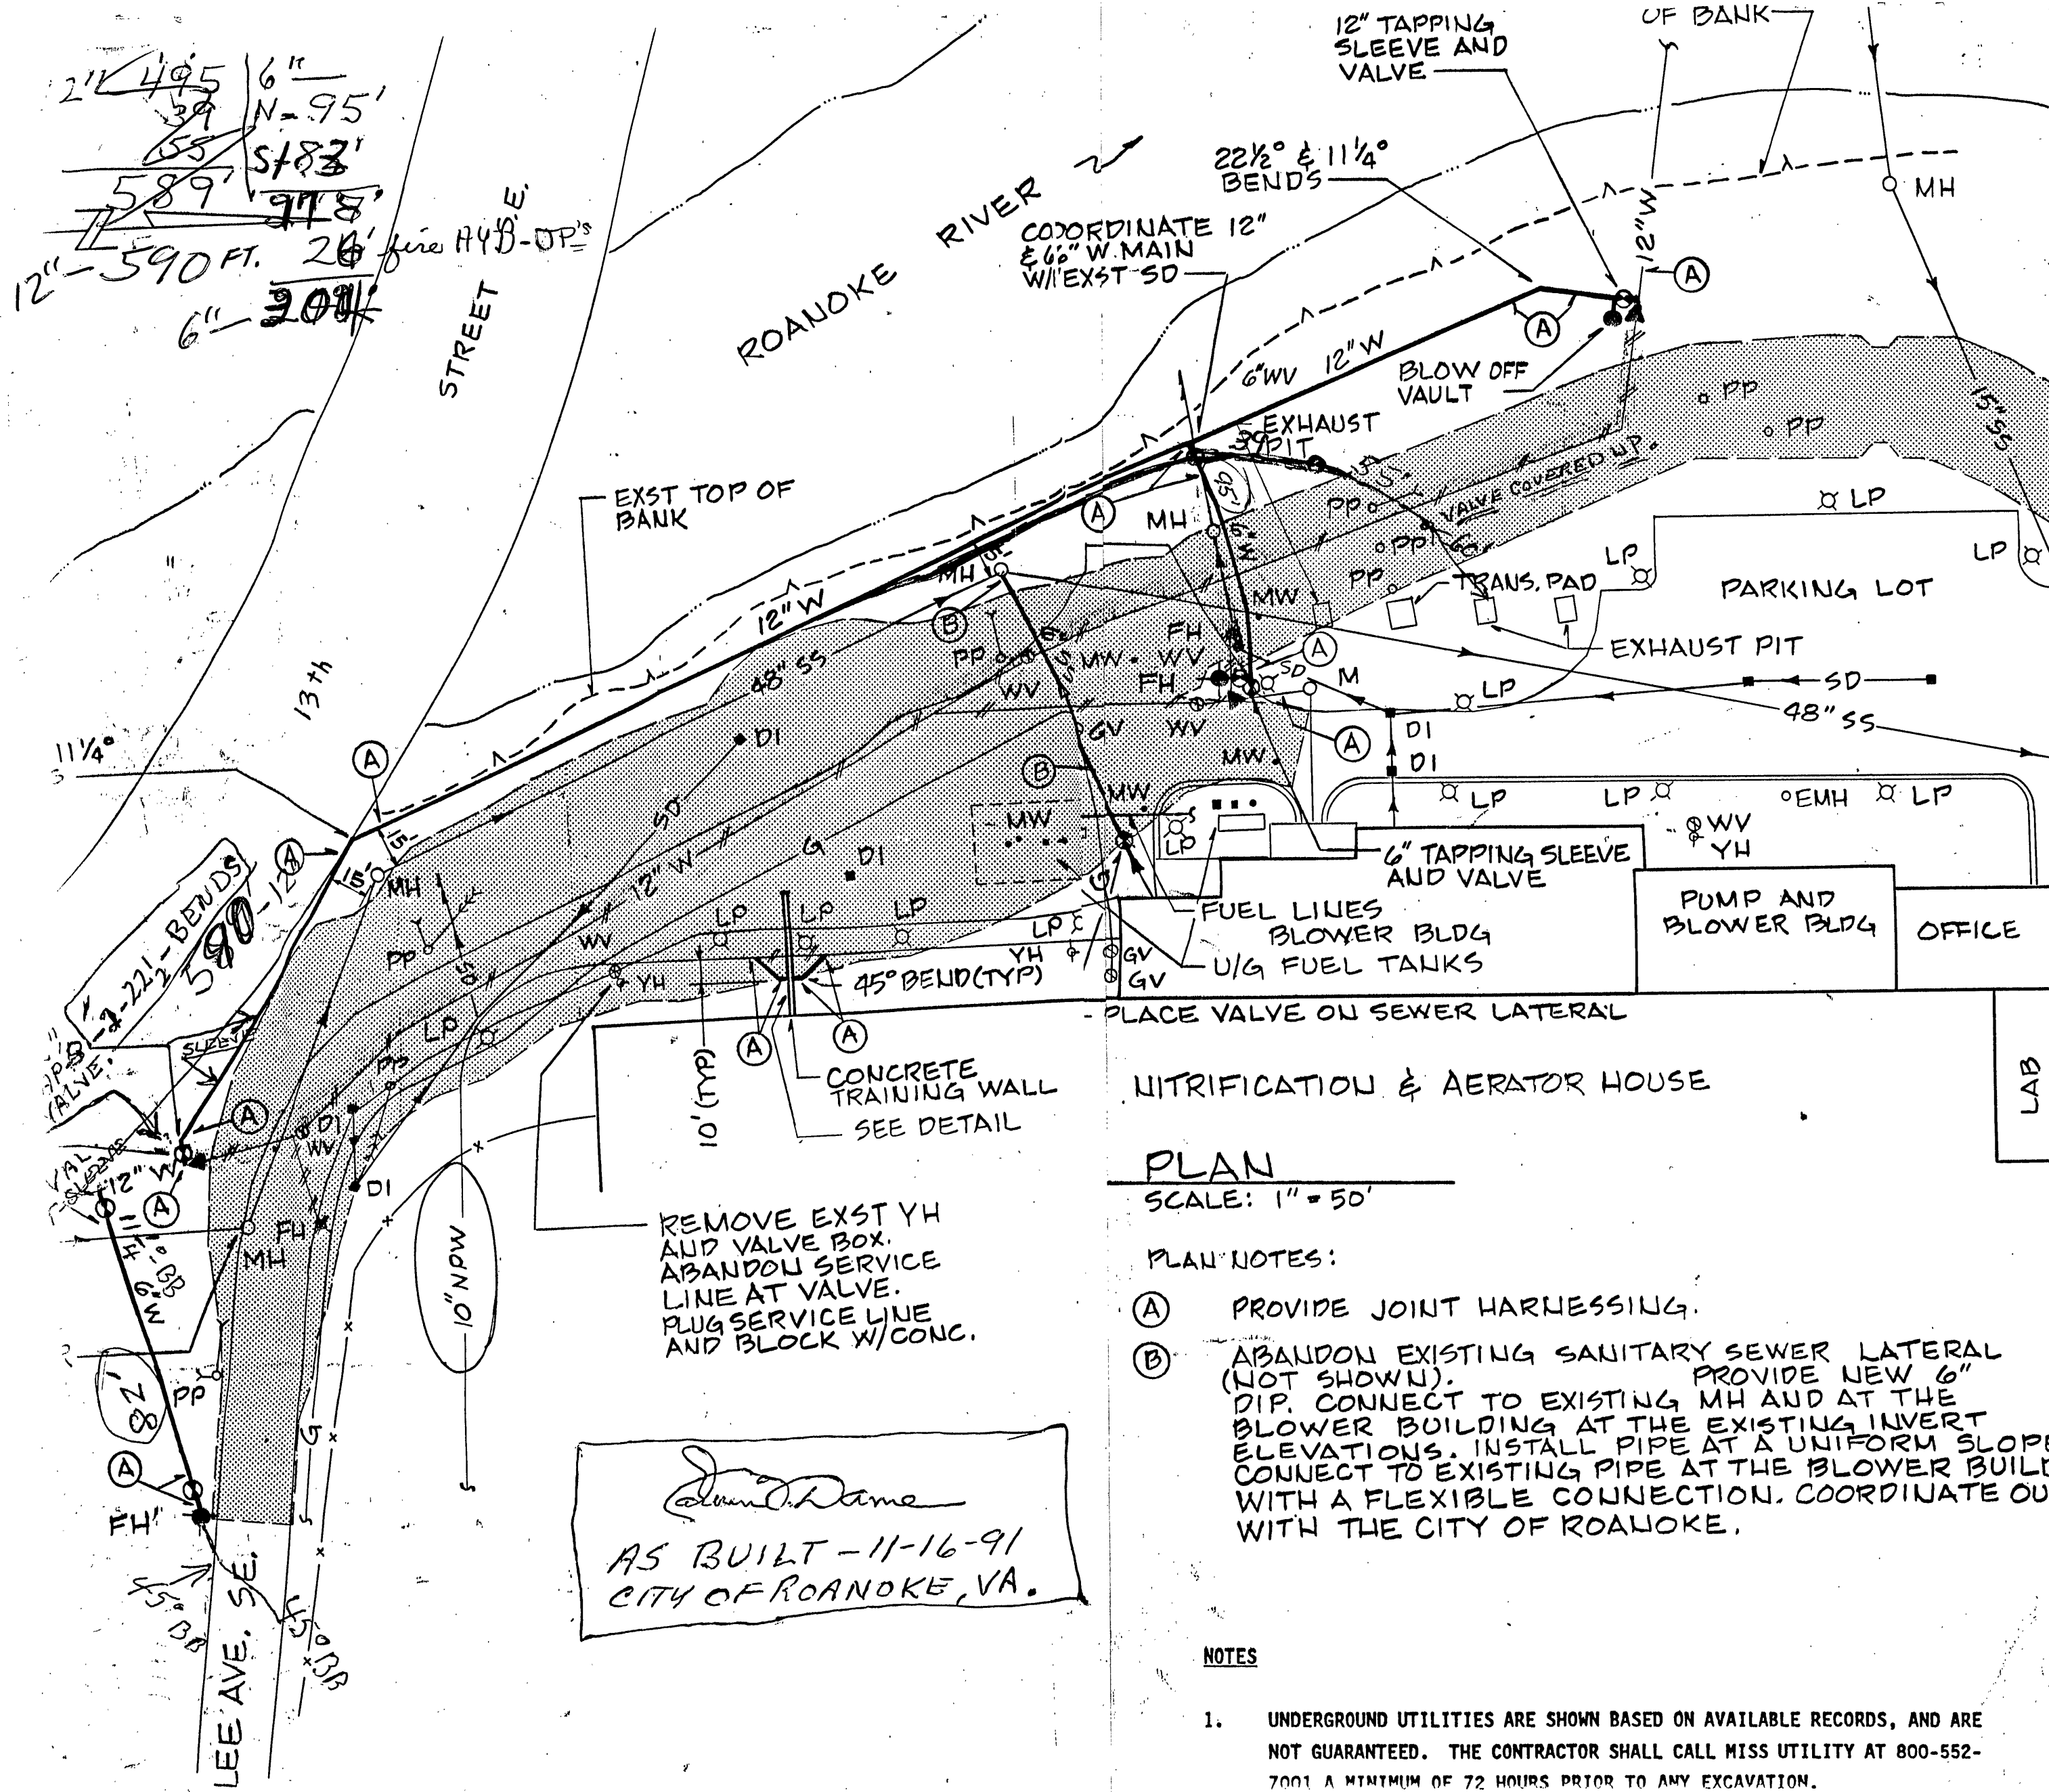

NITRIFICATION & AERATOR HOUSE

PLAN

SCALE: 1" = 50'

PLAN NOTES:

- (A) PROVIDE JOINT HARNESSING.
- (B) ABANDON EXISTING SANITARY SEWER LATERAL (NOT SHOWN). PROVIDE NEW 6" DIP. CONNECT TO EXISTING MH AND AT THE BLOWER BUILDING AT THE EXISTING INVERT ELEVATIONS. INSTALL PIPE AT A UNIFORM SLOPE. CONNECT TO EXISTING PIPE AT THE BLOWER BUILDING WITH A FLEXIBLE CONNECTION. COORDINATE WITH THE CITY OF ROANOKE.

NOTES

1. UNDERGROUND UTILITIES ARE SHOWN BASED ON AVAILABLE RECORDS, AND ARE NOT GUARANTEED. THE CONTRACTOR SHALL CALL MISS UTILITY AT 800-552-7001 A MINIMUM OF 72 HOURS PRIOR TO ANY EXCAVATION.

James D. Dame
 AS BUILT - 11-16-91
 CITY OF ROANOKE, VA.