


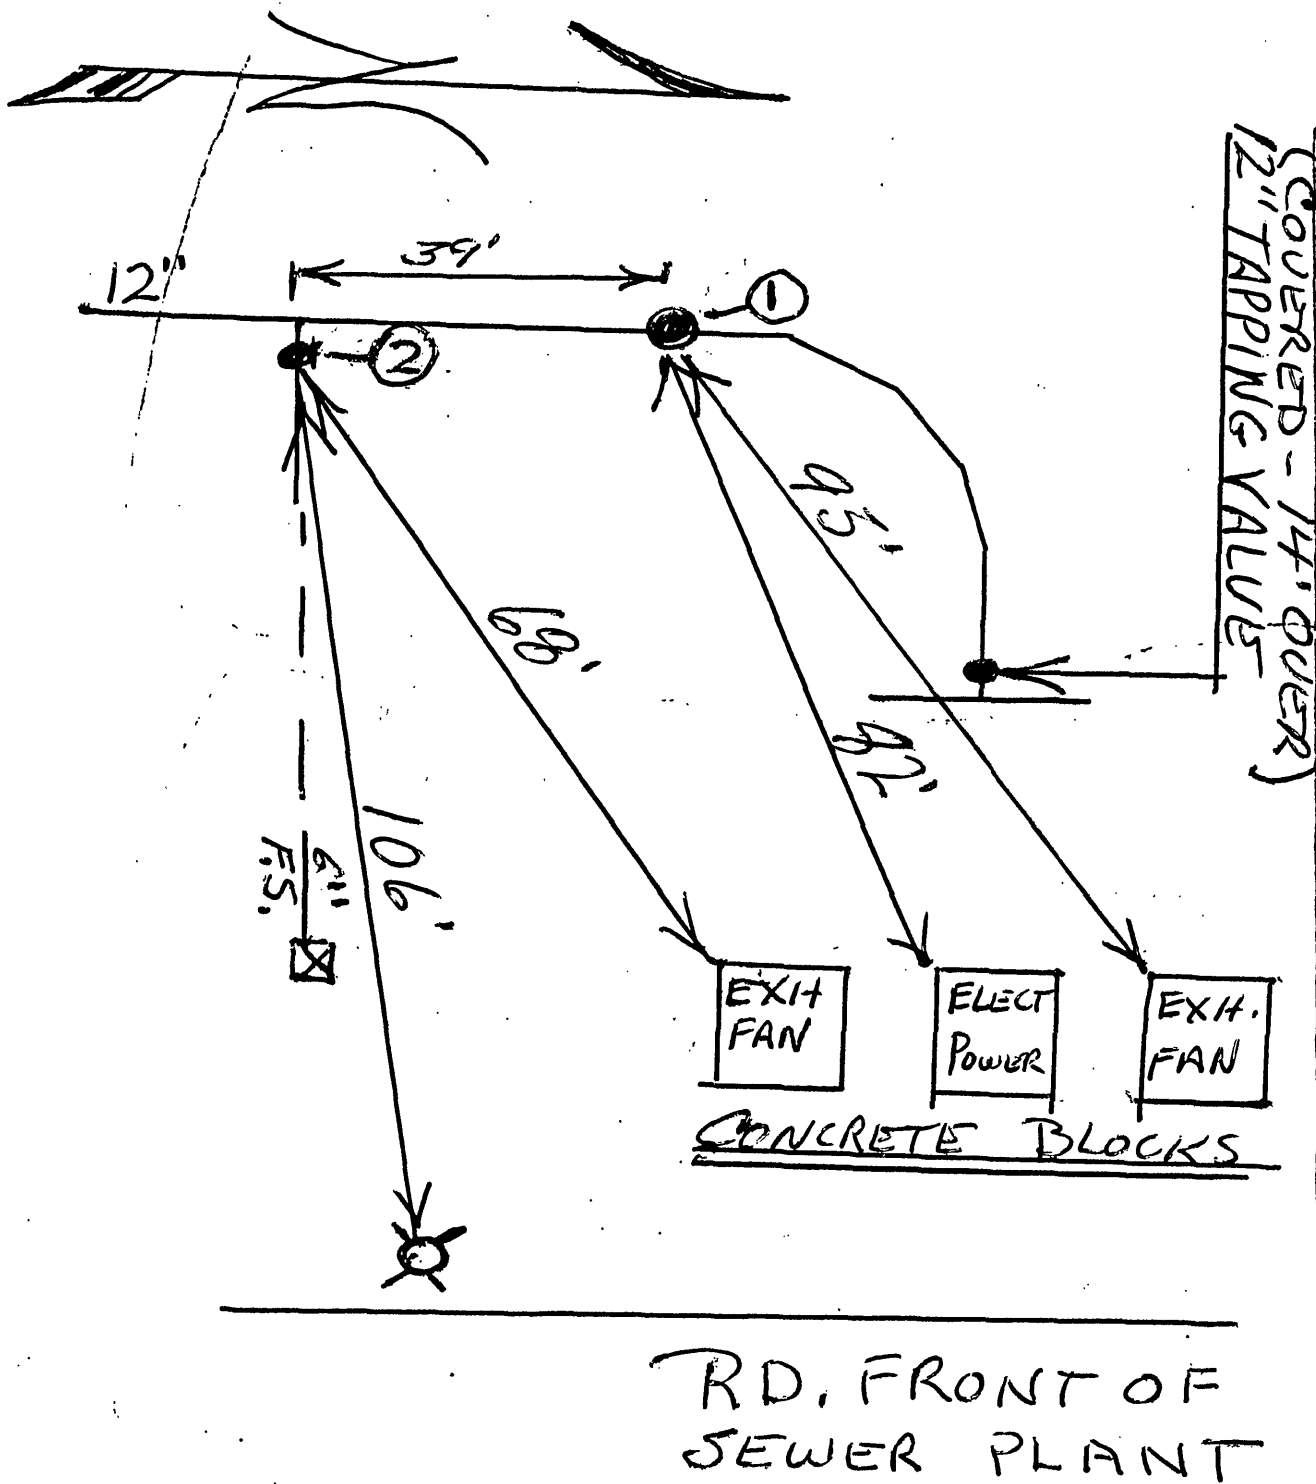

(COVERED - 14' OVER)
12" TAPPING VALVE

DATE	NO.	SIZE	MAKE	OPEN	TURNS
11-91	1	12	M	R	-
11-91	2	6	M	R	-

P. L. Measurements		
No.	Distance	Direction

CITY OF ROANOKE - WATER DEPT.

VALVE DIAGRAM

SEWER PLANT (SE)

FRONT OF PLANT

Sec. Map

Date Page No.