




PROVIDE (3) THREE JOINTS OF
PIPE & BLOW OFF PAST CROSSING.

PROVIDE (3) THREE 12" G. V.

PROVIDE (1) ONE FIRE HYDRANT STUB.

IN SHADWELL, LAY MAIN (5')
FIVE FEET OFF PAVEMENT.

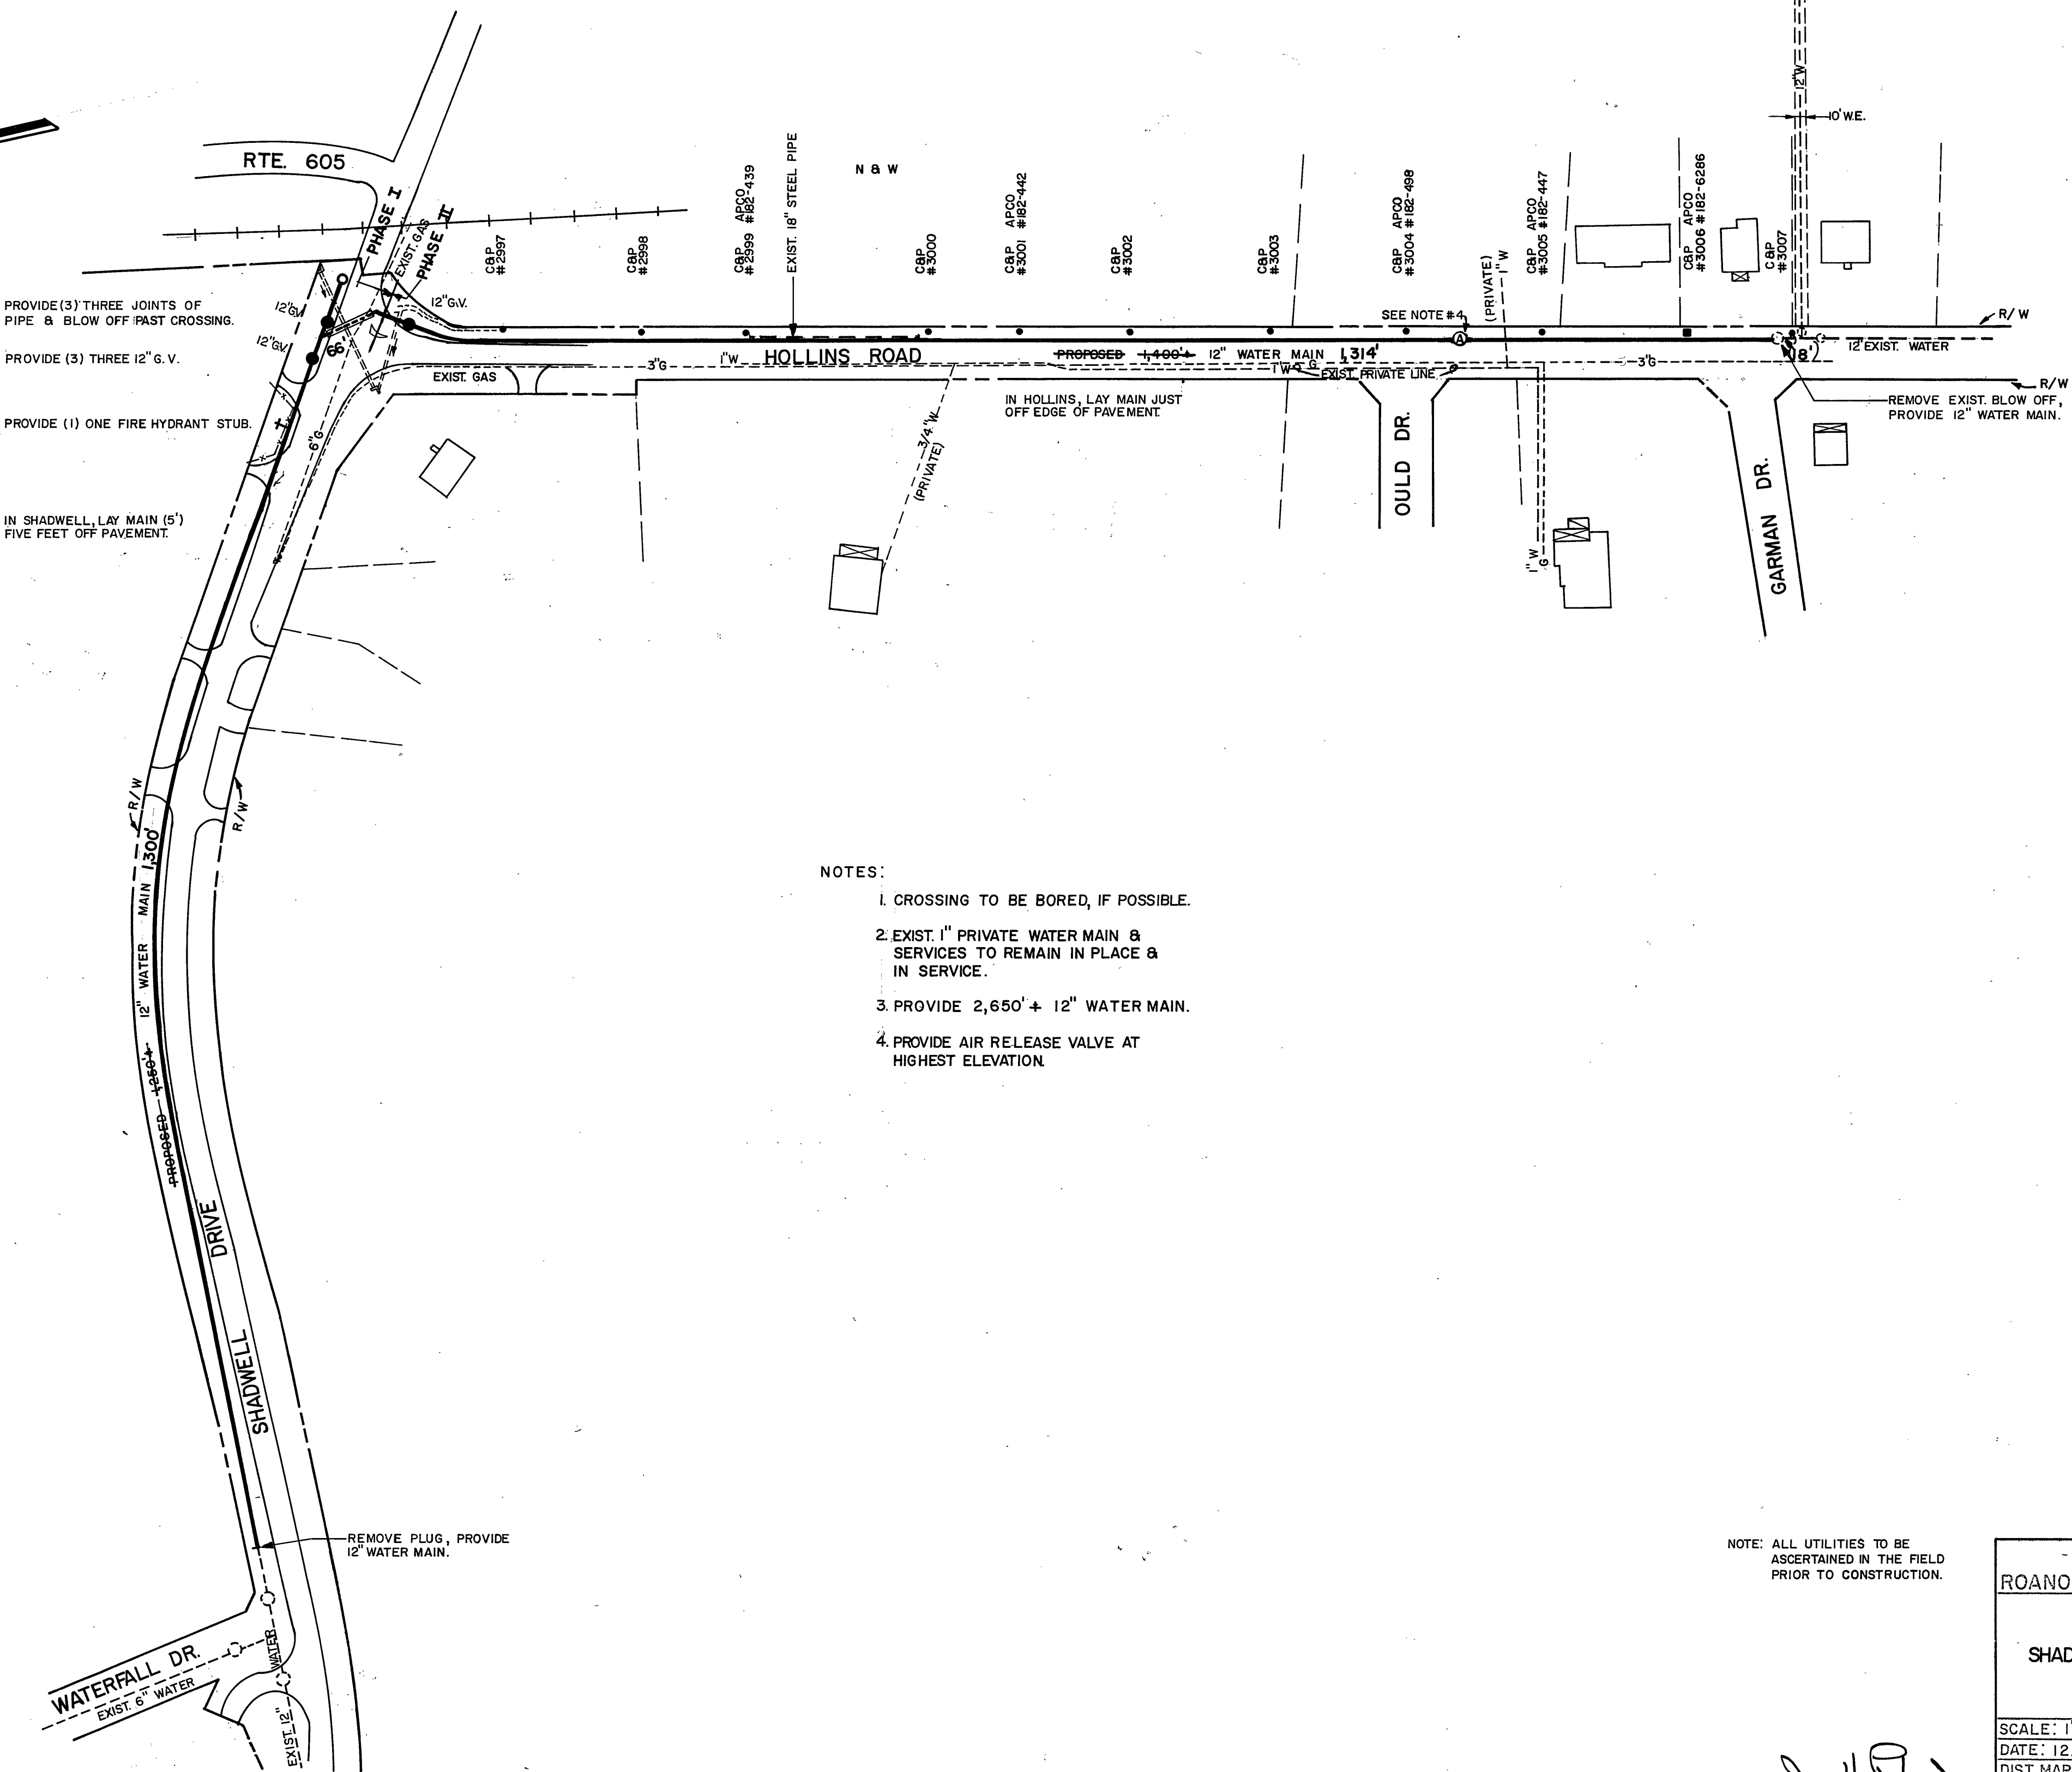

NOTES:

1. CROSSING TO BE BORED, IF POSSIBLE.
2. EXIST. 1" PRIVATE WATER MAIN & SERVICES TO REMAIN IN PLACE & IN SERVICE.
3. PROVIDE 2,650' + 12" WATER MAIN.
4. PROVIDE AIR RELEASE VALVE AT HIGHEST ELEVATION.

NOTE: ALL UTILITIES TO BE
ASCERTAINED IN THE FIELD
PRIOR TO CONSTRUCTION.

DATE STARTED	6-3-87			
DATE COMP.	8-14-87			
FEET MAIN	SIZE	VALVE	VAULT	BOX
1,366	12"	2	2	
1,314	12"	1	1	
BLOW OFF	2"	1		1
F. H. COMP.				
F. H. STUB ONLY	6"	1	1	
SERV. INS. BY: C.O. DAME, A. HALE-CITY				
NO. 3/4" SERV. INS.				
CITY OR CO. COUNTY				
DEPT. INSP. U.L.S.				

WATER DEPARTMENT	
ROANOKE	VIRGINIA
SHADWELL DR. & HOLLINS RD.	
SCALE: 1"=100'	12/30/86
DATE: 12/29/86	DIRECTOR UTILITIES & OPERATIONS DATE
DIST. MAP. COUNTY 75	12/29/86
PLAN NO.: 66-18	DIRECTOR OF PUBLIC WORKS DATE

MANAGER UTILITY LINE SERVICES