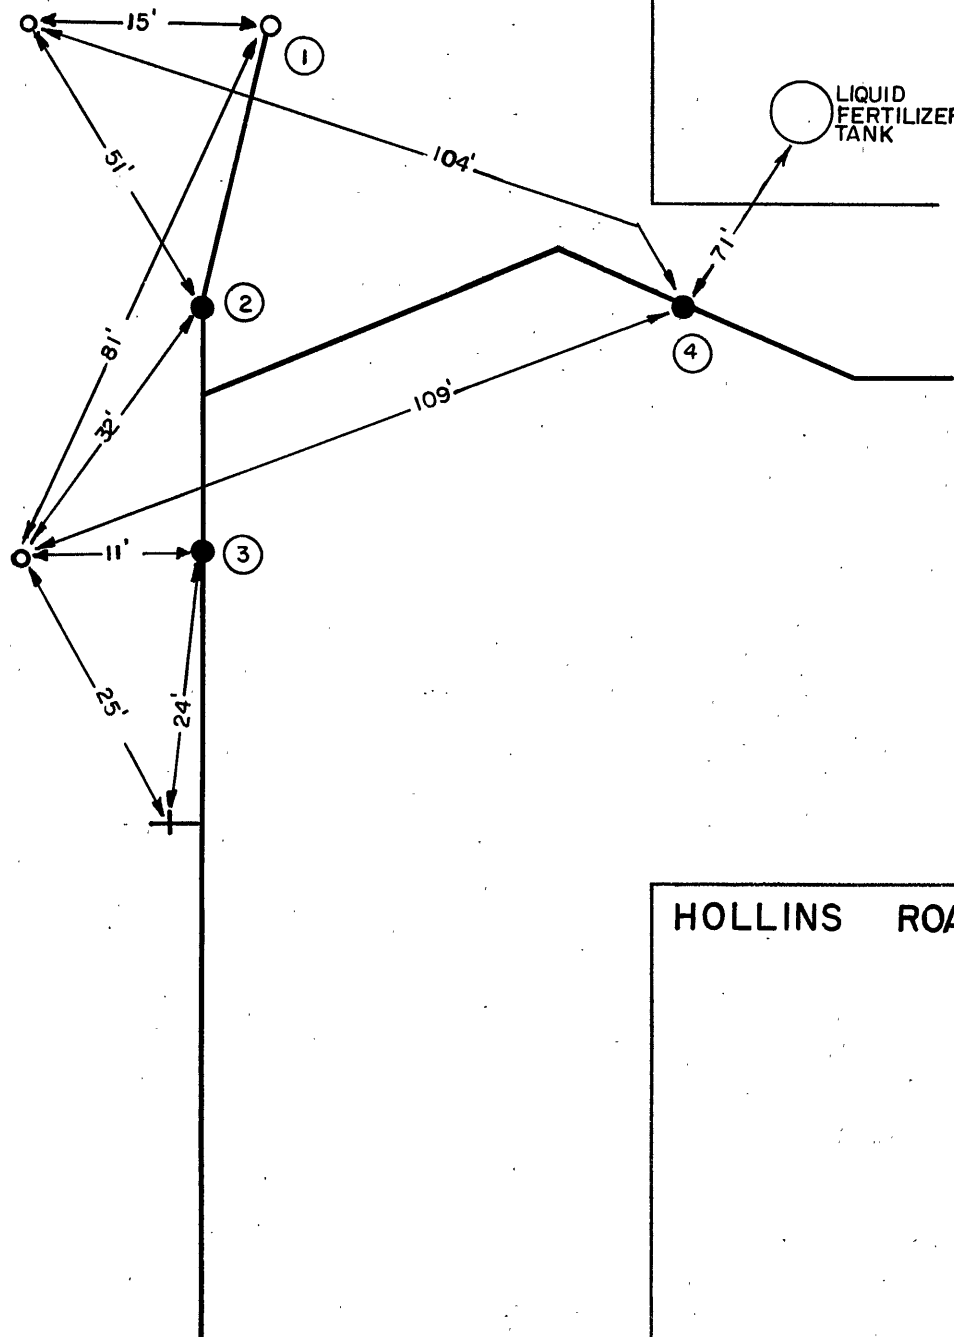


SHADWELL

APCO POLE
182-436

F.H. STUB

[illegible]

HOLLINS ROAD

CITY OF ROANOKE—WATER DEPT VALVE DIAGRAM

HOLLINS ROAD 8

SHADWELL DRIVE N.E.

SEC. MAP 74 COUNTY

DATE PAGE NO.