


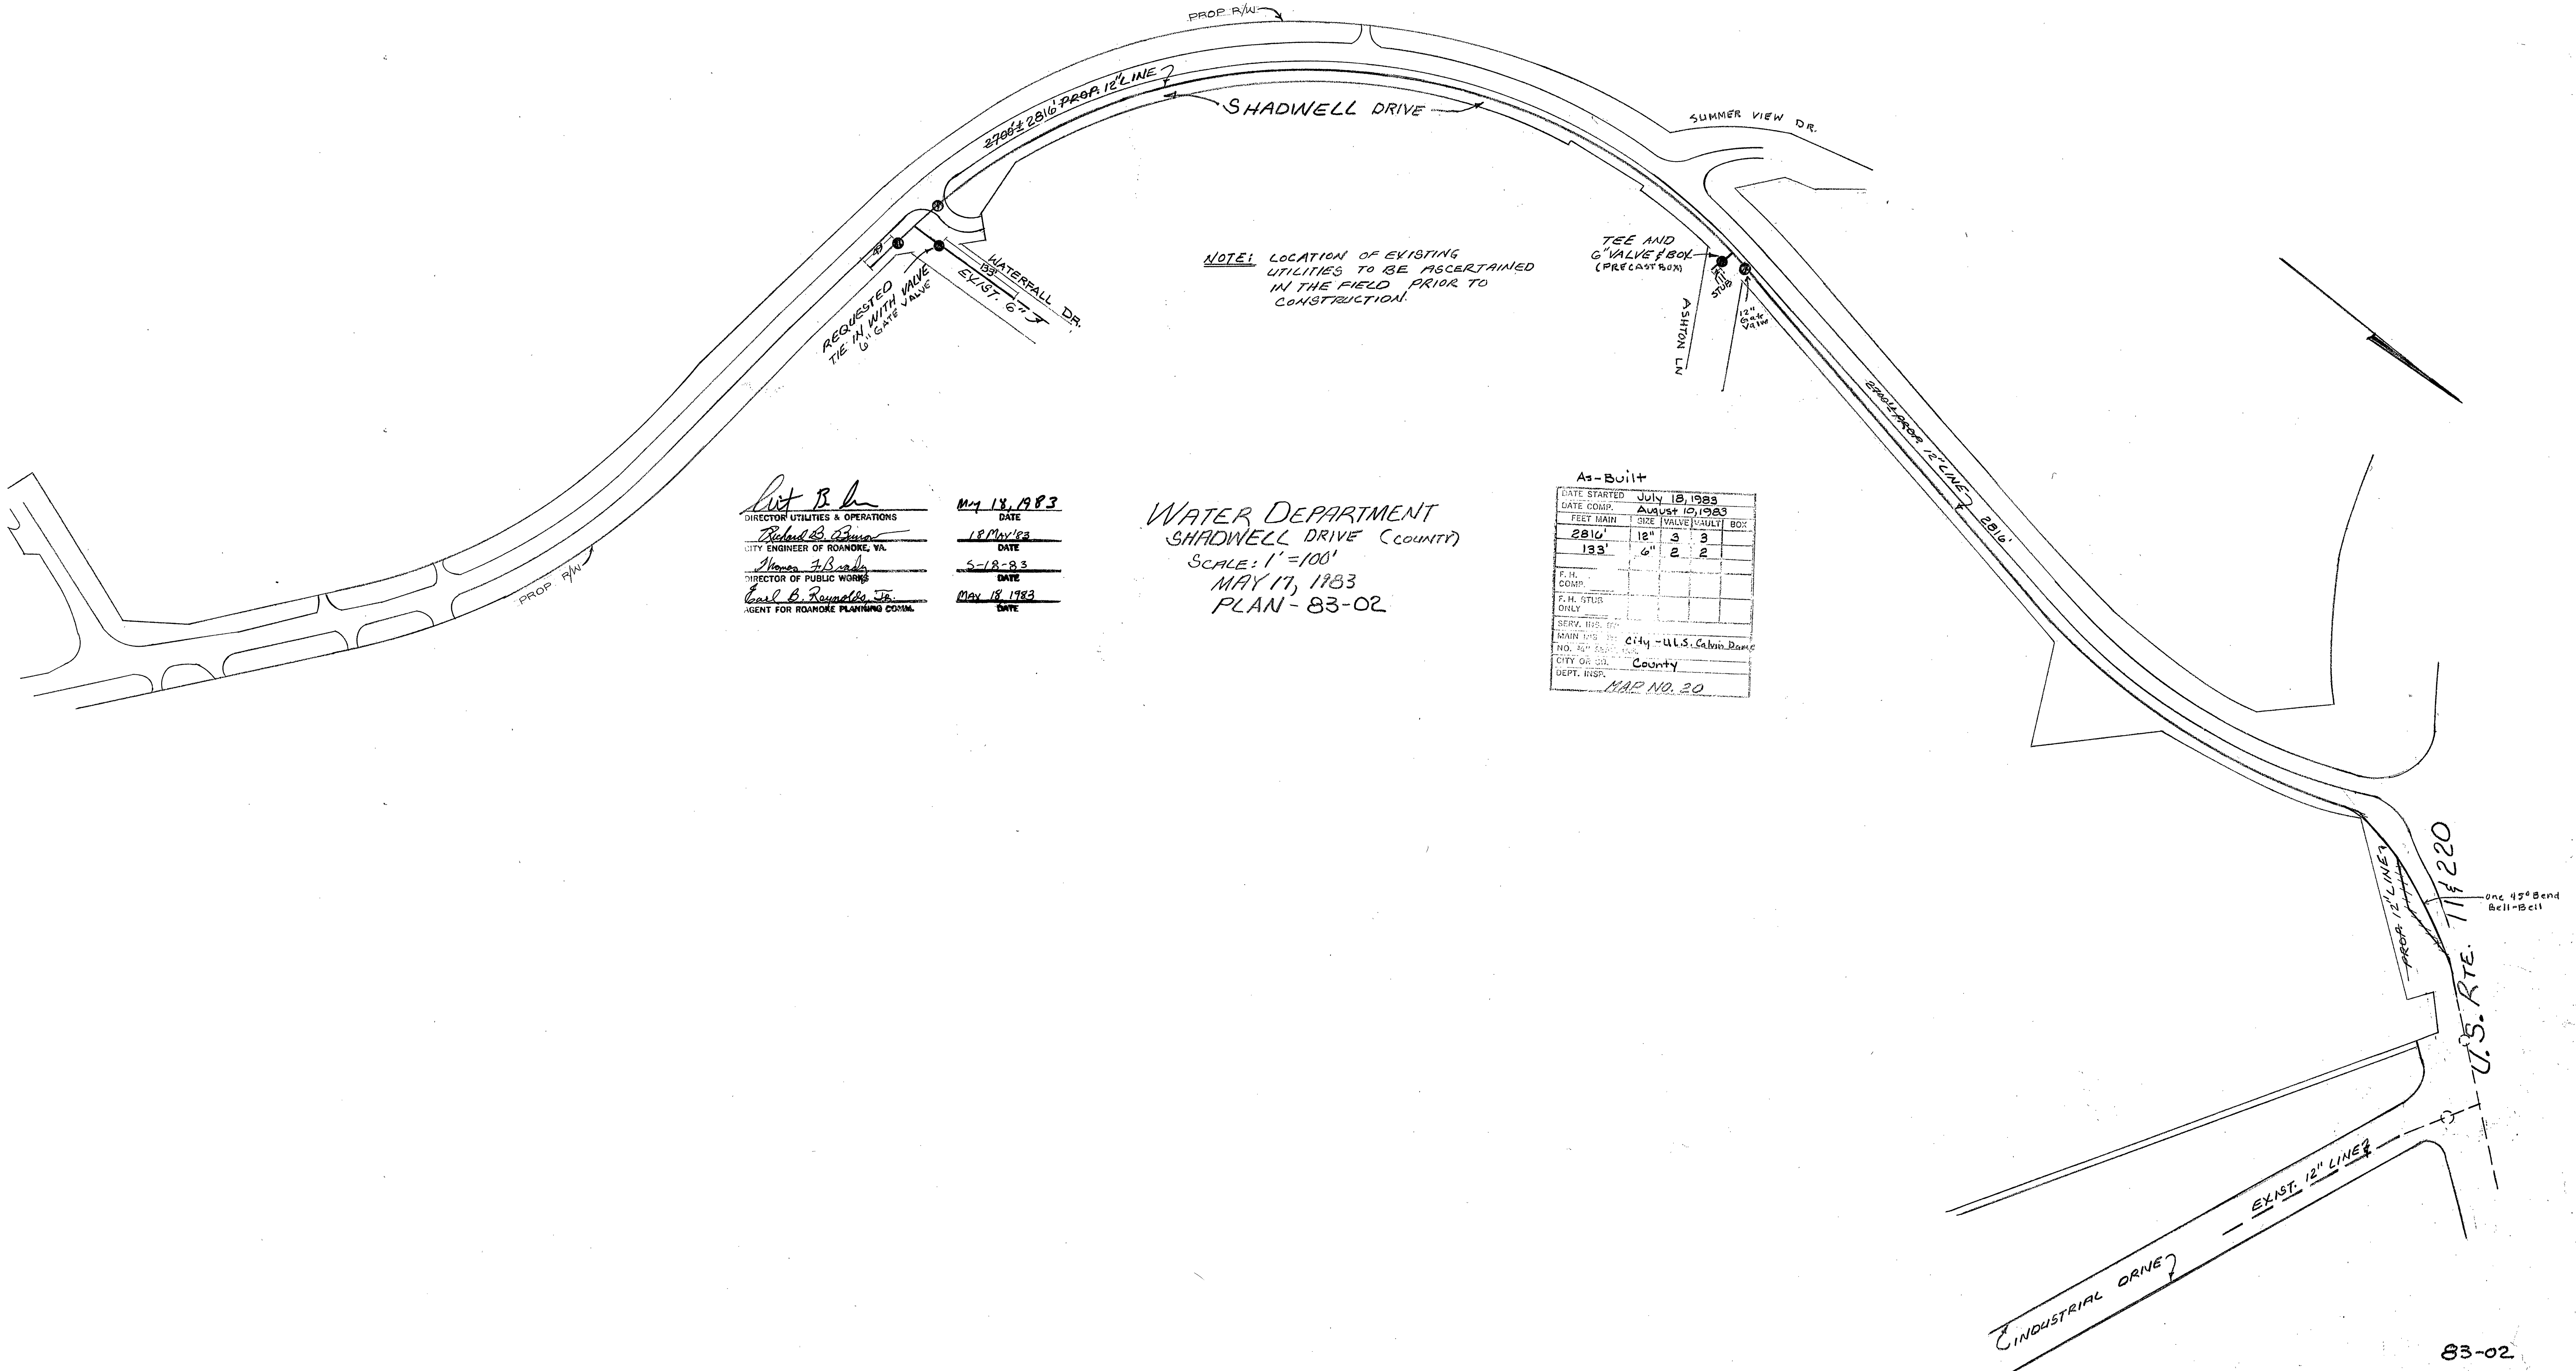

Richard B. Brum
 DIRECTOR UTILITIES & OPERATIONS
Richard B. Brum
 CITY ENGINEER OF ROANOKE, VA.
Thomas F. Brady
 DIRECTOR OF PUBLIC WORKS
Carl B. Reynolds, Jr.
 AGENT FOR ROANOKE PLANNING COMM.

MAY 18, 1983
 DATE
 18 MAY '83
 DATE
 5-18-83
 DATE
 MAY 18, 1983
 DATE

WATER DEPARTMENT
 SHADWELL DRIVE (COUNTY)
 SCALE: 1" = 100'
 MAY 17, 1983
 PLAN-83-02

As-Built

DATE STARTED	JULY 18, 1983
DATE COMP.	AUGUST 10, 1983
FEET MAIN	2810'
SIZE	12"
VALVE	3
MANHOLE	3
BOX	2
F.H. COMP.	
F.H. STUB ONLY	
SERV. HDS. BY	
MAIN LINES BY	CITY - U.S. Calvin Davis
NO. 40' C&G	
CITY OR CO.	County
DEPT. INSP.	MAP NO. 20