


- NOTES:
1. SURVEY PROVIDED BY DALE, BYER, BENNETT & ASSOCIATES DATED 9/18/09.
 2. CONTRACTOR SHALL FIELD VERIFY SIZE AND INVERT OF ALL LATERALS AND MAINS AND PROVIDE INFORMATION AS PART OF THE SHOP DRAWING APPROVAL PROCESS.
 3. CONTRACTOR SHALL FIELD VERIFY THE REQUIREMENTS OF THE MAINTENANCE OF TRAFFIC AND CONTROL PLAN AS APPROVED BY THE CITY OF ROANOKE AND IN ACCORDANCE WITH ALL VDOT STANDARDS.
 4. UPON NORTHBOUND LANE CLOSURE, THE CONTRACTOR SHALL POT-HOLE TO DEPTHS SIX INCHES BELOW THE PROPOSED SEWER AT THE CULVERT AND AT ONE LOCATION UNDER EACH BRIDGE TO INSURE THAT THE PROPOSED DEPTH AND HORIZONTAL ALIGNMENT OF THE SEWER RESULT IN NO CONFLICTS WITH THE CULVERT AND BRIDGE FLOOR SLABS. THE CONTRACTOR SHALL PROVIDE THIS INFORMATION WITH THE PERMITS.
 5. FEET) SHALL BE ACCOMMODATED AT NO ADDITIONAL COST TO THE OWNER. THE OWNER SHALL REVISE THE DRAWINGS AS REQUIRED AND ISSUE AS A FIELD ORDER TO THE CONTRACTOR.
 6. AFTER POT-HOLING, THE CONTRACTOR SHALL RUN A BASELINE SURVEY AT EACH PROPOSED MANHOLE LOCATION IN PAVED AREAS TO INSURE THAT FINAL APPROVED MANHOLE HEIGHTS RESULT IN MANHOLE COVERS FLUSH WITH THE PAVEMENT.
 7. APPROVED ROAD PERMIT AND ACCE. NATIONWIDE PERMITS. SEE SPECIAL CONDITIONS 01060 IN SPECIFICATIONS FOR PROPOSED PHASING OF WORK AND ADDITIONAL CONSTRUCTION REQUIREMENTS.
 8. ALL WORK SHALL BE IN ACCORDANCE WITH VIRGINIA E&S STANDARDS.
 9. SADDLE MANHOLES ARE NOT ALLOWED.

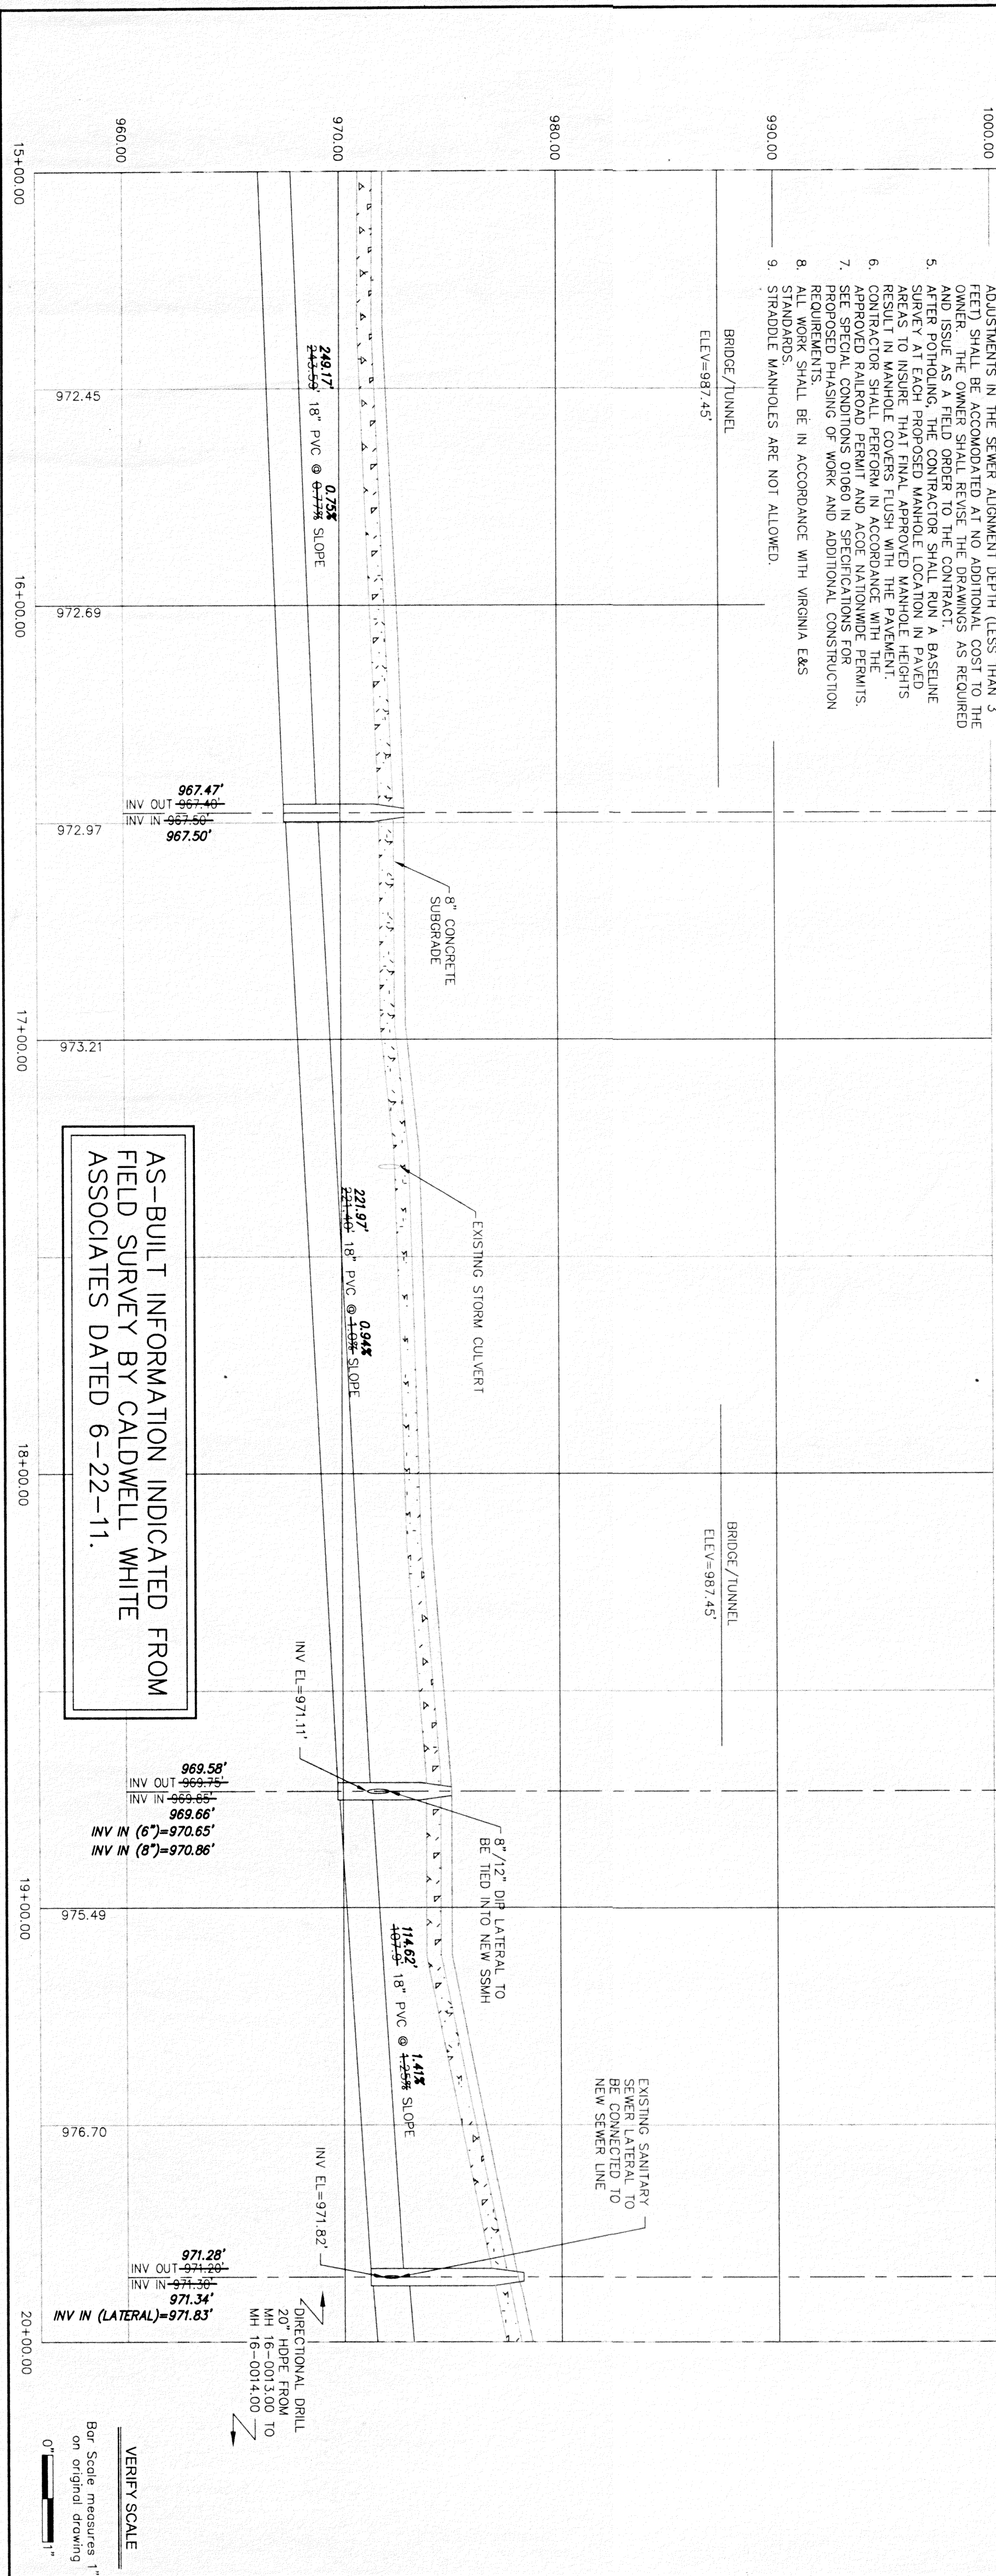


AS-BUILT INFORMATION INDICATED FROM
FIELD SURVEY BY CALDWELL WHITE
ASSOCIATES DATED 6-22-11.

WESTERN VIRGINIA WATER AUTHORITY SHAFFER'S CROSSING SEWER REPLACEMENT			
PROPOSED PLAN AND PROFILE STATION 15+00.00 THRU 20+00.00			
Rev.	Description	Date	By
C	BID ISSUE	8/19/10	DBH
B	90% DESIGN REVIEW	5/12/10	DBH
A	50% DESIGN REVIEW	4/14/10	DBH
Designed: JCM			
Drawn: CDH			
Checked: DBH			
Date: MAY 2010			
Scale: AS SHOWN			
Job No. 12307.10			
Archived File Name:			

C102

VERIFY SCALE
Bar Scale measures 1" on original drawing



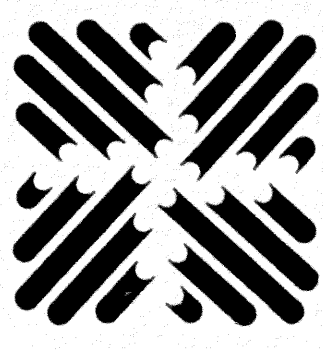

OLVER INCORPORATED
Consulting Engineers & Applied Scientists

1116 SOUTH MAIN STREET
BLACKSBURG, VIRGINIA 24060
(540) 552-5548