


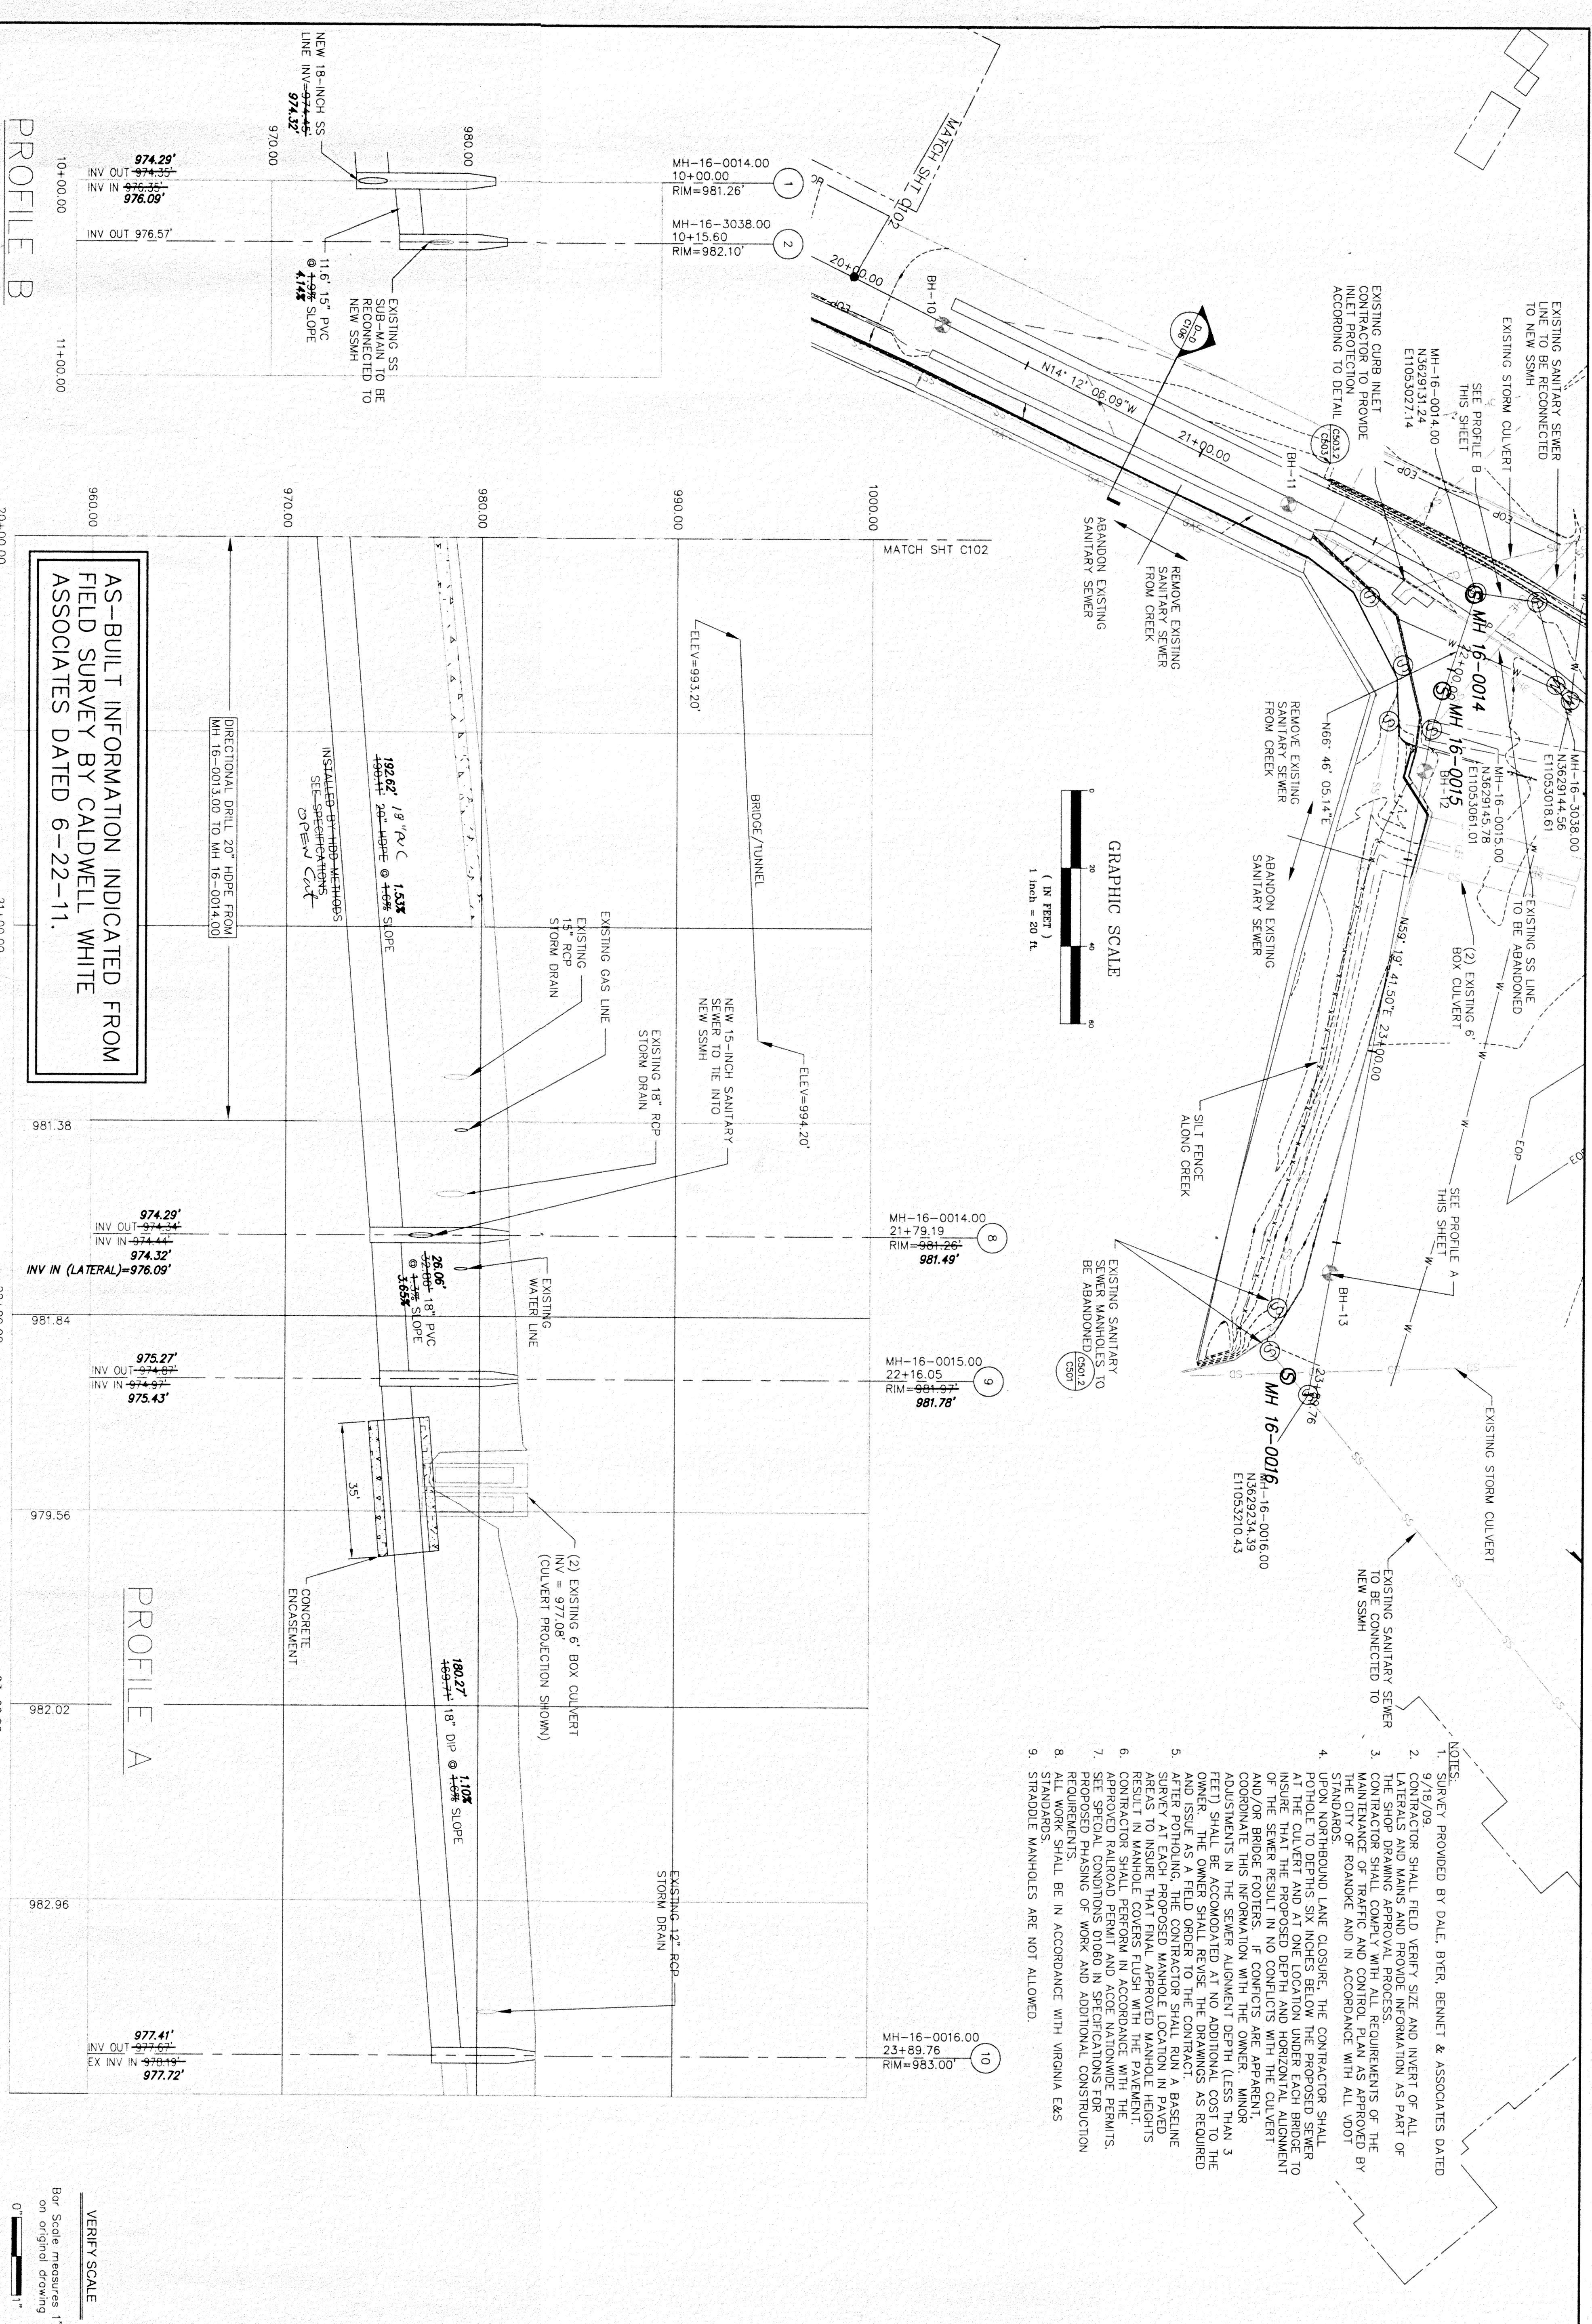

PROFILE B

AS-BUILT INFORMATION INDICATED FROM
FIELD SURVEY BY CALDWELL WHITE
ASSOCIATES DATED 6-22-11.


PROFILE A

VERIFY SCALE
Bar Scale measures 1" = 100'

Designed: JGM			
Drawn: CDH			
Checked: DBH			
Date: MAY 2010			
Scale: AS SHOWN			
Job No. 12307.10			
Archived File Name:			

WESTERN VIRGINIA WATER AUTHORITY
SHAFFER'S CROSSING SEWER REPLACEMENT

PROPOSED PLAN AND PROFILE
STATION 20+00.00 THRU 24+00.00

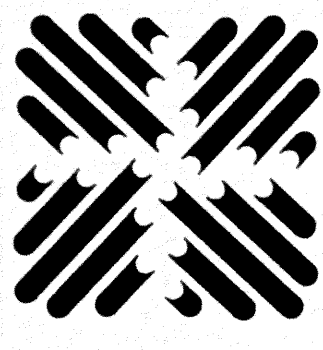

OLVER INCORPORATED
Consulting Engineers & Applied Scientists

1116 SOUTH MAIN STREET
BLACKSBURG, VIRGINIA 24060
(540) 552-5548

- NOTES:
1. SURVEY PROVIDED BY DALE, BIER, BENNETT & ASSOCIATES DATED 9/18/09.
 2. CONTRACTOR SHALL FIELD VERIFY SIZE AND INVERT OF ALL EXISTING SANITARY SEWERS AND PROVIDE INFORMATION AS PART OF THE SHOP DRAWING APPROVAL PROCESS.
 3. CONTRACTOR SHALL COMPLY WITH ALL REQUIREMENTS OF THE MAINTENANCE OF TRAFFIC AND CONTROL PLAN AS APPROVED BY THE CITY OF ROANOKE AND IN ACCORDANCE WITH ALL VDOT STANDARDS THROUGH LANE CLOSURE. THE CONTRACTOR SHALL MAINTAIN A FIELD ORDER TO THE CONTRACT.
 4. THE CONTRACTOR SHALL MAINTAIN A FIELD ORDER TO THE CONTRACT. THE CONTRACTOR SHALL MAINTAIN A FIELD ORDER TO THE CONTRACT. THE CONTRACTOR SHALL MAINTAIN A FIELD ORDER TO THE CONTRACT.
 5. THE CONTRACTOR SHALL MAINTAIN A FIELD ORDER TO THE CONTRACT. THE CONTRACTOR SHALL MAINTAIN A FIELD ORDER TO THE CONTRACT. THE CONTRACTOR SHALL MAINTAIN A FIELD ORDER TO THE CONTRACT.
 6. THE CONTRACTOR SHALL MAINTAIN A FIELD ORDER TO THE CONTRACT. THE CONTRACTOR SHALL MAINTAIN A FIELD ORDER TO THE CONTRACT. THE CONTRACTOR SHALL MAINTAIN A FIELD ORDER TO THE CONTRACT.
 7. THE CONTRACTOR SHALL MAINTAIN A FIELD ORDER TO THE CONTRACT. THE CONTRACTOR SHALL MAINTAIN A FIELD ORDER TO THE CONTRACT. THE CONTRACTOR SHALL MAINTAIN A FIELD ORDER TO THE CONTRACT.
 8. THE CONTRACTOR SHALL MAINTAIN A FIELD ORDER TO THE CONTRACT. THE CONTRACTOR SHALL MAINTAIN A FIELD ORDER TO THE CONTRACT. THE CONTRACTOR SHALL MAINTAIN A FIELD ORDER TO THE CONTRACT.
 9. STRADDLE MANHOLES ARE NOT ALLOWED.