


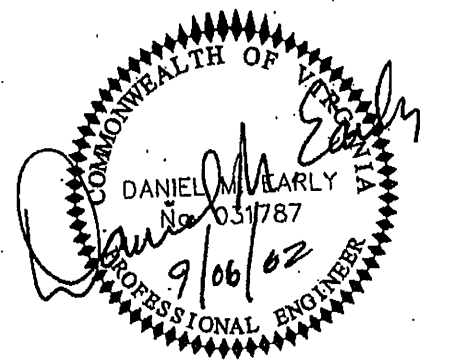


ACS
DESIGN · LLC

Architecture · Civil · Structural
5815 Airport Road, Suite C
Roanoke, Virginia 24012
Phone: 540 776 8626
Fax: 540 776 8627
Email: acsroanoke@aol.com

**SHENANDOAH HUB CAP, TIRE,
AND WHEEL
CITY OF ROANOKE, VIRGINIA**

NOTICE
IT IS AGAINST THE LAW FOR ANY PERSON,
UNLESS AUTHORIZED BY THE LICENSED
PROFESSIONALS WHOSE SEALS ARE
AFFIXED HEREON, TO COPY OR ALTER
THESE DRAWINGS.

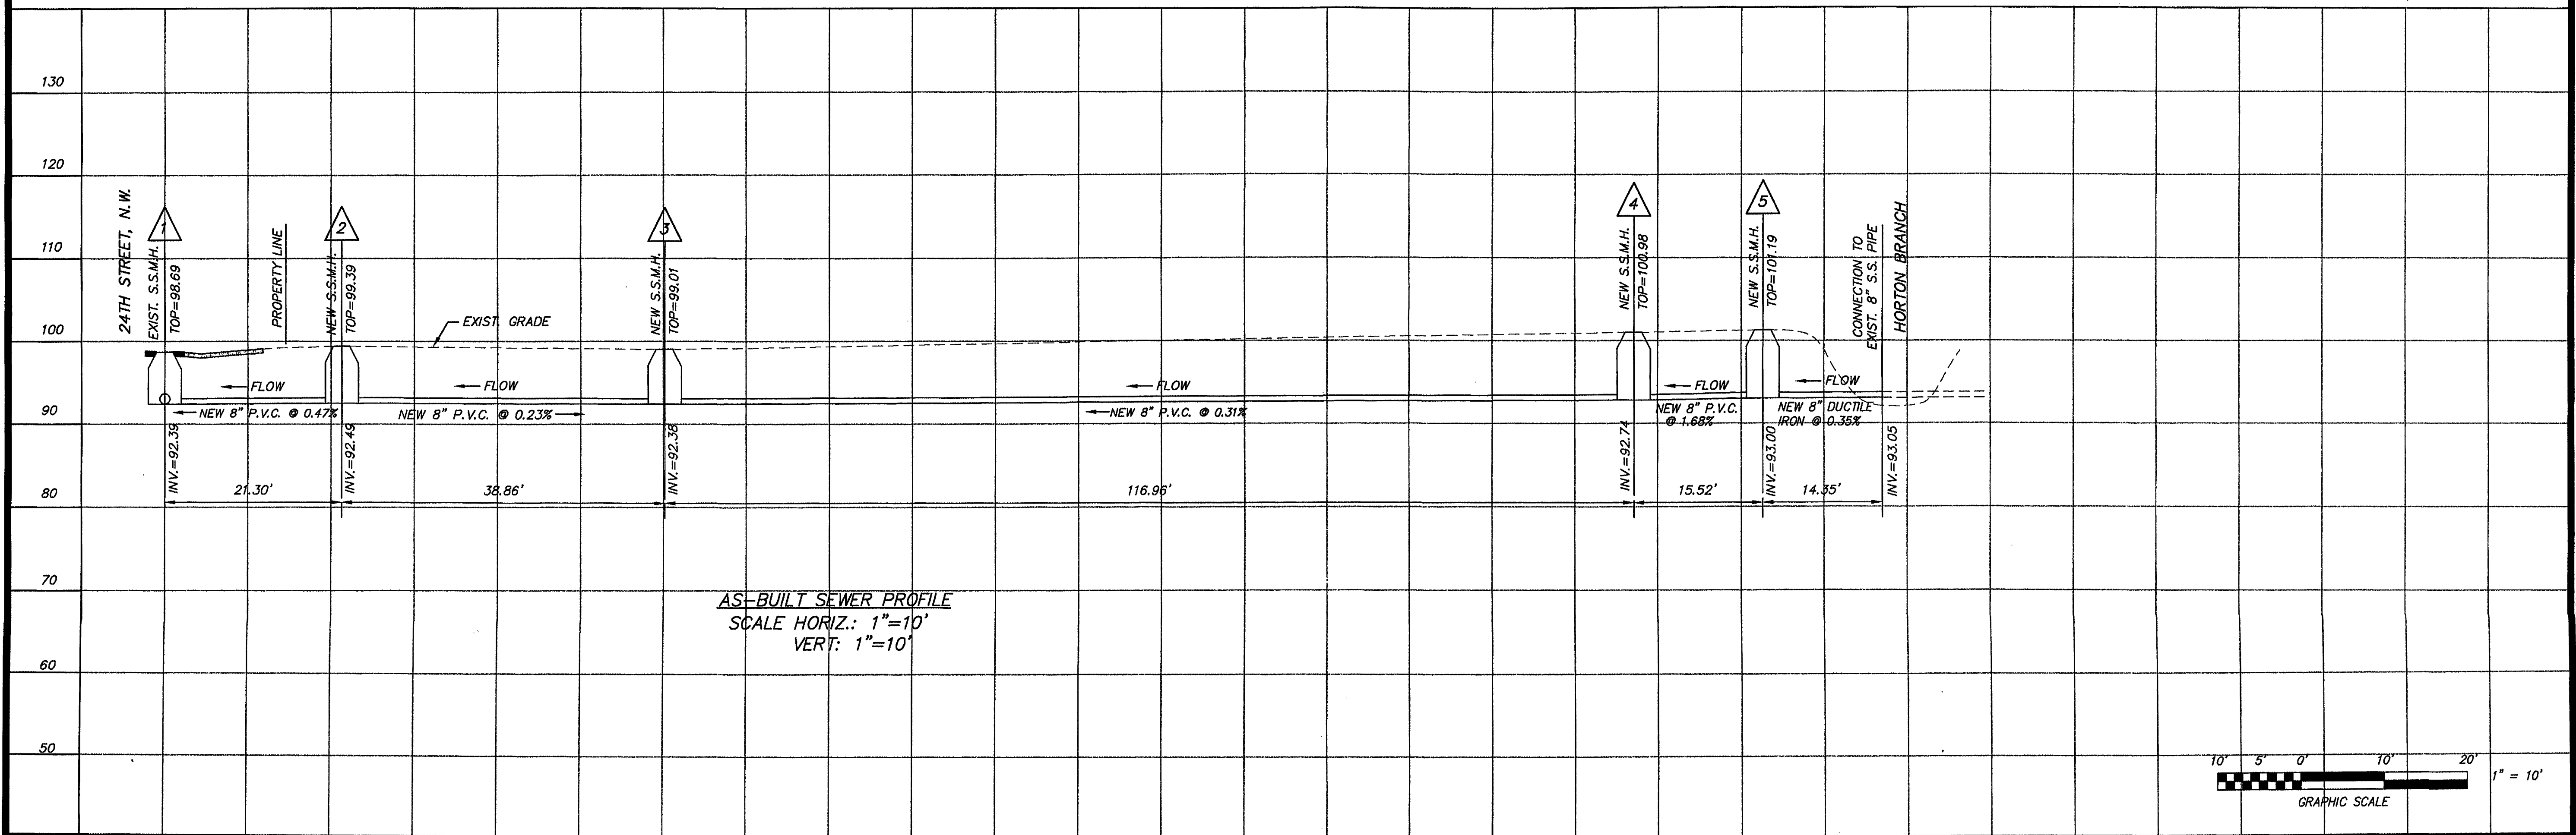

DRAWN BY: M.L.L.

DESIGNED BY: M.L.L.

CHECKED BY:

DATE: JULY 4, 2002

SCALE: 1"=10'

REVISIONS

DATE	REVISION	COMMENT
9/	1	PER ROANOKE CITY
	</	

SHEET No.

C1.6

AS-BUILT SEWER PROFILE

JOB No. 02007