


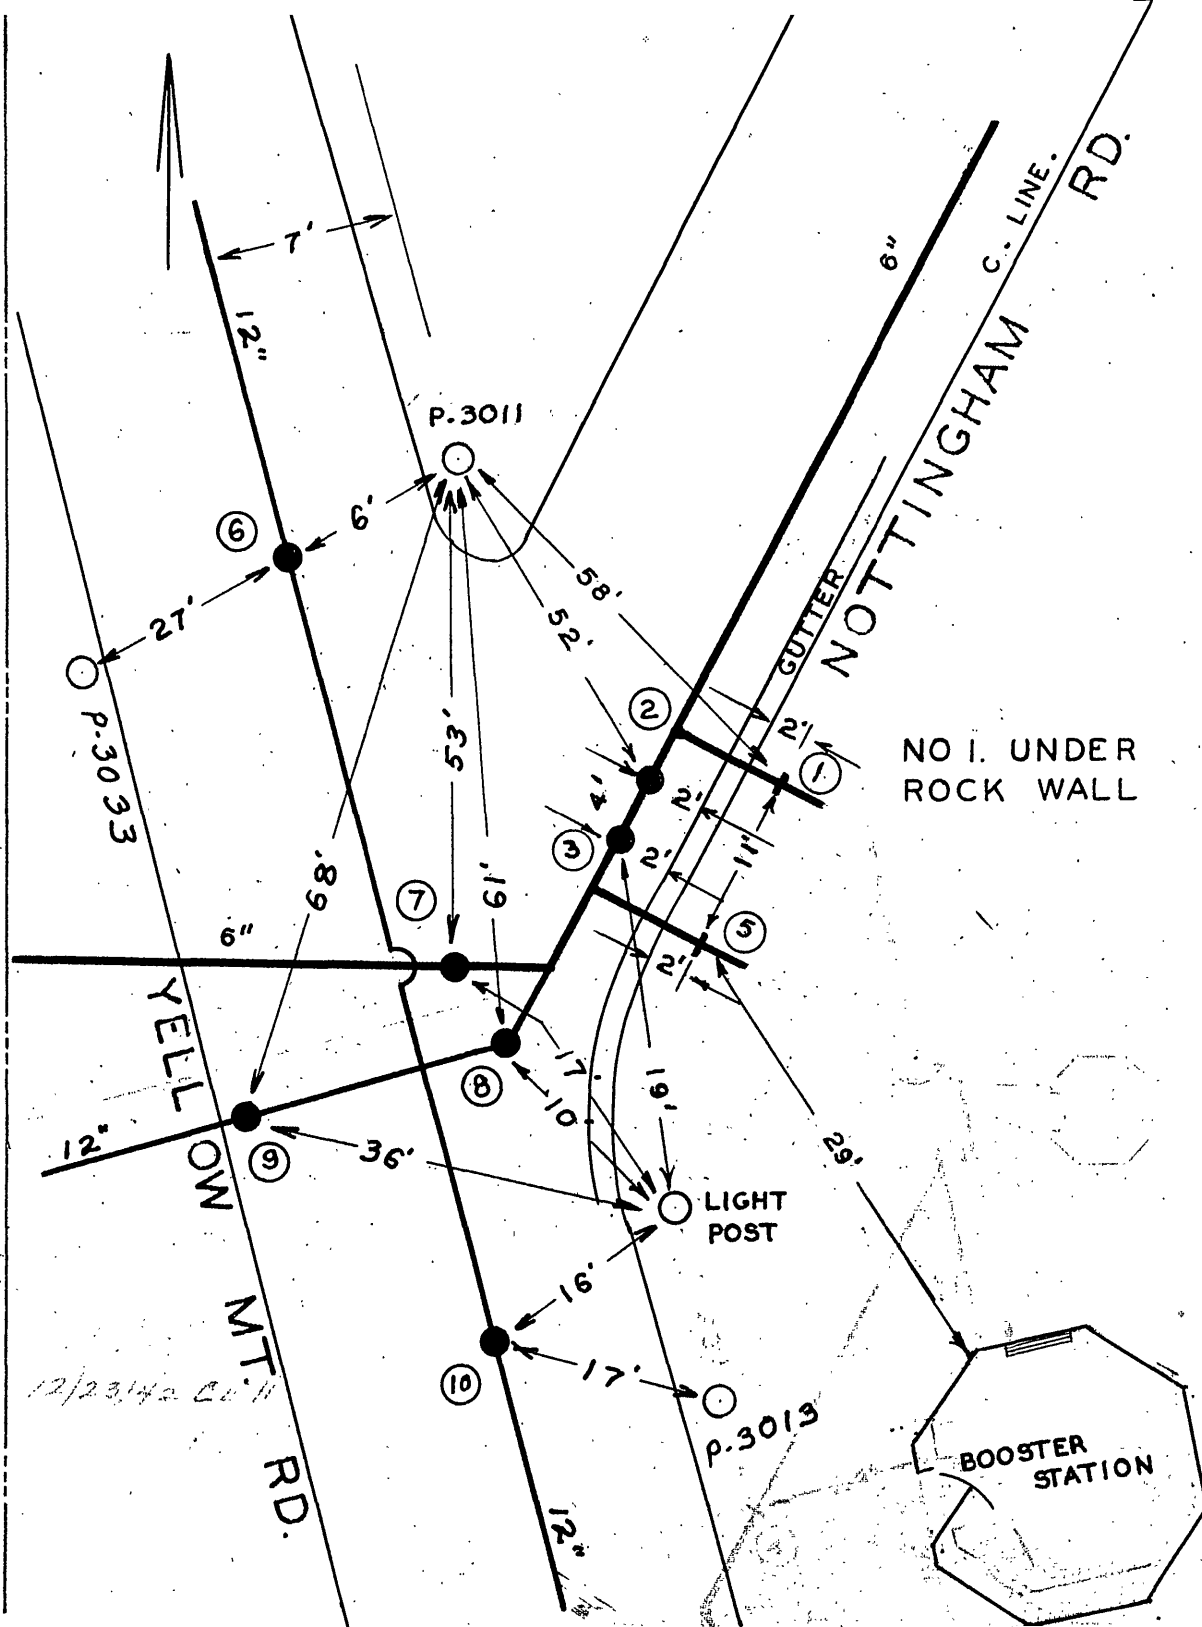

DATE	NO.	SIZE	MAKE	OPEN	TURNS
1928	1	2"		L	9
1928	2	6"	CHECK		
1928	3	6"		R	2 1/2
1928	5	2"		L	9
	6	12"			
	7	6"			
	8	6"			
	9	12"			
	10	12"			

Abandoned
(Updated up 6/2005) Sherwood Forest

CITY OF ROANOKE—WATER DEP'T	
VALVE DIAGRAM	
NOTTINGHAM	ROAD
& YELLOW MT.	ROAD
SHERWOOD FOREST	
SEC. MAP	408
DATE	PAGE NO. S.W.215