




QUANTITY TABLE

Item	Description	Unit	Est Qty
1	12-Inch Ductile Iron Water Line Installation, Open Cut	LF	1,929
2	12-Inch DIP5 DR11 HDPE Water Line Installation, Drilling Methods	LF	25
3	4-Inch Ductile Iron Water Line Installation, Open Cut	LF	33
4	Fire Hydrant Assembly (Including 6-Inch Gate Valve)	EA	1
5	12-Inch Gate Valve and Vault	EA	4
6	4-Inch Gate Valve and Vault	EA	1
7	Air Valve and Vault	EA	3
8	High Pressure Residential Water Single Service Installation - Near	EA	1
9	High Pressure Residential Water Single Service Installation - Far	EA	1
10	Entrance / Driveway Restoration	EA	1
11	Pavement Restoration - Mill & Overlay Public Road	SY	1,275
12	ESC Inlet Protection	EA	2
13	ESC Silt Fence	LF	68

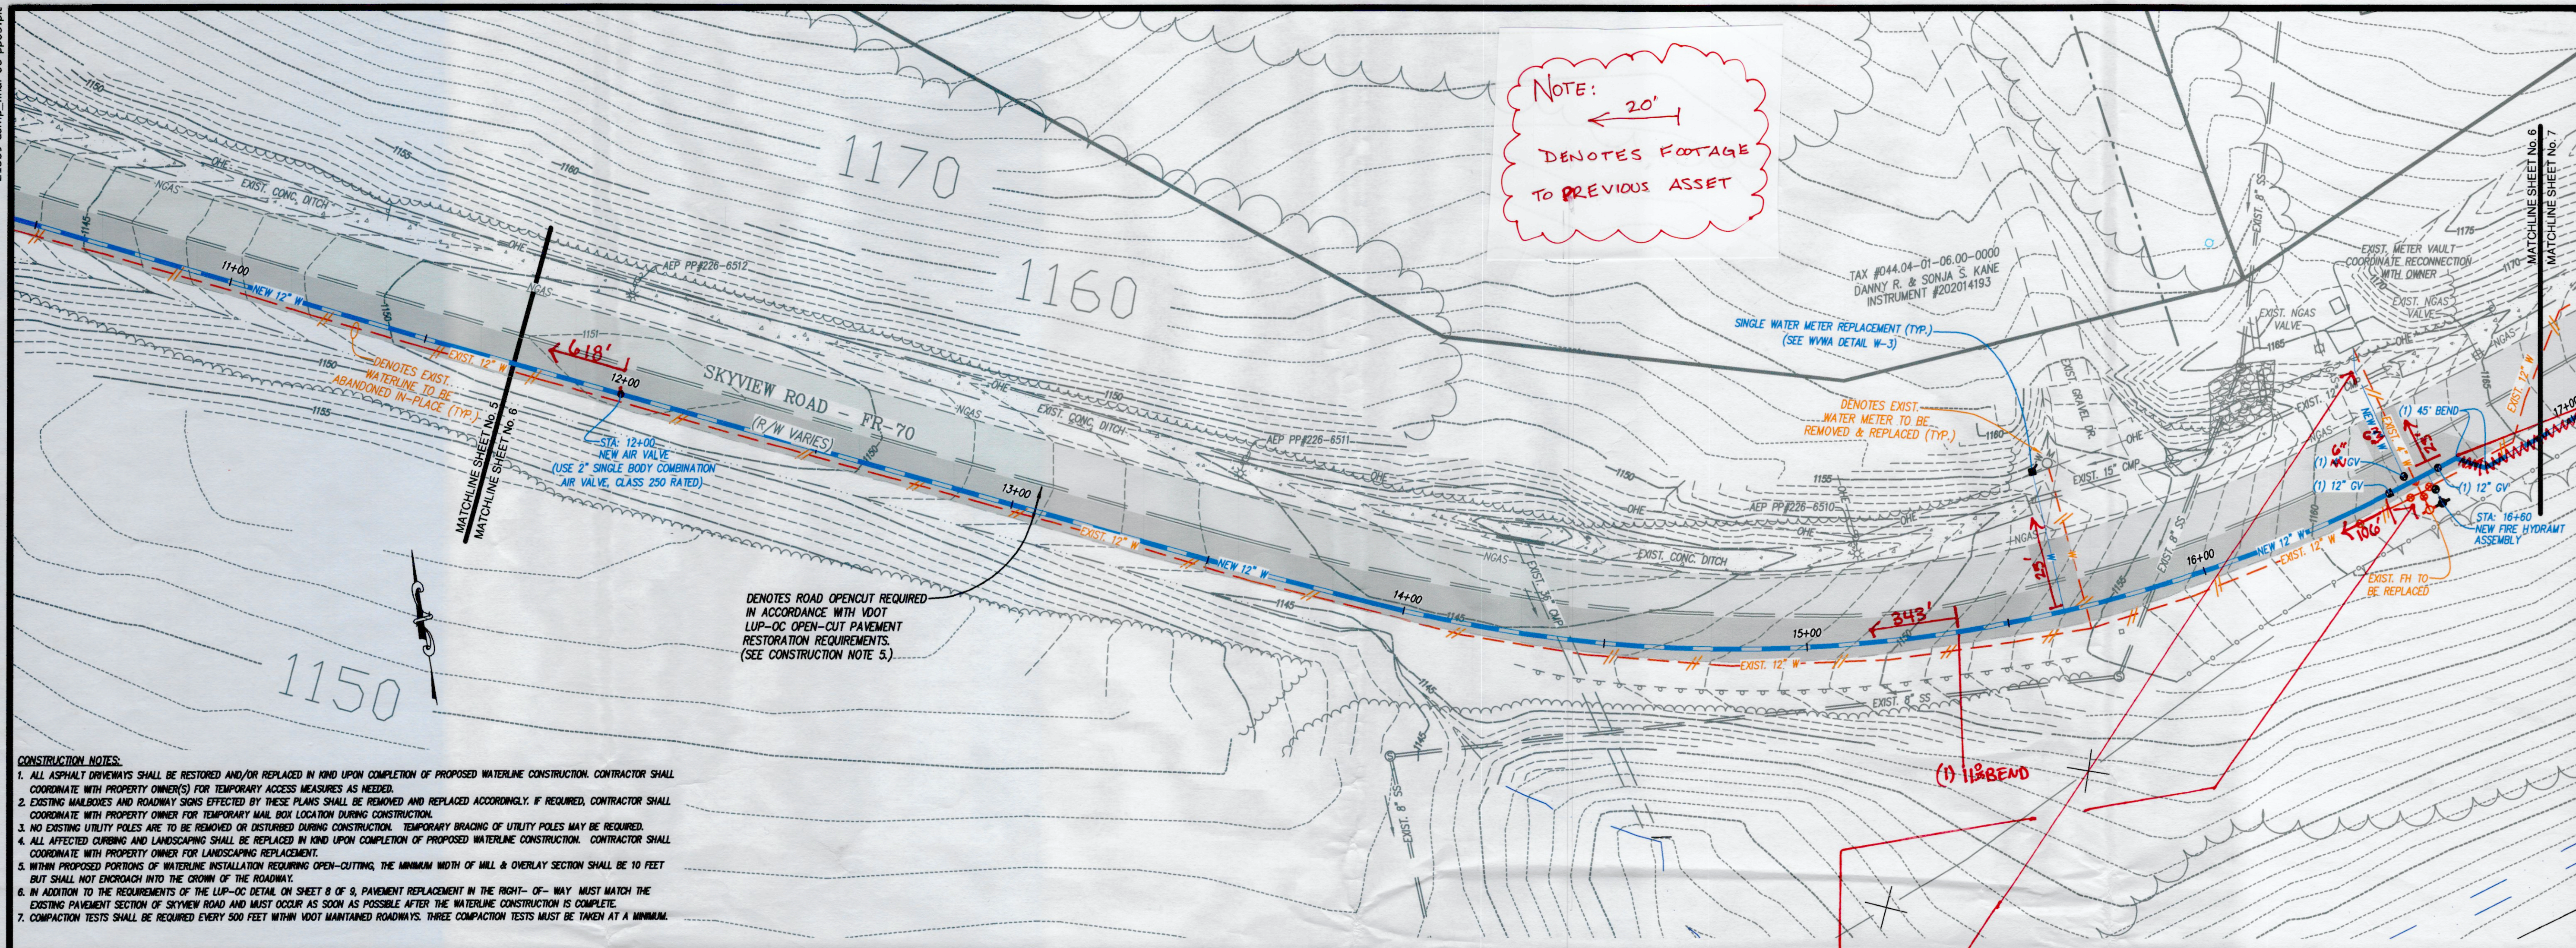