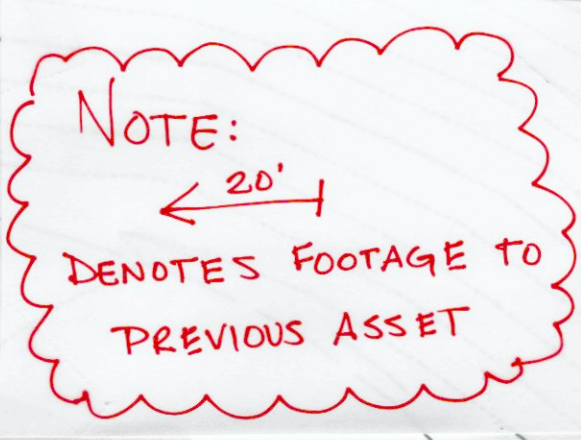
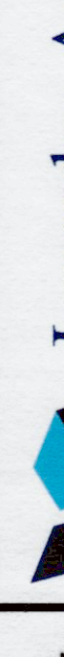


SKYVIEW ROAD WATERLINE REPLACEMENTS PREPARED FOR WESTERN VIRGINIA WATER AUTHORITY SITUATED IN ROANOKE COUNTY, VIRGINIA		PLAN & PROFILE SKYVIEW ROAD (STA. 17+00 - 20+50)	
			
Lumsden Associates, P.C. ENGINEERS SURVEYORS PLANNERS		4664 BRAMBLETON AVENUE P.O. BOX 20659 ROANOKE, VIRGINIA 24018 PHONE: (540) 774-4411 FAX: (540) 772-9445 WWW.LUMSDENPC.COM	