


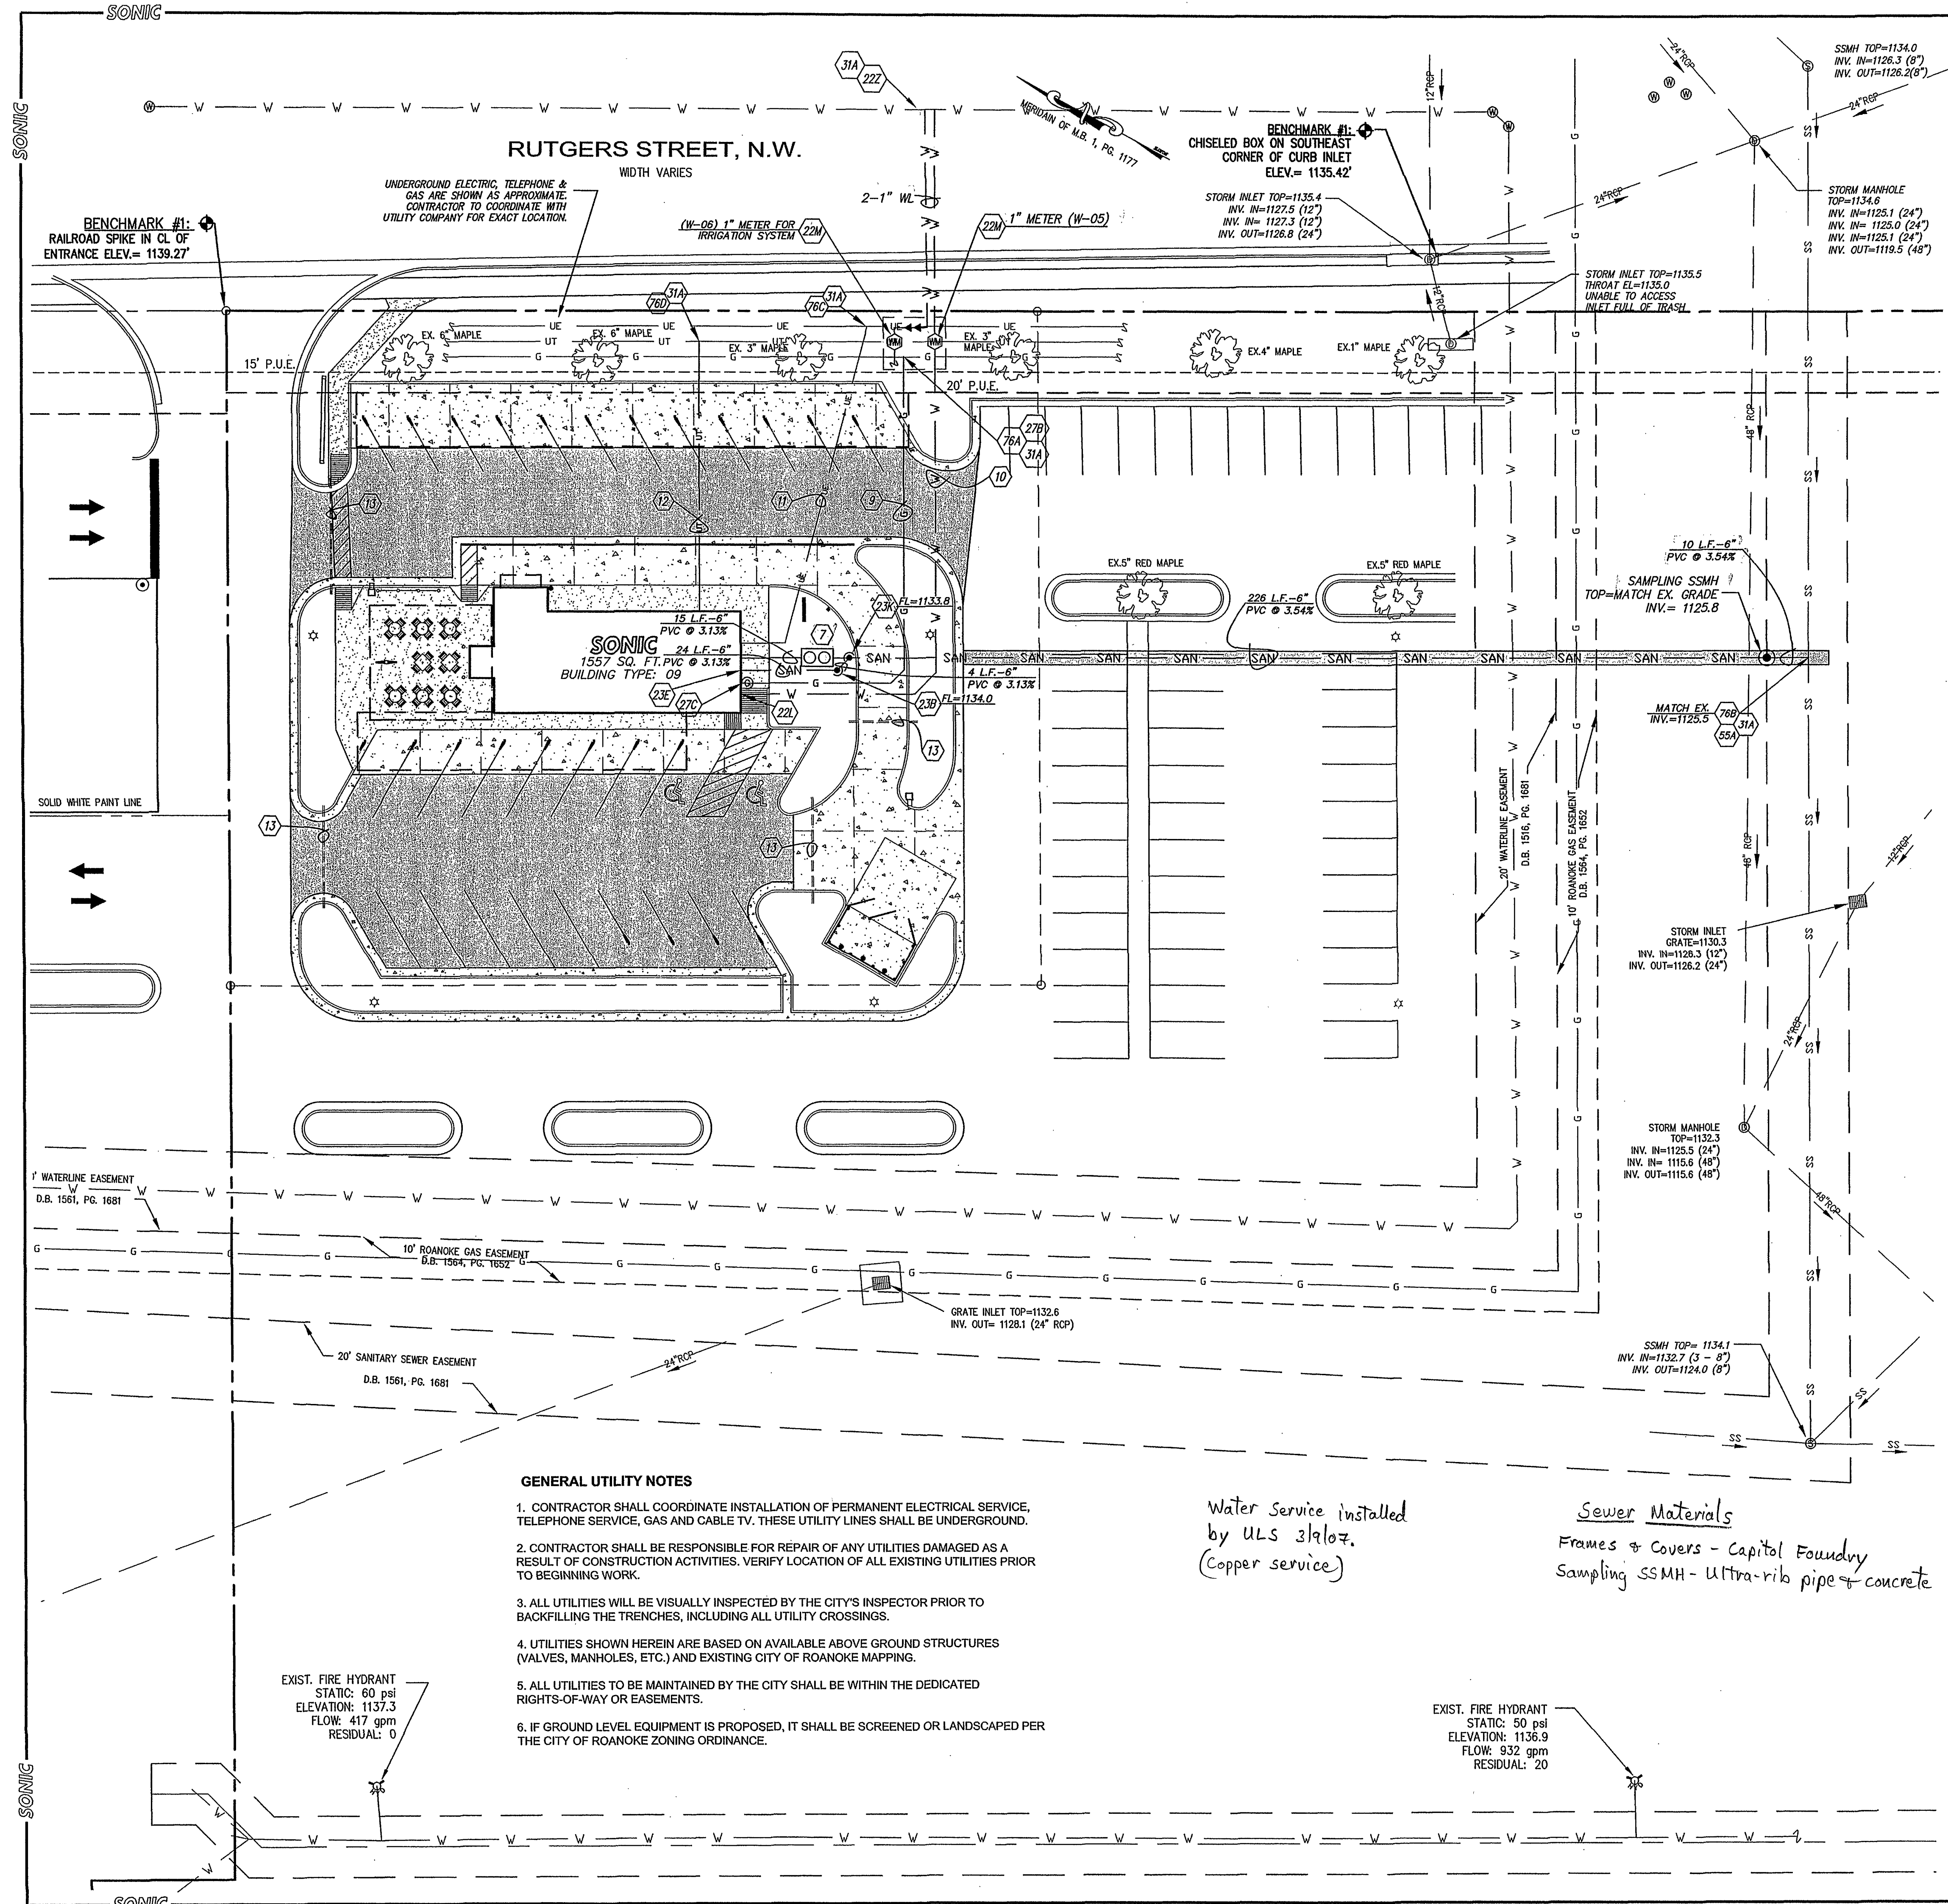


SITE PLAN KEYNOTES	
ITEM	NOTE
①	TRAFFIC FLOW ARROW (TYPICAL), REF: SD4.23
②	4" PAINTED STRIPES
③	CURB RAMP (TYPICAL), REF: SD4.05
④	TRASH & GREASE DUMPSTERS ENCLOSURE, REF: SD3.01
⑤	RAILING, REF: SD2.24
⑥	BOLLARD, REF: SD2.20
⑦	GREASE TRAP, REF: P1 & P2
⑧	6" SANITARY SEWER LINE
⑨	2" UNDERGROUND GAS LINE
⑩	1-1/4" UNDERGROUND WATER LINE W/1" METER
⑪	UNDERGROUND ELECTRIC LINE
⑫	2" UNDERGROUND TELEPHONE LINE
⑬	4" PVC PIPE SLEEVE UNDER DRIVE FOR IRRIGATION SYSTEM
⑭	ORDER BOARD AND DETECTOR LOOP, REF: SD2.07 AND SD2.21
⑮	MENU / CANOPY POST (TYPICAL), REF: CA1.23
⑯	CONCRETE DRIVE, BUILD IN ACCORDANCE WITH CITY AND OR STATE SPECIFICATIONS
⑰	CONCRETE PAVING
⑱	8" THICK, CONCRETE PAVING IN THIS AREA
⑲	"CARHOP CROSSING" SIGNAGE, REF: SD2.17
⑳	- NOT USED -
㉑	- NOT USED -
㉒	ASPHALT PAVING REF: DETAILS ON CIVIL SHEETS.
㉓	CONC. CURB & GUTTER, REF: DETAILS ON CIVIL SHEETS
㉔	CONC. WALKS AND PATIO REF: CIVIL DRAWINGS & SD5.
㉕	LOOSE TABLES & CHAIRS. REF. SD5 FOR SPECS.
㉖	- NOT USED -
㉗	- NOT USED -
㉘	TRASH CANS WITH 2'X2' PADS

- UTILITY NOTES**
- 22L METERED DOMESTIC WATER SERVICE ENTRY PER ARCH. PLANS (SEE SIZES THIS SHEET)
 - 22M PROPOSED WATER METER (PER LOCAL CODES AND SPECIFICATIONS)
 - 22Z POINT OF CONNECTION PER LOCAL CODES - DOMESTIC SERVICE TAP, W-05 (SEE SIZES THIS SHEET).
 - 23B SANITARY SEWER CLEAN-OUT (PER LOCAL CODES)
 - 23E SANITARY SEWER SERVICE ENTRY (PER ARCH. PLANS)
 - 23K SANITARY SEWER SERVICE WYE (PER LOCAL CODES)
 - 27B GAS SERVICE PER LOCAL GAS COMPANY
 - 27C PROPOSED GAS METER
 - 30G PROPOSED UTILITIES TO BE BURIED IN THE SAME TRENCH INSTALLATION SHALL BE COORDINATED AND APPROVED BY LOCAL UTILITY COMPANIES.
 - 31A LOCATION FOR THIS UTILITY AS APPROXIMATE ONLY. CONTRACTOR SHALL VERIFY THE EXACT LOCATION IN THE FIELD PRIOR TO THE CONSTRUCTION OF THE PROPOSED UTILITY LINE. TO BE CONNECTED. CONTRACTOR SHALL NOTIFY PARKER DESIGN GROUP IF THE DESIGN AS SHOWN IS NOT ACHIEVABLE.
 - 55A CONTRACTOR SHALL VERIFY EXACT LOCATION AND DEPTH OF EXISTING SANITARY SEWER SERVICE. IF DEPTH IS NOT ADEQUATE FOR CONNECTION OF NEW LINE, CONTACT PARKER DESIGN GROUP WITH INFORMATION FOR EVALUATION OF ALTERNATIVES.
 - 76A CONTRACTOR SHALL CONTACT ROANOKE GAS COMPANY, BRETT BENNETT 540-777-3971 GAS SERVICE LOCATION AND CONNECTION PROCEDURE.
 - 76B SANITARY SEWER TAP TO EXISTING MANHOLE TO BE PERFORMED BY THE WESTERN VIRGINIA WATER AUTHORITY (WVWA) UTILITY DEPARTMENT. CONTRACTOR SHALL BE RESPONSIBLE FOR EXCAVATION AND SHORING PER OSHA REGULATIONS. CONTRACTOR SHALL PROVIDE CENTER MARK FOR TAPPING.
 - 76C CONTRACTOR SHALL CONTACT AMERICAN ELECTRIC POWER (AEP), MARTIN MCGEE 540-427-3684 FOR CONNECTION LOCATION AND SERVICE PROCEDURE.
 - 76D CONTRACTOR SHALL CONTACT VERIZON, BERLIE BOWMAN, T.E.C.-CONTRACTOR FOR VERIZON, AT 540-562-4600 FOR CONNECTION LOCATION AND SERVICE PROCEDURE.

- GENERAL UTILITY NOTES**
- CONTRACTOR SHALL COORDINATE INSTALLATION OF PERMANENT ELECTRICAL SERVICE, TELEPHONE SERVICE, GAS AND CABLE TV. THESE UTILITY LINES SHALL BE UNDERGROUND.
 - CONTRACTOR SHALL BE RESPONSIBLE FOR REPAIR OF ANY UTILITIES DAMAGED AS A RESULT OF CONSTRUCTION ACTIVITIES. VERIFY LOCATION OF ALL EXISTING UTILITIES PRIOR TO BEGINNING WORK.
 - ALL UTILITIES WILL BE VISUALLY INSPECTED BY THE CITY'S INSPECTOR PRIOR TO BACKFILLING THE TRENCHES, INCLUDING ALL UTILITY CROSSINGS.
 - UTILITIES SHOWN HEREIN ARE BASED ON AVAILABLE ABOVE GROUND STRUCTURES (VALVES, MANHOLES, ETC.) AND EXISTING CITY OF ROANOKE MAPPING.
 - ALL UTILITIES TO BE MAINTAINED BY THE CITY SHALL BE WITHIN THE DEDICATED RIGHTS-OF-WAY OR EASEMENTS.
 - IF GROUND LEVEL EQUIPMENT IS PROPOSED, IT SHALL BE SCREENED OR LANDSCAPED PER THE CITY OF ROANOKE ZONING ORDINANCE.


Water Service installed by ULS 3/19/07.
(Copper service)

Sewer Materials
Frames & Covers - Capitol Foundry
Sampling SSMH - Ultra-rib pipe & concrete

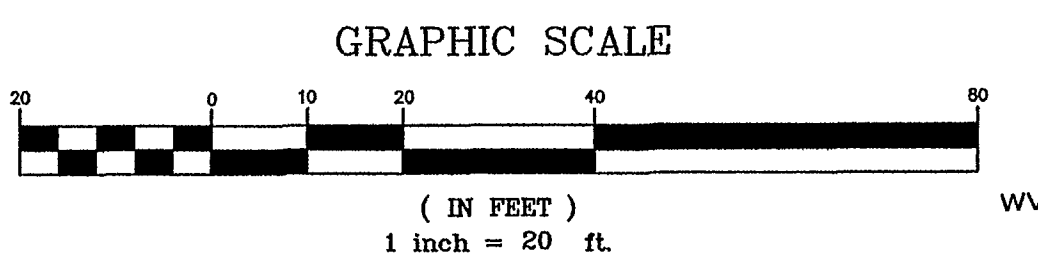


AS - BUILT
06/29/2007

WVWA ID# 6WVR9G

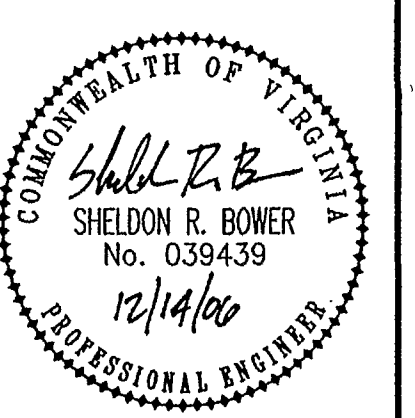

REVISIONS	
NO.	DATE
10/20/06	PER CITY OF ROANOKE COMMENTS
11/09/06	PER CITY OF ROANOKE COMMENTS
11/09/06	PER CITY OF ROANOKE COMMENTS
12/14/06	PER WESTERN VIRGINIA WATER AUTHORITY

parker
DESIGN GROUP
816 Boulevard
Salem, Virginia 24153
Phone: 540-387-1153
Fax: 540-389-5767
www.parkerdg.com

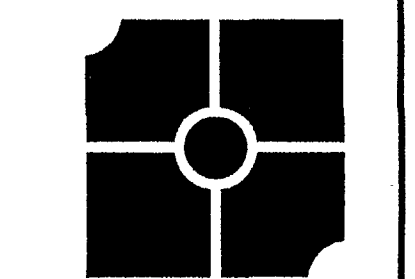

SONIC CORPORATION
300 JOHNNY BENCH DR
OKLAHOMA CITY, OK 73104
OFFICES: 405-225-5000
FAX: 405-225-5991
AMERICA'S DRIVE-IN CORP.
COPYRIGHT 1988-2006
ALL RIGHTS RESERVED. NO PART OF THIS DOCUMENT IS TO BE REPRODUCED OR TRANSMITTED IN ANY FORM OR BY ANY MEANS, ELECTRONIC OR MECHANICAL, INCLUDING PHOTOCOPYING, RECORDING, OR BY ANY INFORMATION STORAGE AND RETRIEVAL SYSTEM, WITHOUT PERMISSION IN WRITING FROM SONIC CORPORATION.

SONIC DRIVE-IN
BUILDING TYPE: 09
Rutgers Street, N.W.,
Roanoke, Virginia

SHEET
C-5
DWG: 06-0064-03
DATE: SEPTEMBER 5, 2006