
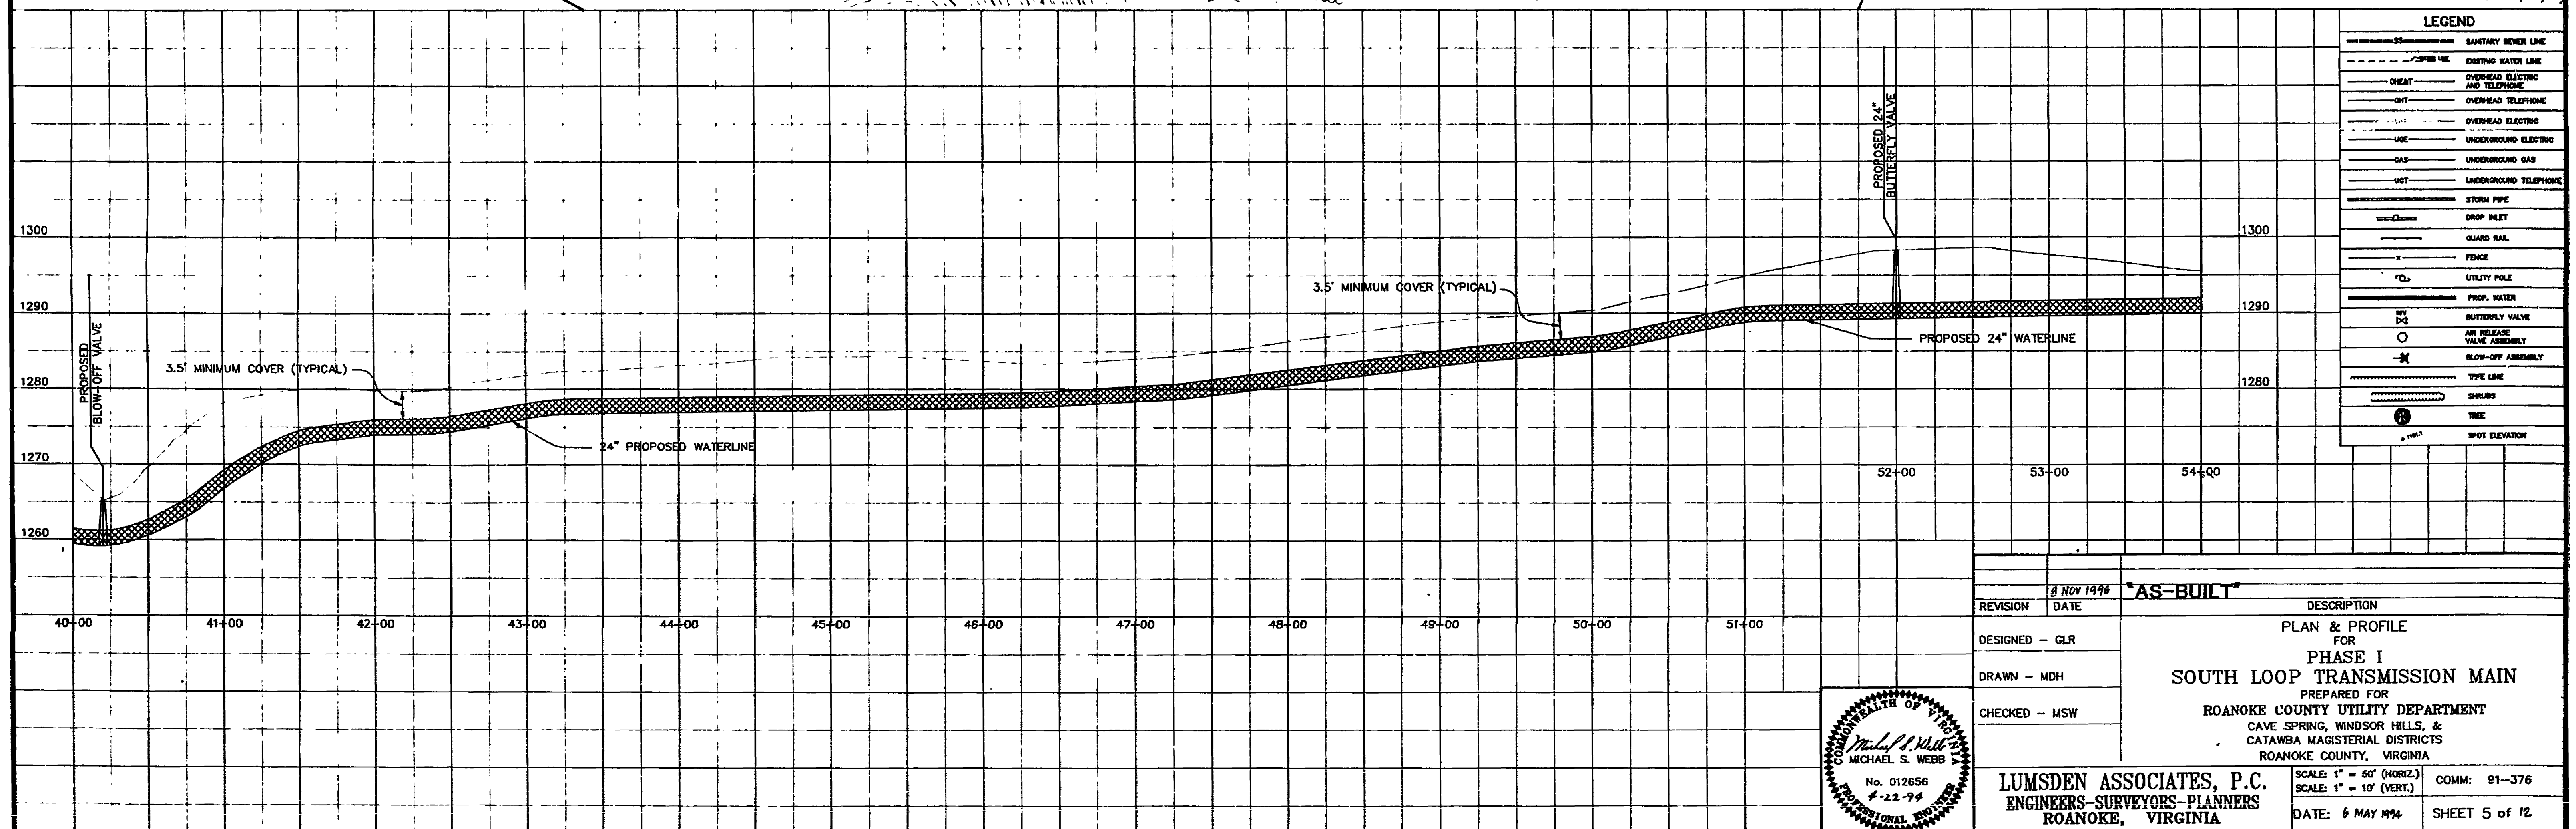


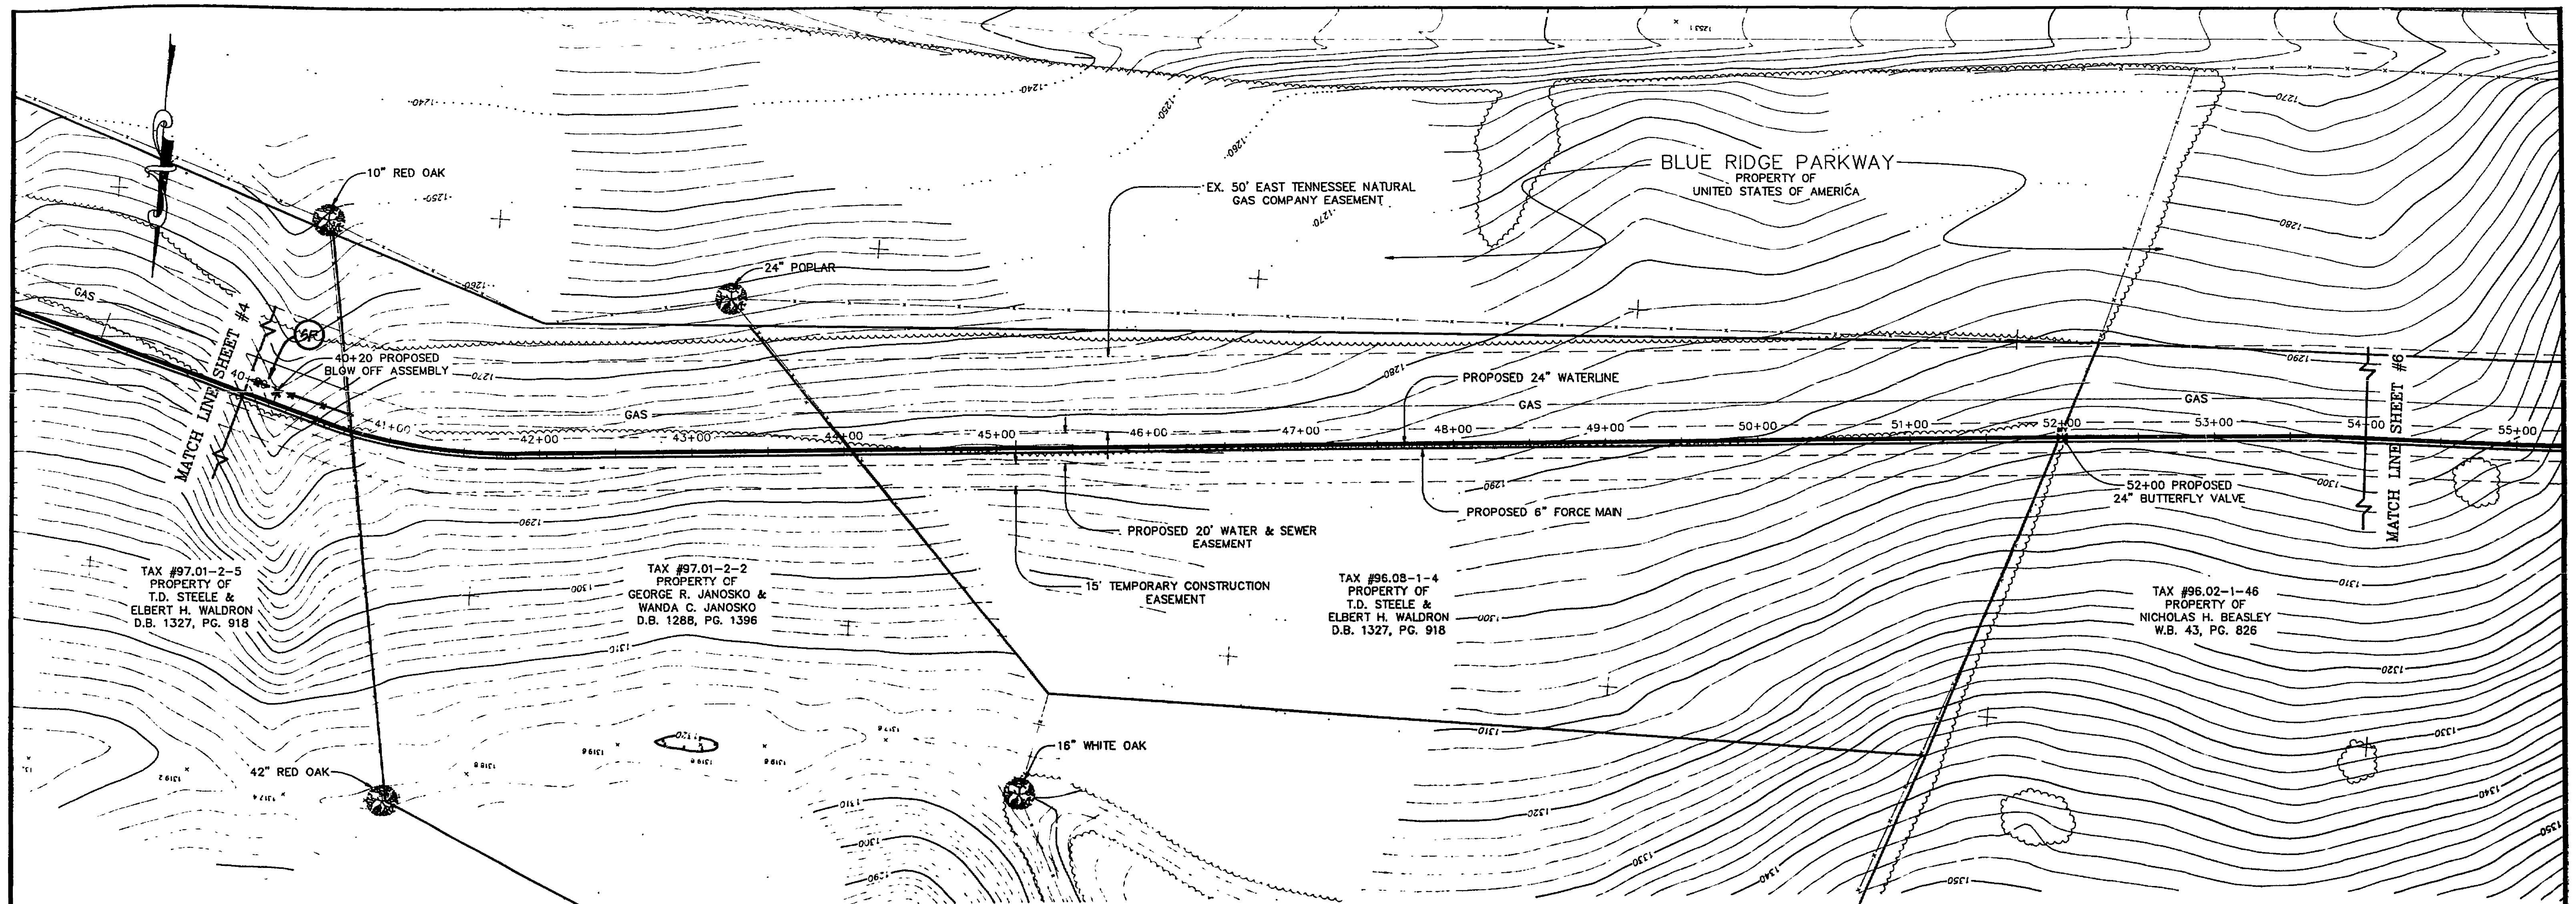

8 NOV 1998		AS-BUILT	
REVISION	DATE	DESCRIPTION	
DESIGNED - GLR		PLAN & PROFILE FOR	
DRAWN - MDH		PHASE I	
CHECKED - MSW		SOUTH LOOP TRANSMISSION MAIN	
		PREPARED FOR	
		ROANOKE COUNTY UTILITY DEPARTMENT	
		CAVE SPRING, WINDSOR HILLS, &	
		CATAWBA MAGISTERIAL DISTRICTS	
		ROANOKE COUNTY, VIRGINIA	
		LUMSDEN ASSOCIATES, P.C. ENGINEERS-SURVEYORS-PLANNERS ROANOKE, VIRGINIA	
SCALE: 1" = 50' (HORIZ.) SCALE: 1" = 10' (VERT.) DATE: 6 MAY 1998		COMM: 91-376 SHEET 5 OF 12	