

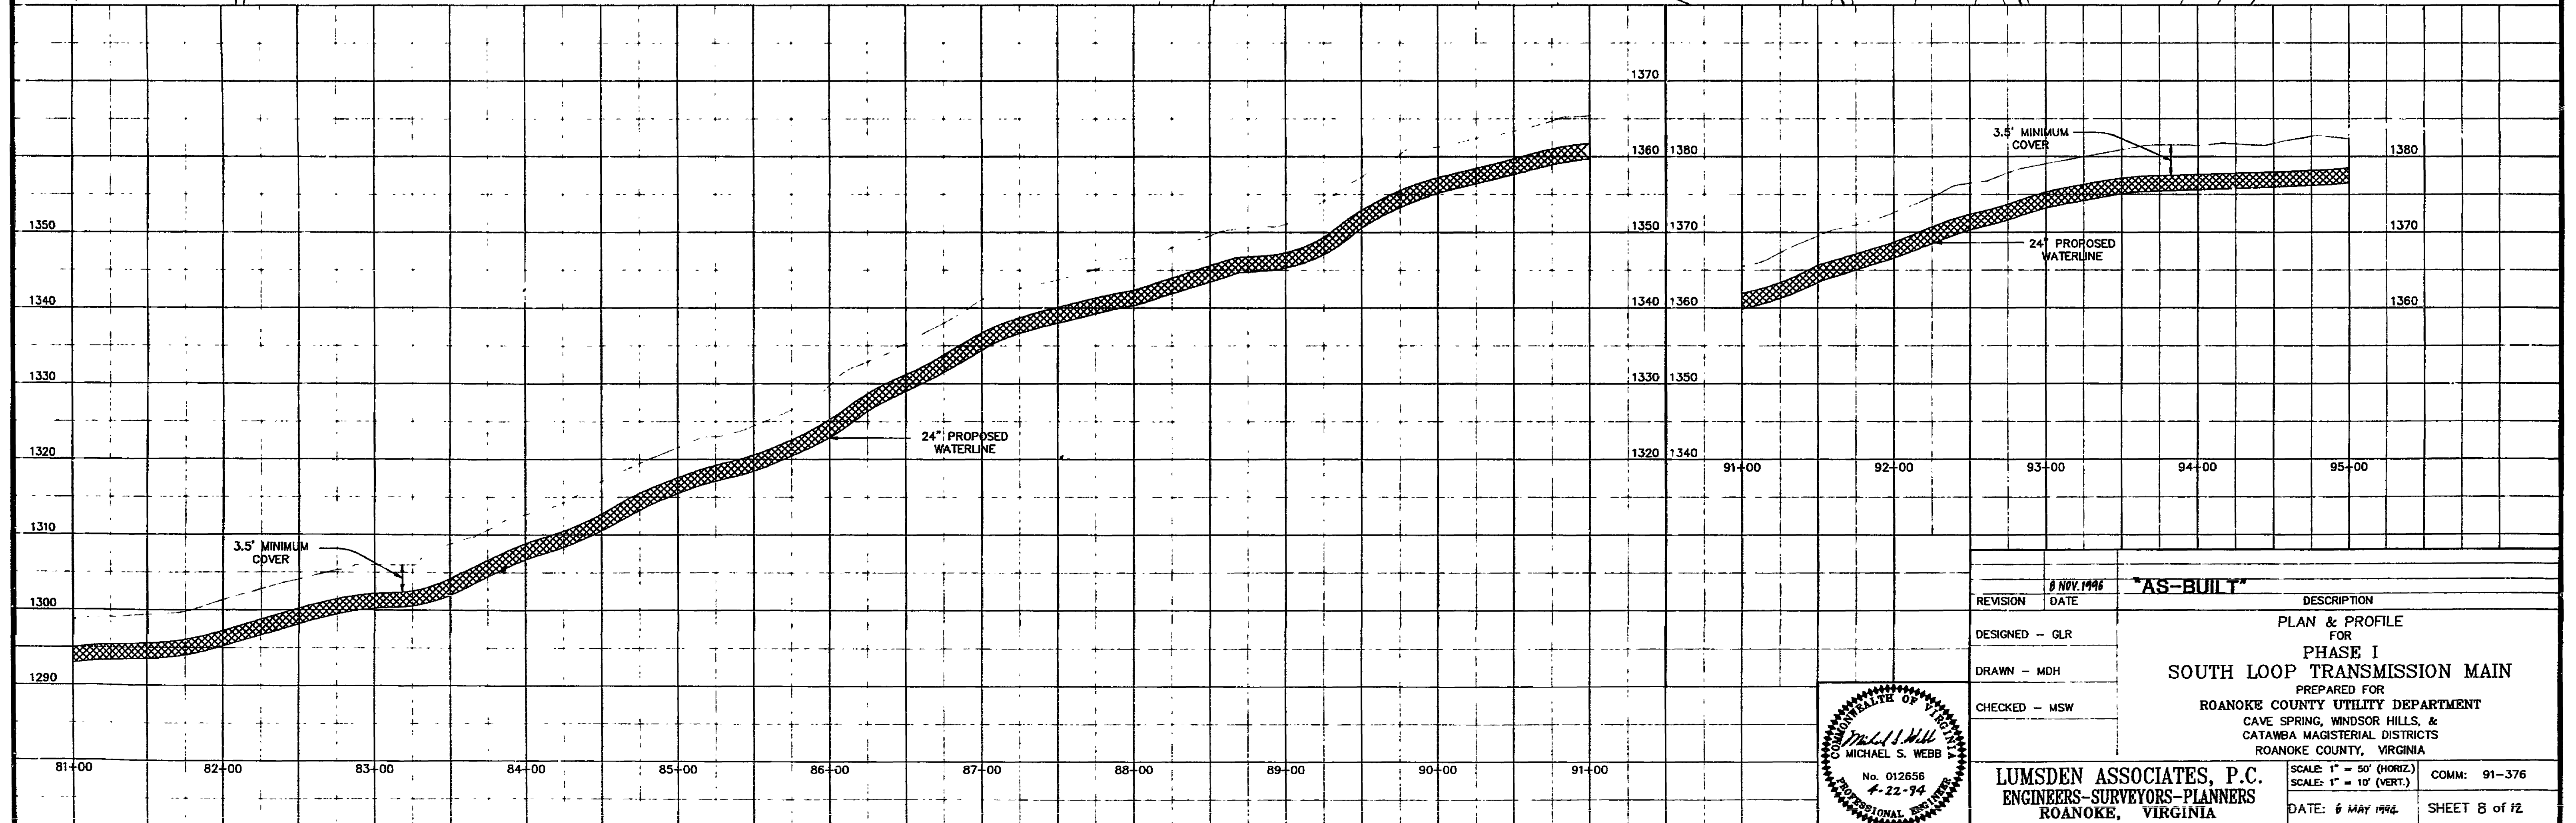


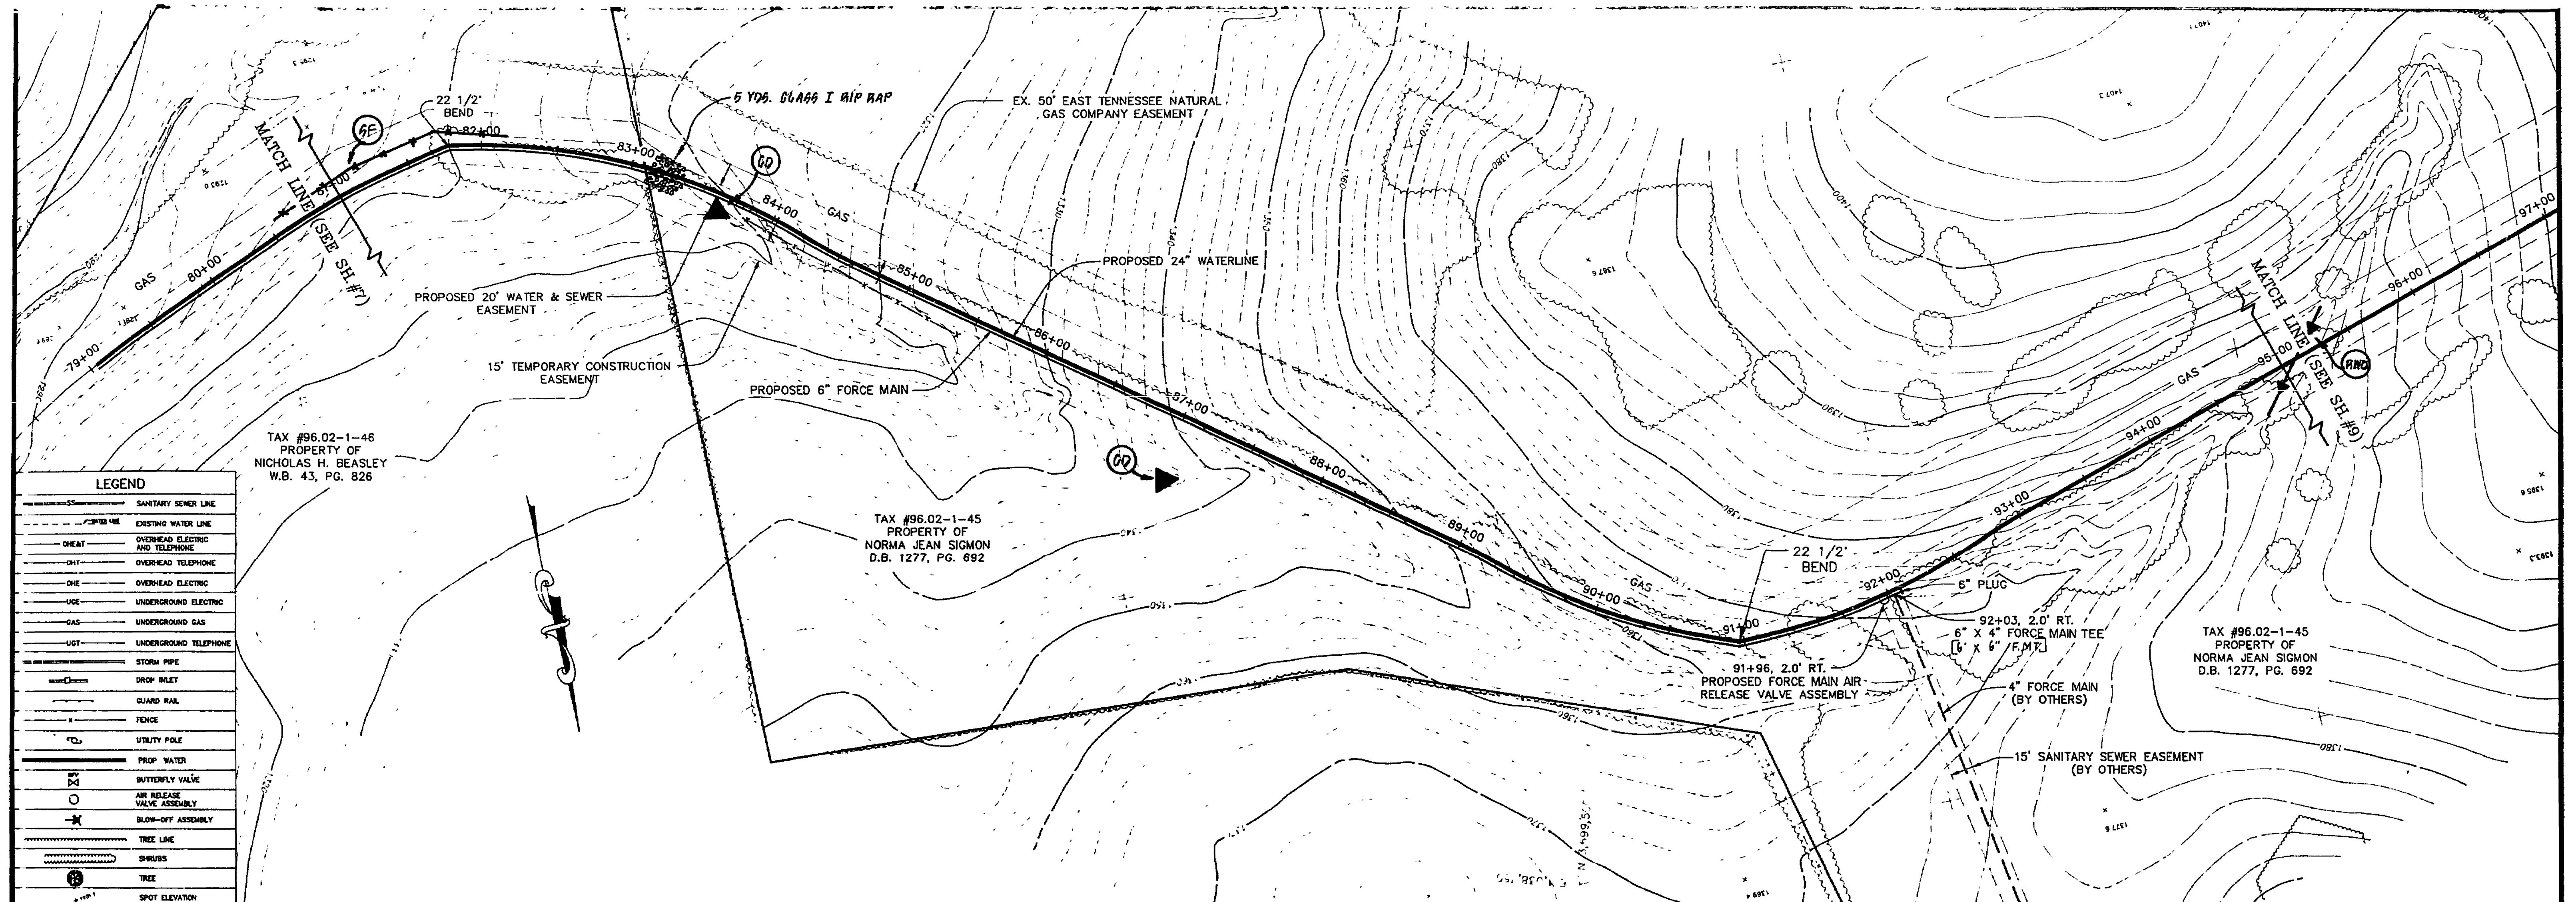

REVISION	DATE	DESCRIPTION
DESIGNED - GLR		PLAN & PROFILE FOR PHASE I SOUTH LOOP TRANSMISSION MAIN
DRAWN - MDH		PREPARED FOR ROANOKE COUNTY UTILITY DEPARTMENT
CHECKED - MSW		CAVE SPRING, WINDSOR HILLS, & CATAMBA MAGISTERIAL DISTRICTS, ROANOKE COUNTY, VIRGINIA

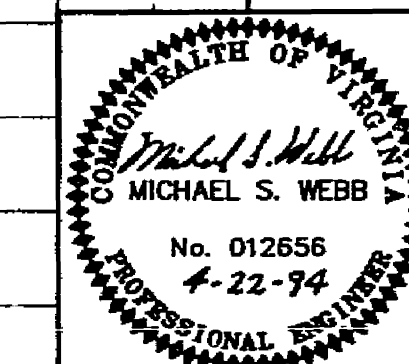

LUMSDEN ASSOCIATES, P.C.
 ENGINEERS-SURVEYORS-PLANNERS
 ROANOKE, VIRGINIA
 SCALE: 1" = 50' (HORIZ.)
 SCALE: 1" = 10' (VERT.)
 DATE: 6 MAY 1996
 COMM: 91-376
 SHEET 8 of 12