




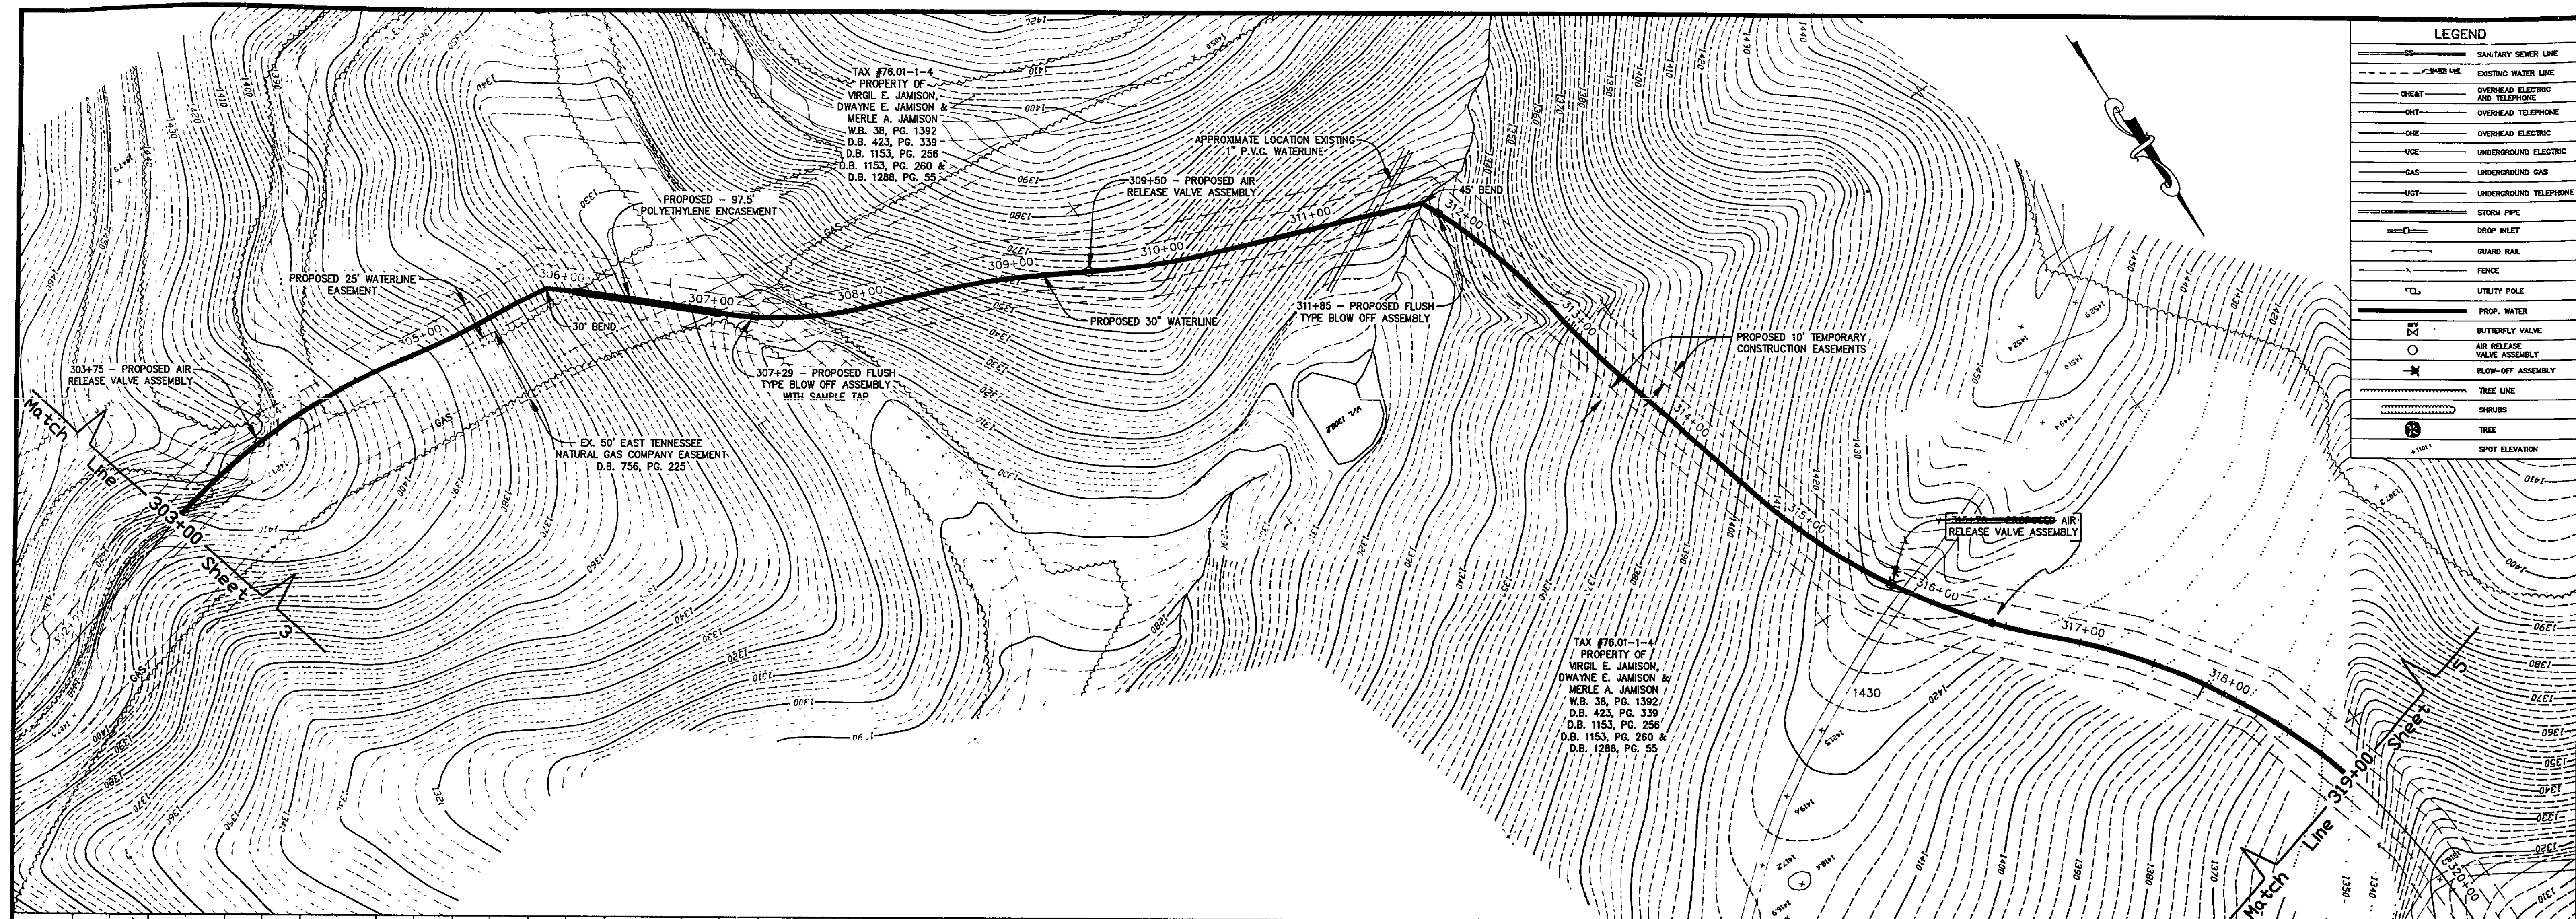

LEGEND	
	SANITARY SEWER LINE
	EXISTING WATER LINE
	OVERHEAD ELECTRIC AND TELEPHONE
	OVERHEAD ELECTRIC
	OVERHEAD ELECTRIC
	OVERHEAD ELECTRIC
	UNDERGROUND ELECTRIC
	UNDERGROUND GAS
	UNDERGROUND TELEPHONE
	STORM PIPE
	DROP INLET
	GUARD RAIL
	FENCE
	UTILITY POLE
	PROP. WATER
	BUTTERFLY VALVE
	AIR RELEASE VALVE ASSEMBLY
	BLOW-OFF ASSEMBLY
	TREE LINE
	SHRUBS
	TREE
	SPOT ELEVATION

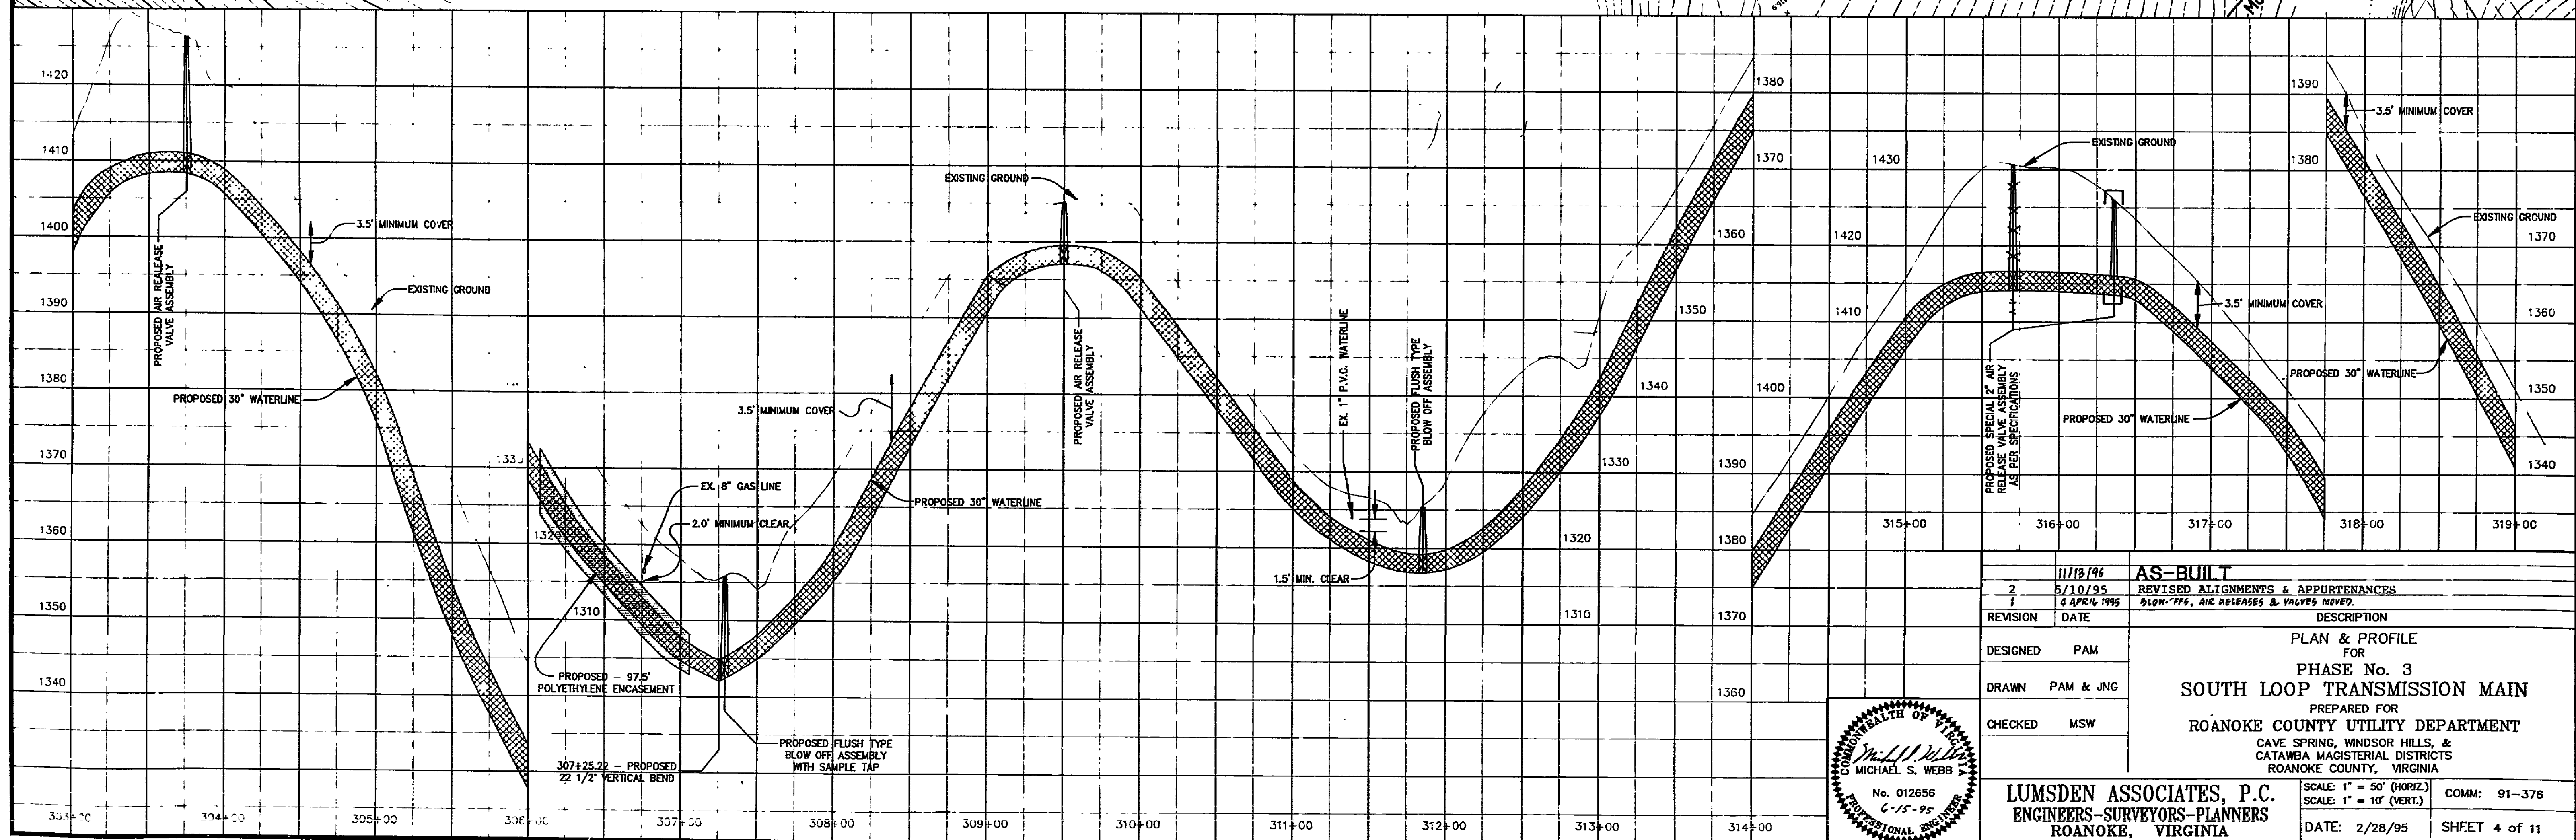

	11/18/96	AS-BUILT
2	5/10/95	REVISED ALIGNMENTS & APPURTENANCES
1	6 APRIL 1995	910W P.P.S., AIR RELEASES & VALVES MOVED.
REVISION	DATE	DESCRIPTION
DESIGNED	PAM	PLAN & PROFILE FOR PHASE No. 3
DRAWN	PAM & JNG	SOUTH LOOP TRANSMISSION MAIN
CHECKED	MSW	PREPARED FOR ROANOKE COUNTY UTILITY DEPARTMENT
		CAVE SPRING, WINDSOR HILLS, & CATAMBA MAGISTERIAL DISTRICTS ROANOKE COUNTY, VIRGINIA
LUMSDEN ASSOCIATES, P.C. ENGINEERS-SURVEYORS-PLANNERS ROANOKE, VIRGINIA		
SCALE: 1" = 50' (HORIZ.)		COMM: 91-376
SCALE: 1" = 10' (VERT.)		
DATE: 2/28/95		SHEET 4 of 11

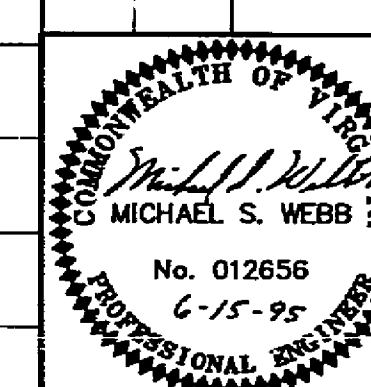

WT-0489