
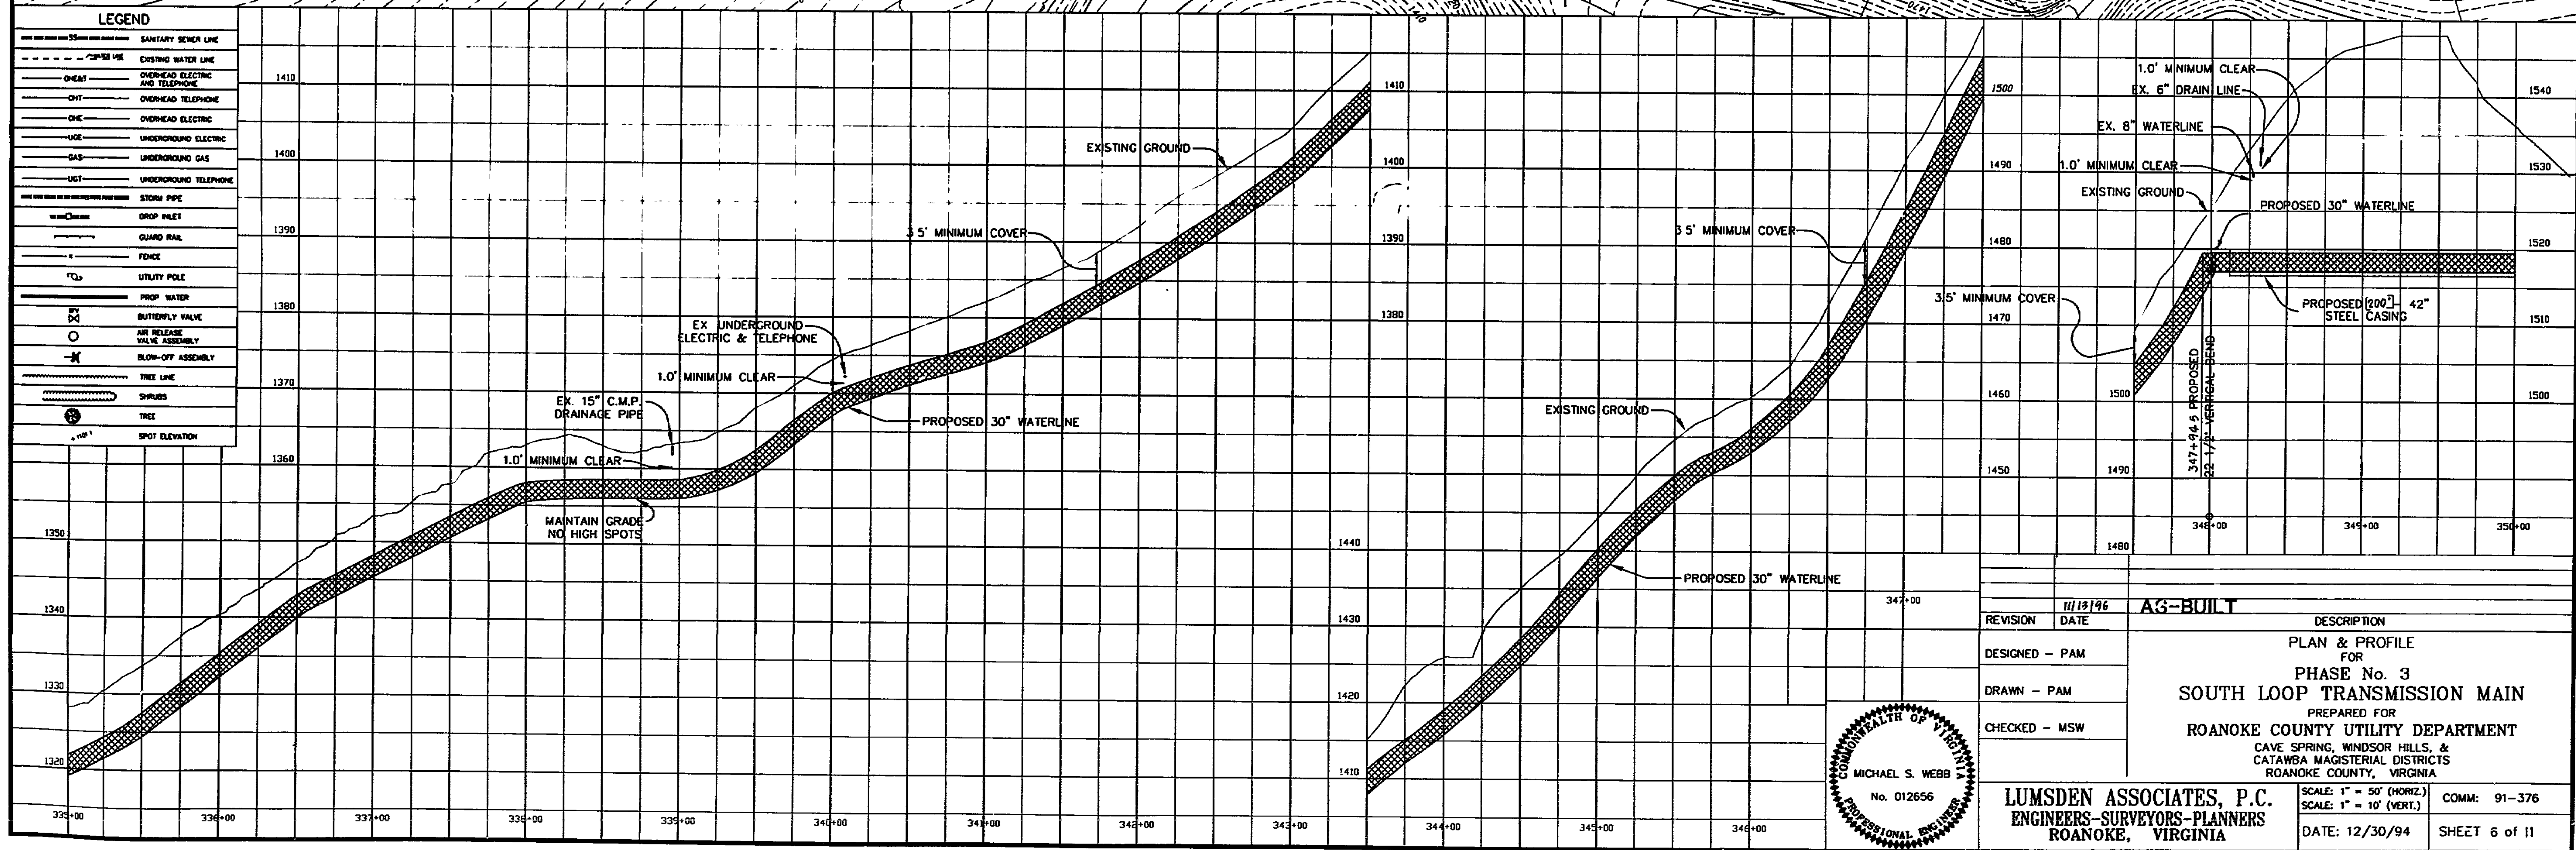


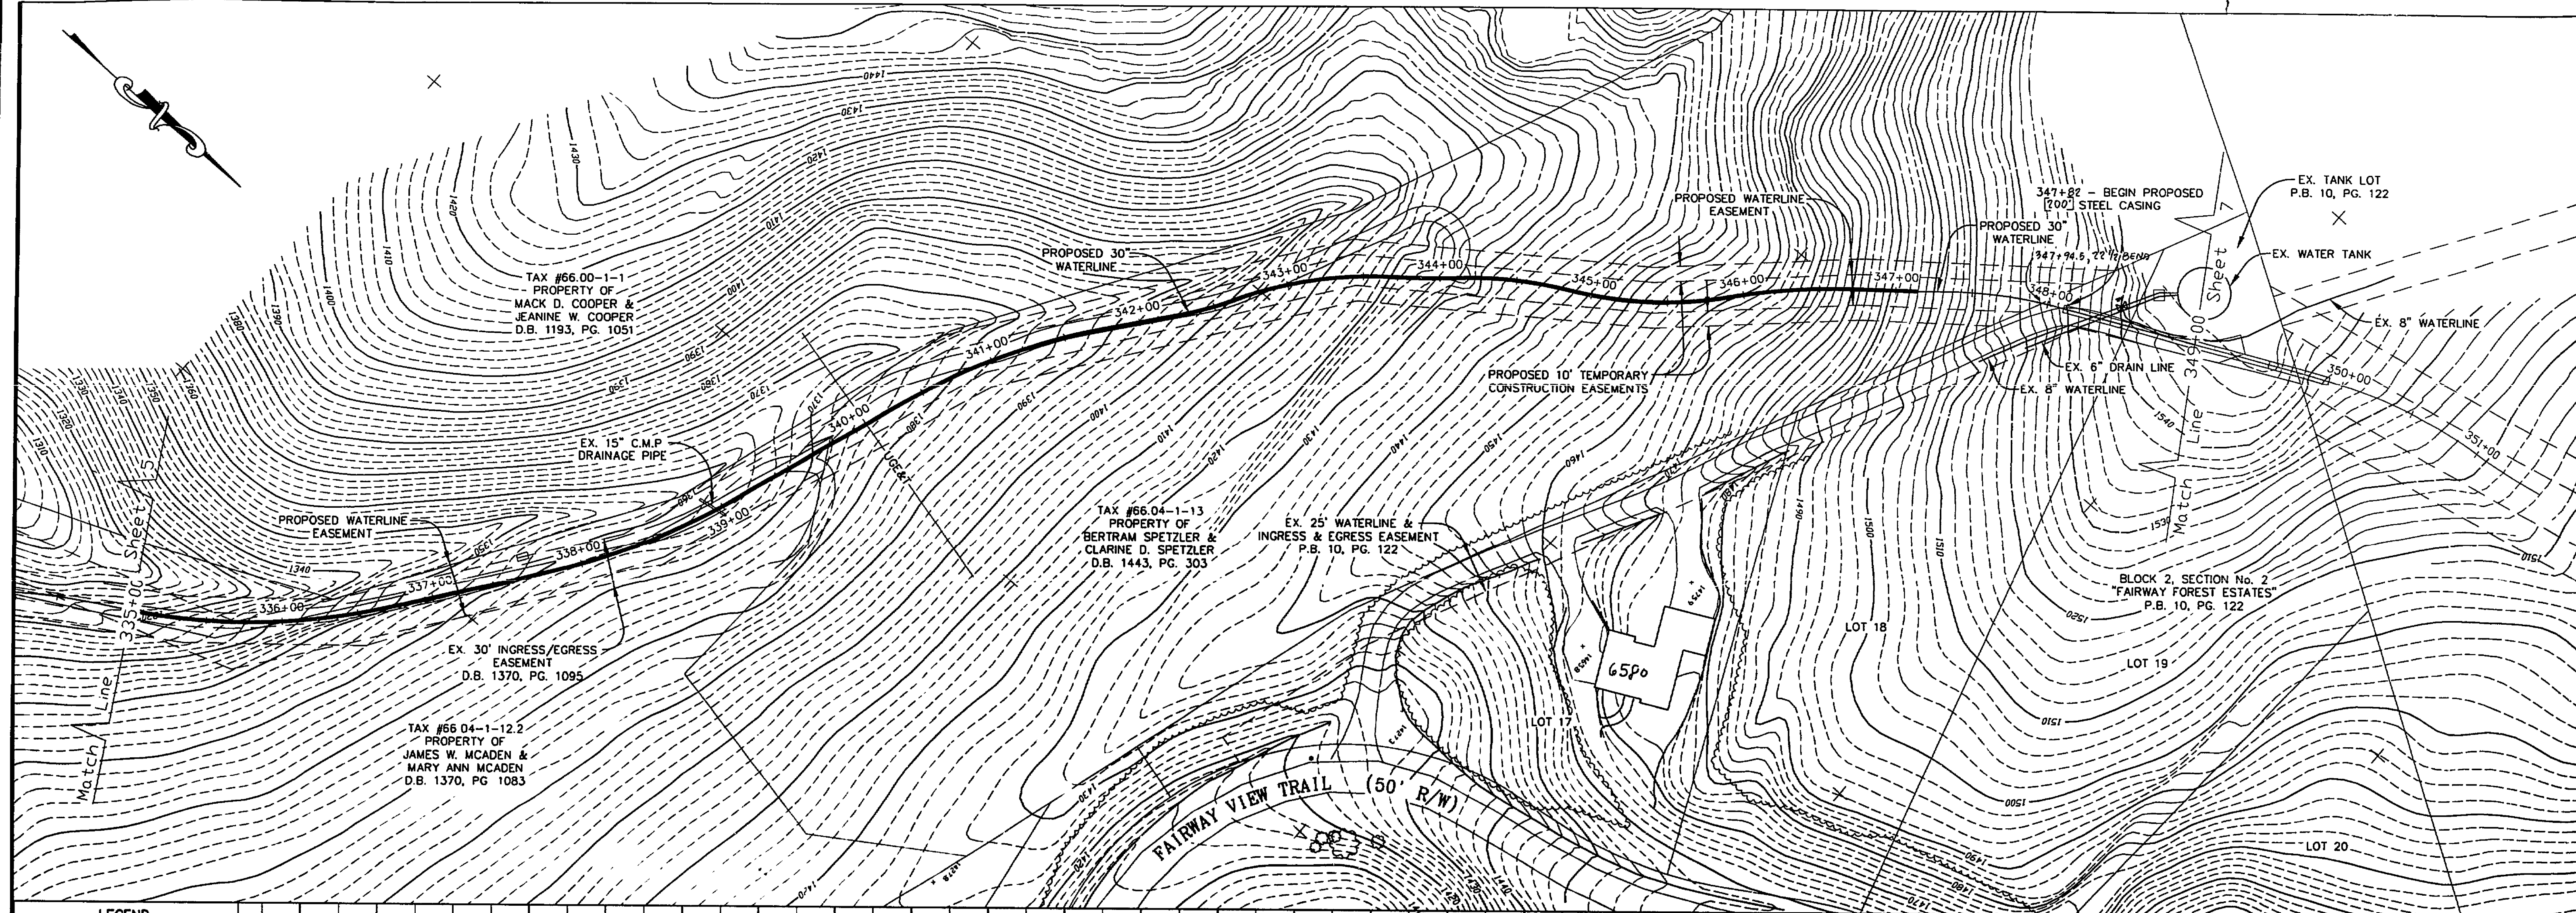


LEGEND

--- 24\"/>

REVISION DESIGNED - PAM DRAWN - PAM CHECKED - MSW	DATE 11/13/96 11/13/96 11/13/96 11/13/96	A3-BUILT DESCRIPTION PLAN & PROFILE FOR PHASE No. 3 SOUTH LOOP TRANSMISSION MAIN PREPARED FOR ROANOKE COUNTY UTILITY DEPARTMENT CAVE SPRING, WINDSOR HILLS, & CATAWBA MAGISTERIAL DISTRICTS ROANOKE COUNTY, VIRGINIA
--	--	--

SCALE: 1" = 50' (HORIZ.)
 SCALE: 1" = 10' (VERT.)
 DATE: 12/30/94
 SHEET 6 of 11

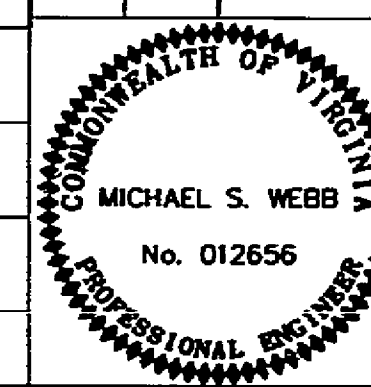

LUMSDEN ASSOCIATES, P.C.
 ENGINEERS-SURVEYORS-PLANNERS
 ROANOKE, VIRGINIA