

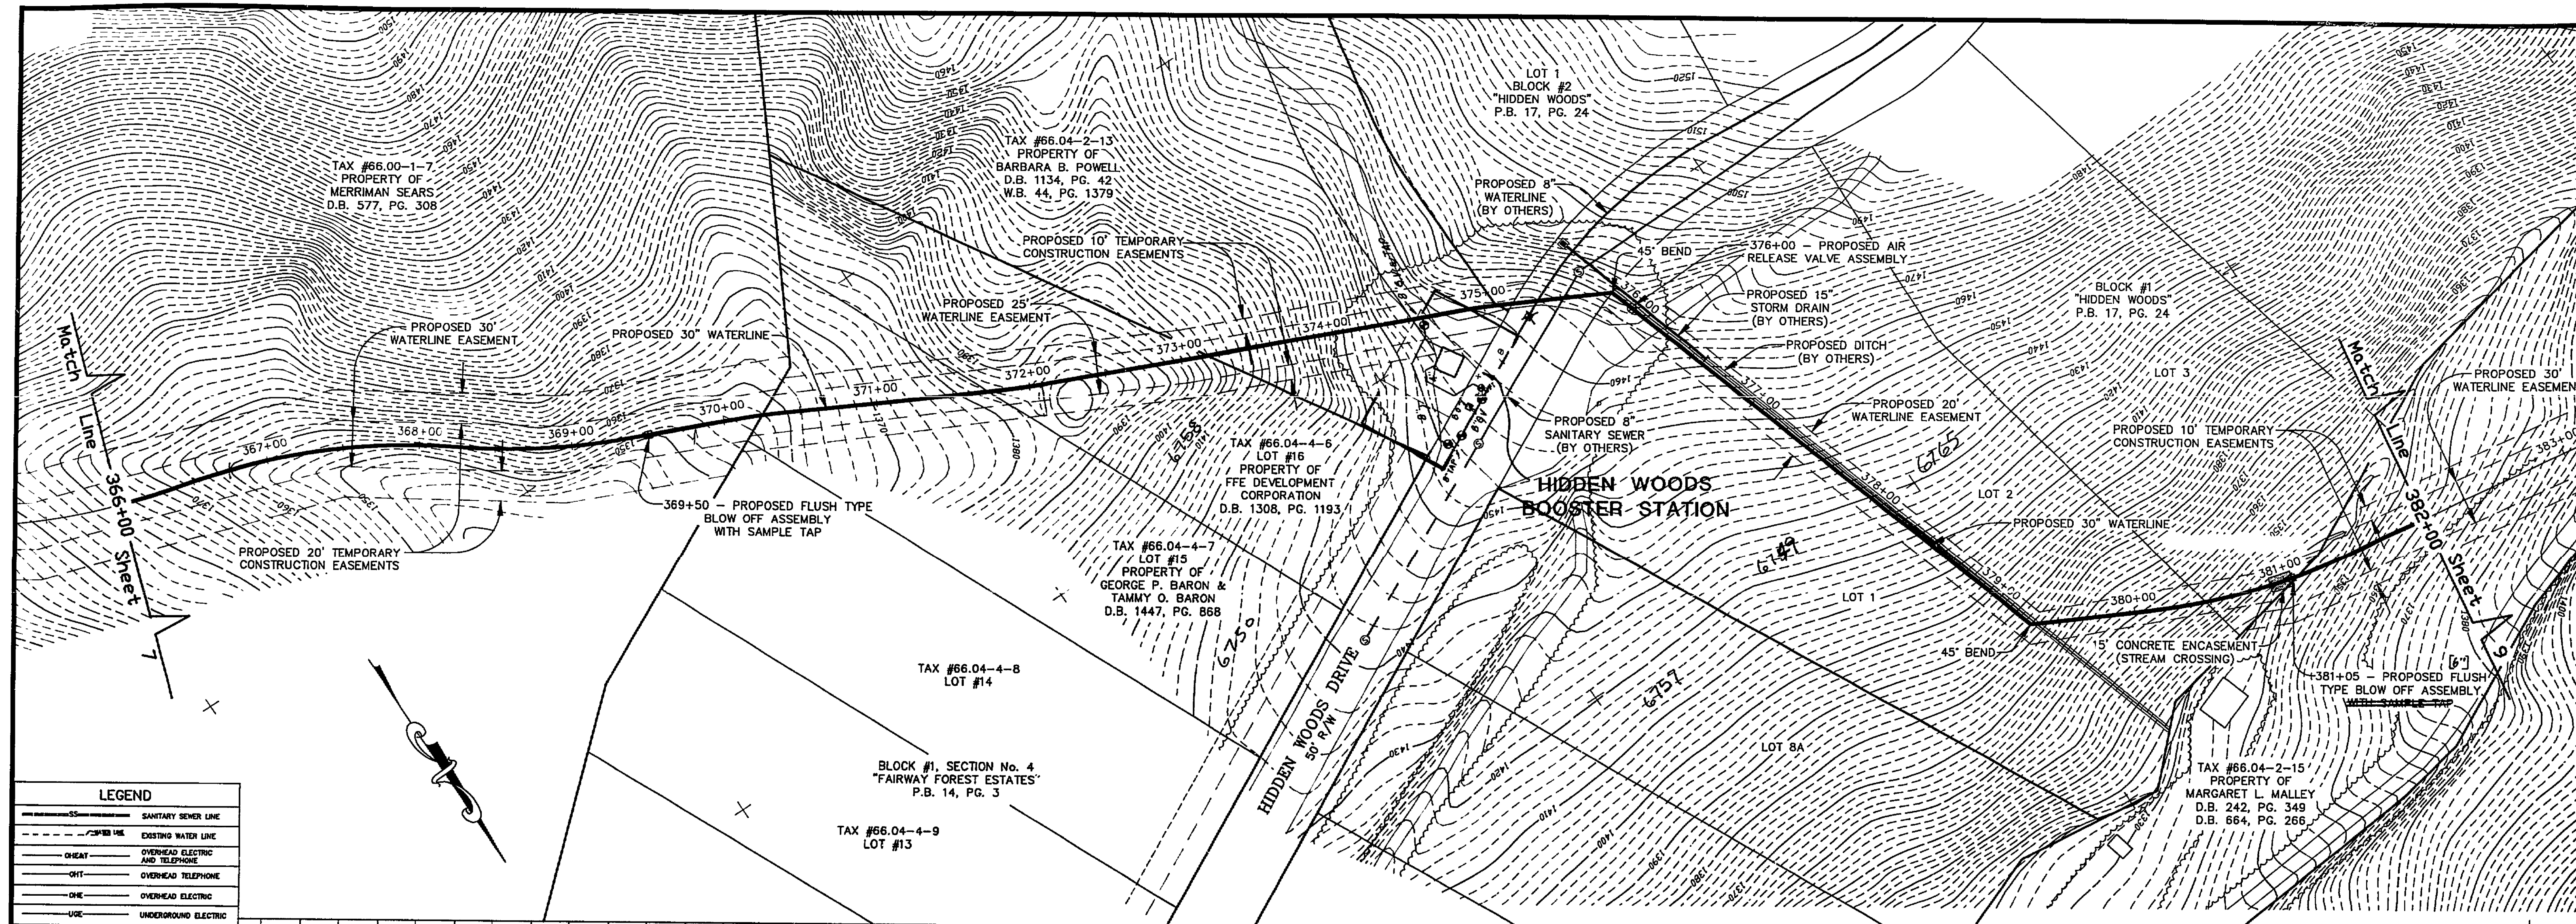


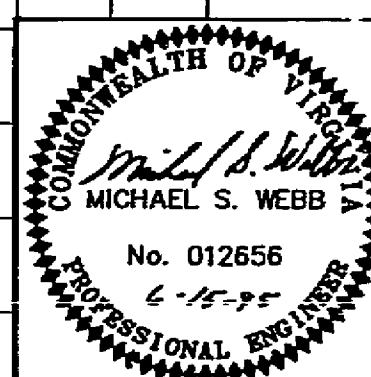

LEGEND	
	SANITARY SEWER LINE
	EXISTING WATER LINE
	OVERHEAD ELECTRIC AND TELEPHONE
	OVERHEAD ELECTRIC
	OVERHEAD TELEPHONE
	UNDERGROUND ELECTRIC
	UNDERGROUND GAS
	UNDERGROUND TELEPHONE
	STORM PIPE
	DROP INLET
	GUARD RAIL
	FENCE
	UTILITY POLE
	PROP. WATER
	BUTTERFLY VALVE
	AIR RELEASE VALVE ASSEMBLY
	BLOW-OFF ASSEMBLY
	TREE LINE
	SHRUB
	TREE
	SPOT ELEVATION

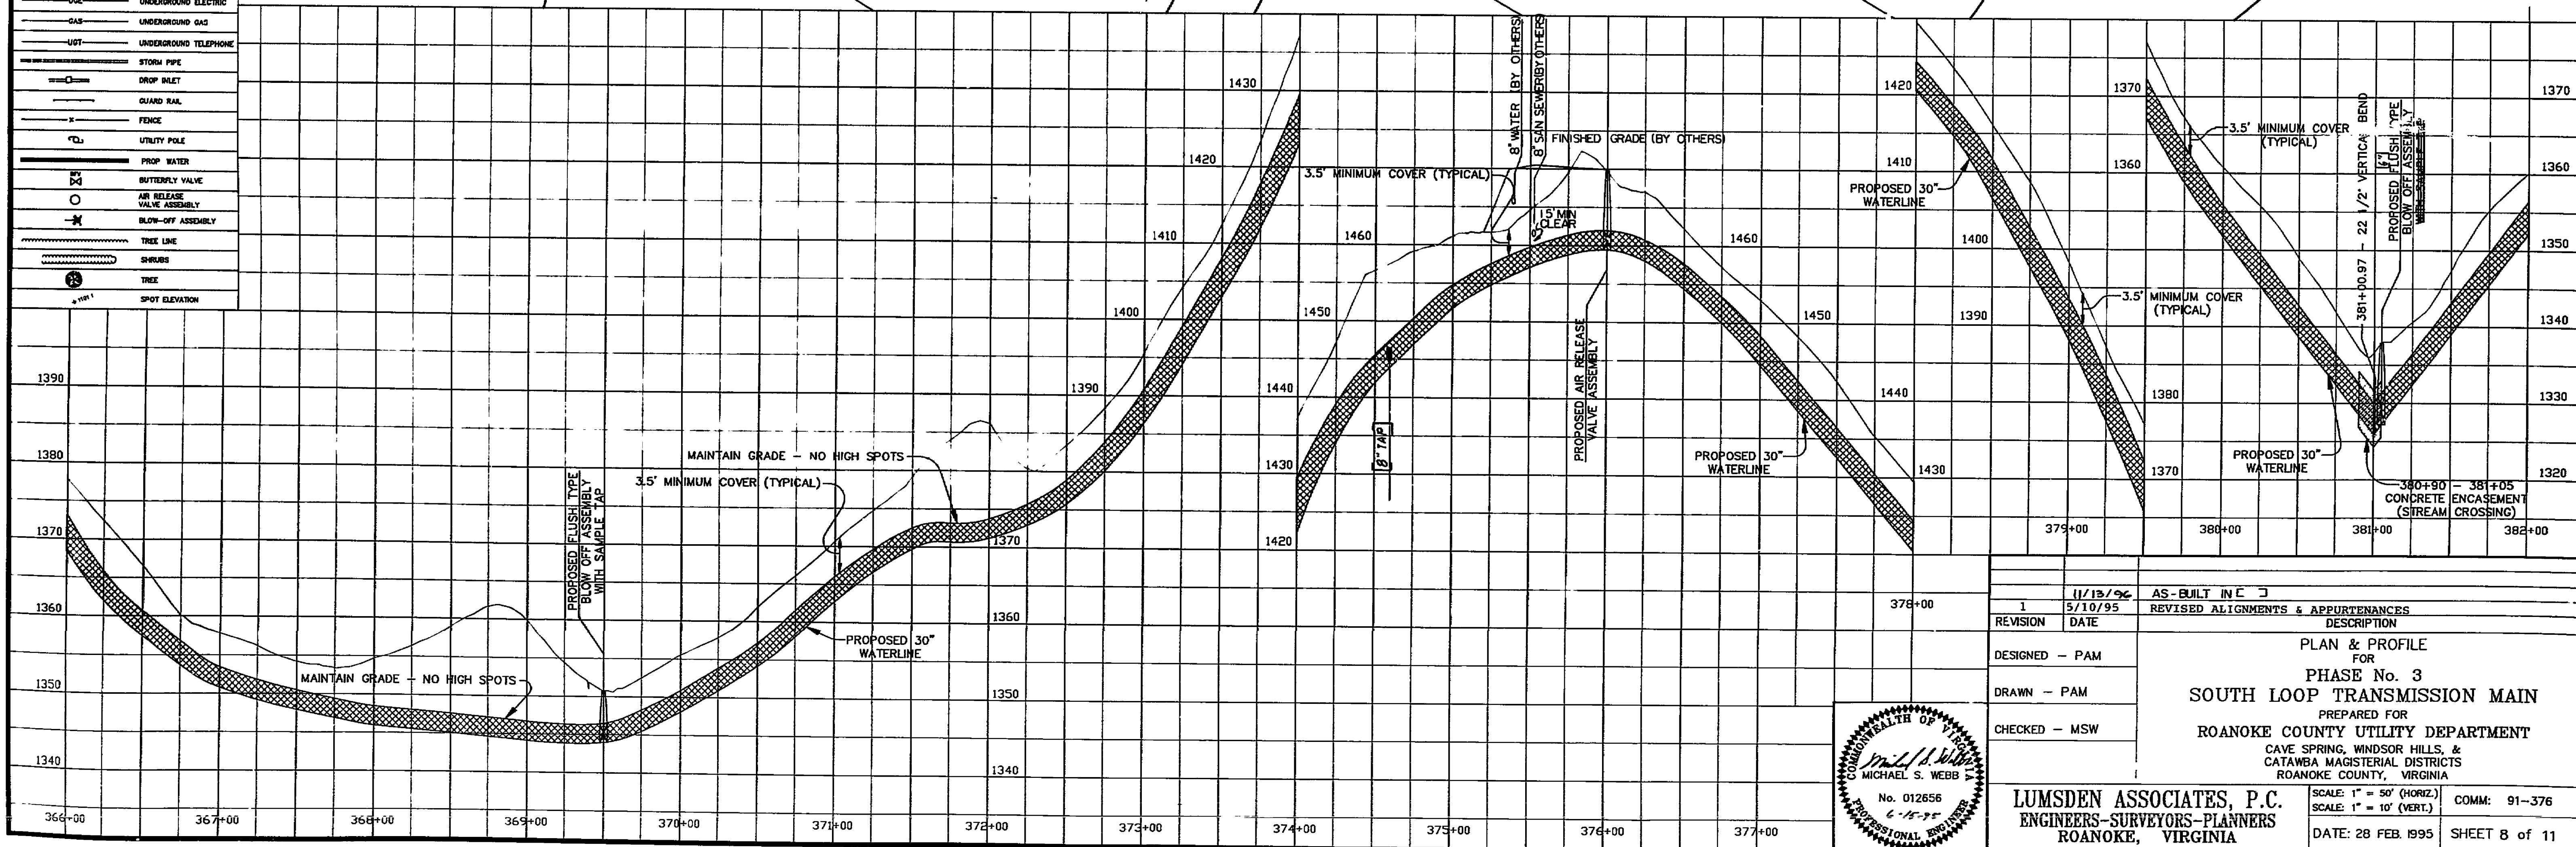

1	11/19/95	AS-BUILT IN C
REVISION	DATE	REVISIONS & APPURTENANCES
DESIGNED - PAM		DESCRIPTION
DRAWN - PAM		PLAN & PROFILE FOR
CHECKED - MSW		PHASE No. 3
		SOUTH LOOP TRANSMISSION MAIN
		PREPARED FOR
		ROANOKE COUNTY UTILITY DEPARTMENT
		CAVE SPRING, WINDSOR HILLS, & CATAWBA MAGISTERIAL DISTRICTS
		ROANOKE COUNTY, VIRGINIA
		SCALE: 1" = 50' (HORIZ.)
		SCALE: 1" = 10' (VERT.)
		DATE: 28 FEB 1995
		SHEET 8 of 11

WT-0493