

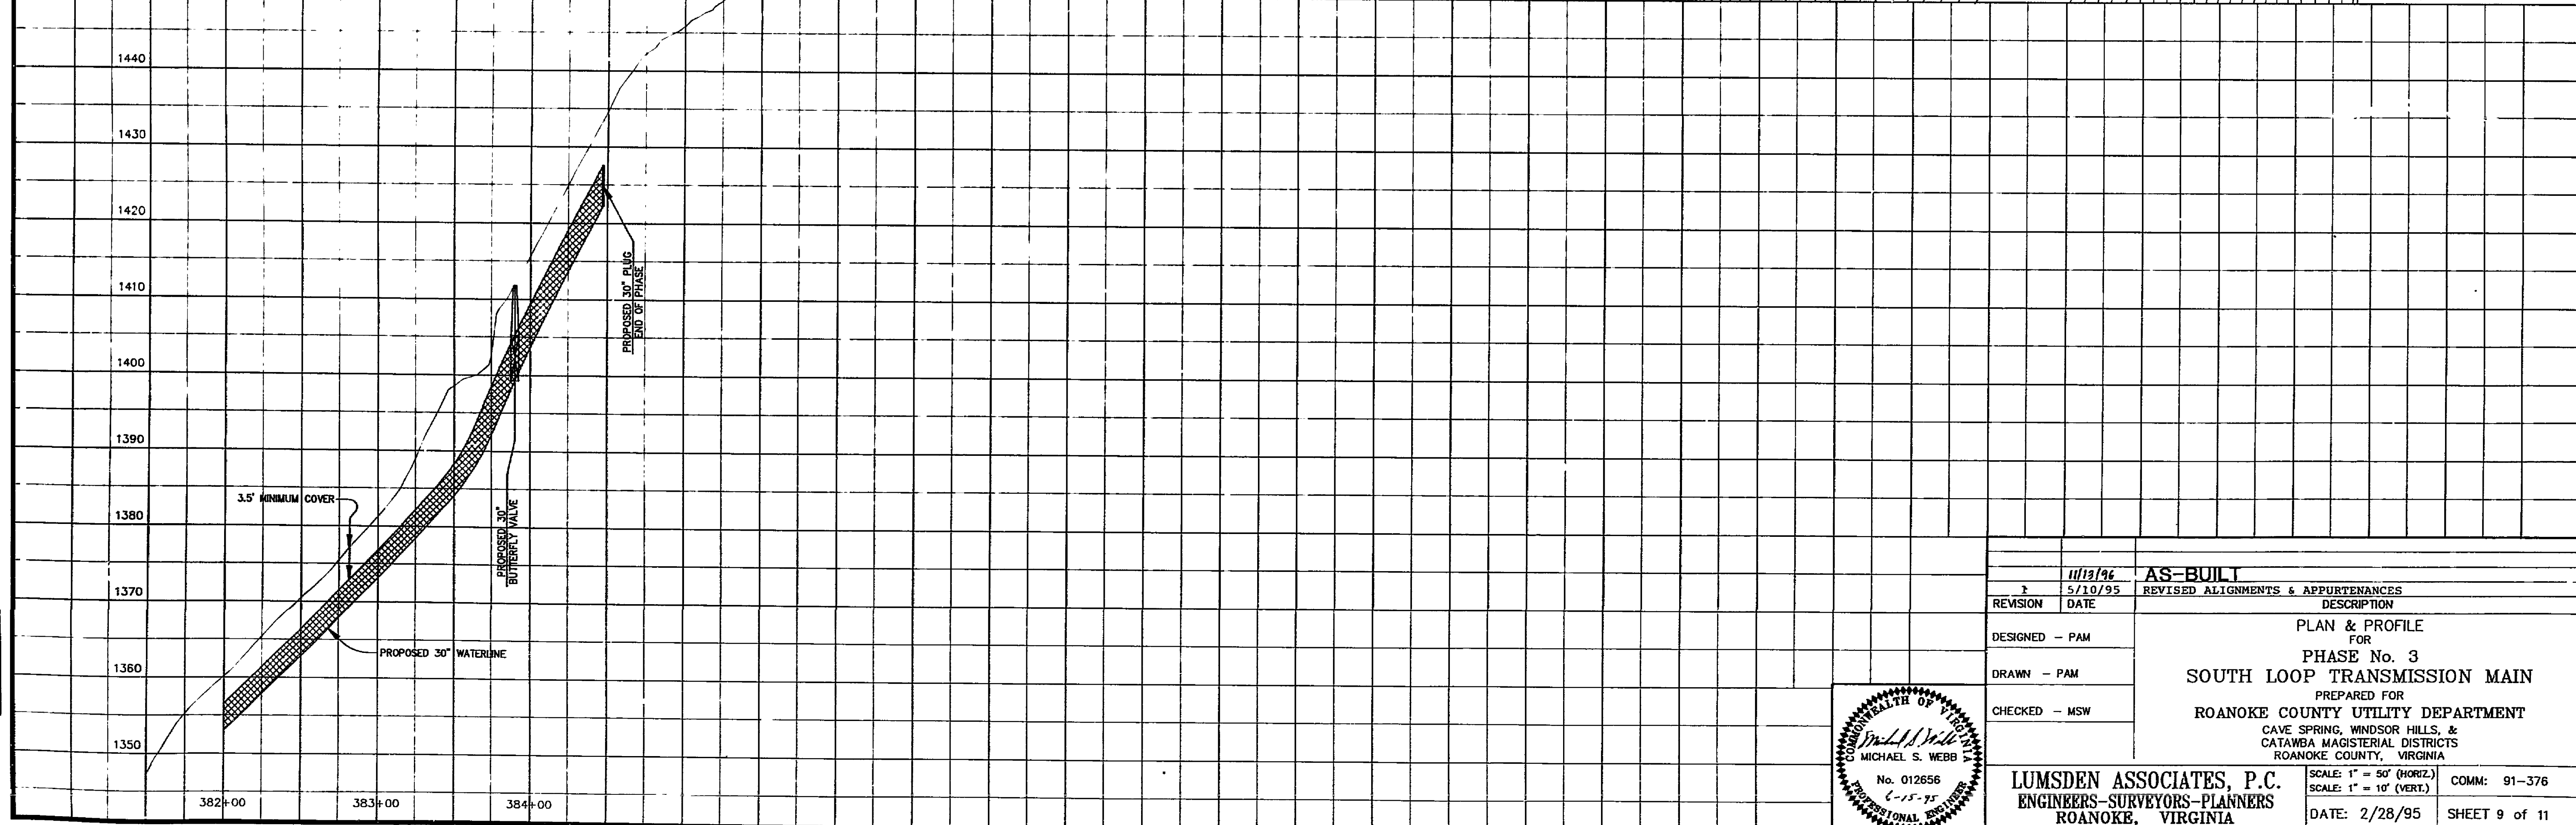


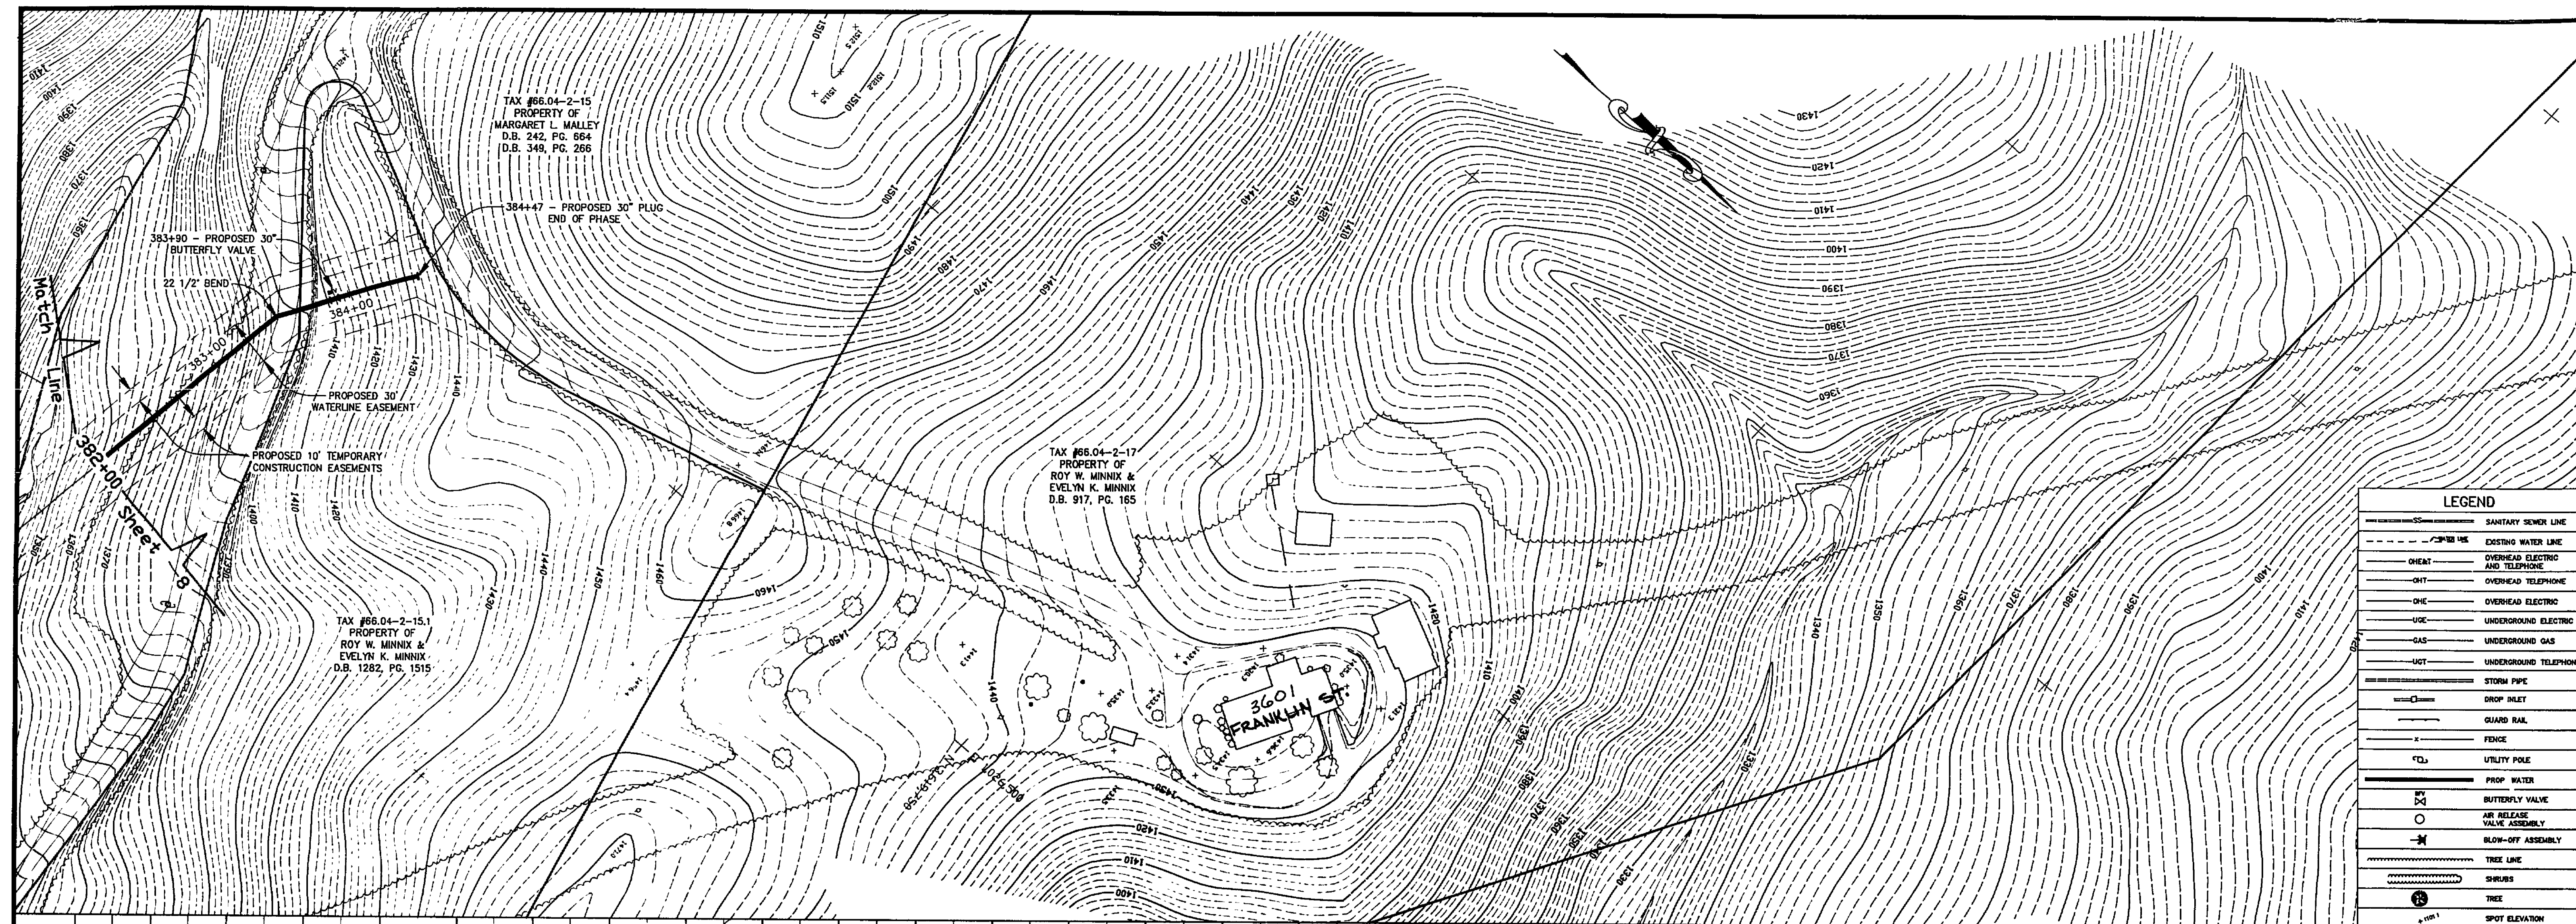

LEGEND	
—	SANITARY SEWER LINE
—	EXISTING WATER LINE
—	OVERHEAD ELECTRIC AND TELEPHONE
—	OVERHEAD TELEPHONE
—	OVERHEAD ELECTRIC
—	UNDERGROUND ELECTRIC
—	UNDERGROUND GAS
—	UNDERGROUND TELEPHONE
—	STORM PIPE
—	DROP INLET
—	GUARD RAIL
—	FENCE
—	UTILITY POLE
—	PROP. WATER
—	BUTTERFLY VALVE
—	AIR RELEASE VALVE ASSEMBLY
—	BLOW-OFF ASSEMBLY
—	TREE LINE
—	SHRUBS
—	THICK
—	SPOT ELEVATION

11/13/96	AS-BUILT
5/10/95	REVISED ALIGNMENTS & APPURTENANCES
DESIGNED — PAM	DESCRIPTION
DRAWN — PAM	PLAN & PROFILE FOR
CHECKED — MSW	PHASE No. 3
	SOUTH LOOP TRANSMISSION MAIN
	PREPARED FOR
	ROANOKE COUNTY UTILITY DEPARTMENT
	CAVE SPRING, WINDSOR HILLS, &
	CATAWBA MAGISTERIAL DISTRICTS
	ROANOKE COUNTY, VIRGINIA
SCALE: 1" = 50' (HORIZ.)	COMM: 91-376
SCALE: 1" = 10' (VERT.)	
DATE: 2/28/95	SHEET 9 of 11

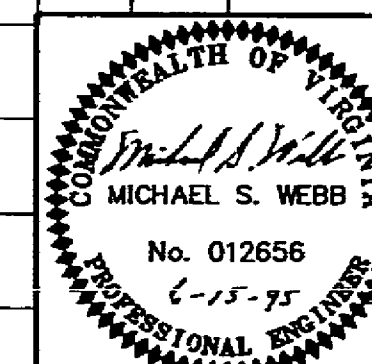

LUMSDEN ASSOCIATES, P.C.
ENGINEERS-SURVEYORS-PLANNERS
ROANOKE, VIRGINIA

WT-0494