


AS-BUILT
DEVELOPMENT PLAN
FOR
PHASE #4
SOUTH LOOP TRANSMISSION MAIN

SITUATED IN
CAVE SPRING, WINDSOR HILLS &
CATAWBA MAGISTERIAL DISTRICTS
ROANOKE COUNTY, VIRGINIA

DATE: 9 JULY 1996

PROPERTY OF
ROANOKE COUNTY UTILITY DEPARTMENT

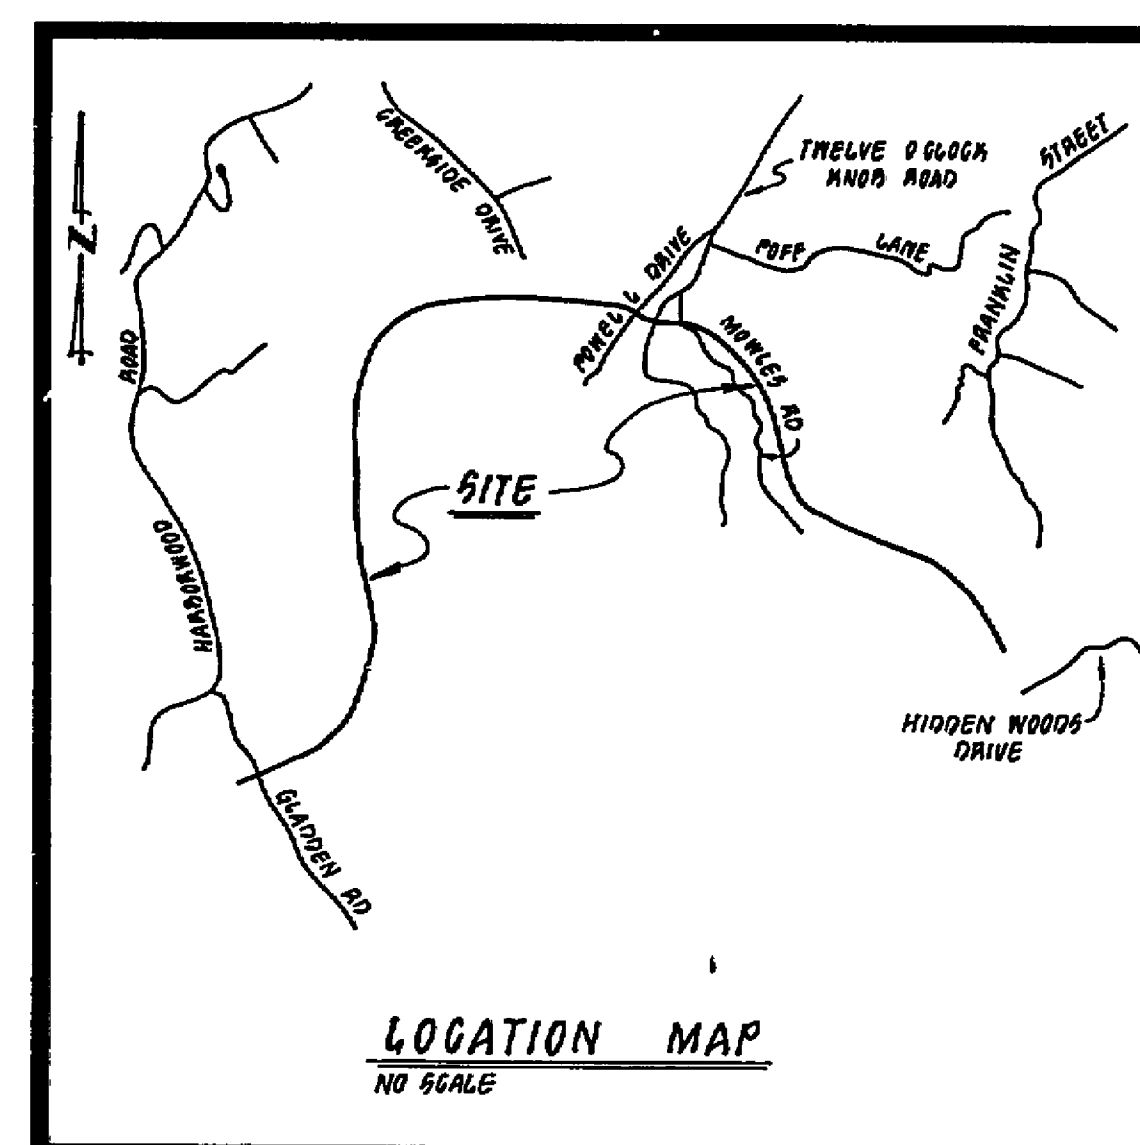

INDEX OF DRAWINGS

SHEET No.	DESCRIPTION
-----------	-------------

- | | |
|-------|---|
| 1. | LUMSDEN ASSOCIATES COVER SHEET |
| 2. | PLAN & PROFILE SHEET LAYOUT |
| 3-17. | PLAN & PROFILE |
| 18. | WATER DETAILS |
| 19. | ROANOKE CO. STD. EROSION CONTROL DETAIL SHEET |

LUMSDEN ASSOCIATES, P.C.
ENGINEERS-SURVEYORS-PLANNERS
ROANOKE, VIRGINIA