
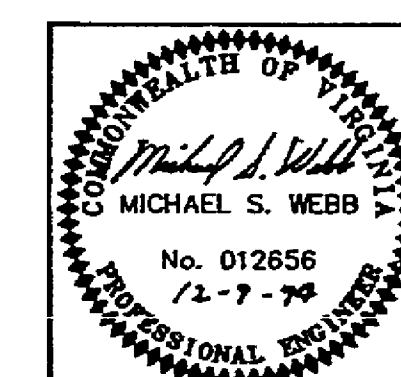


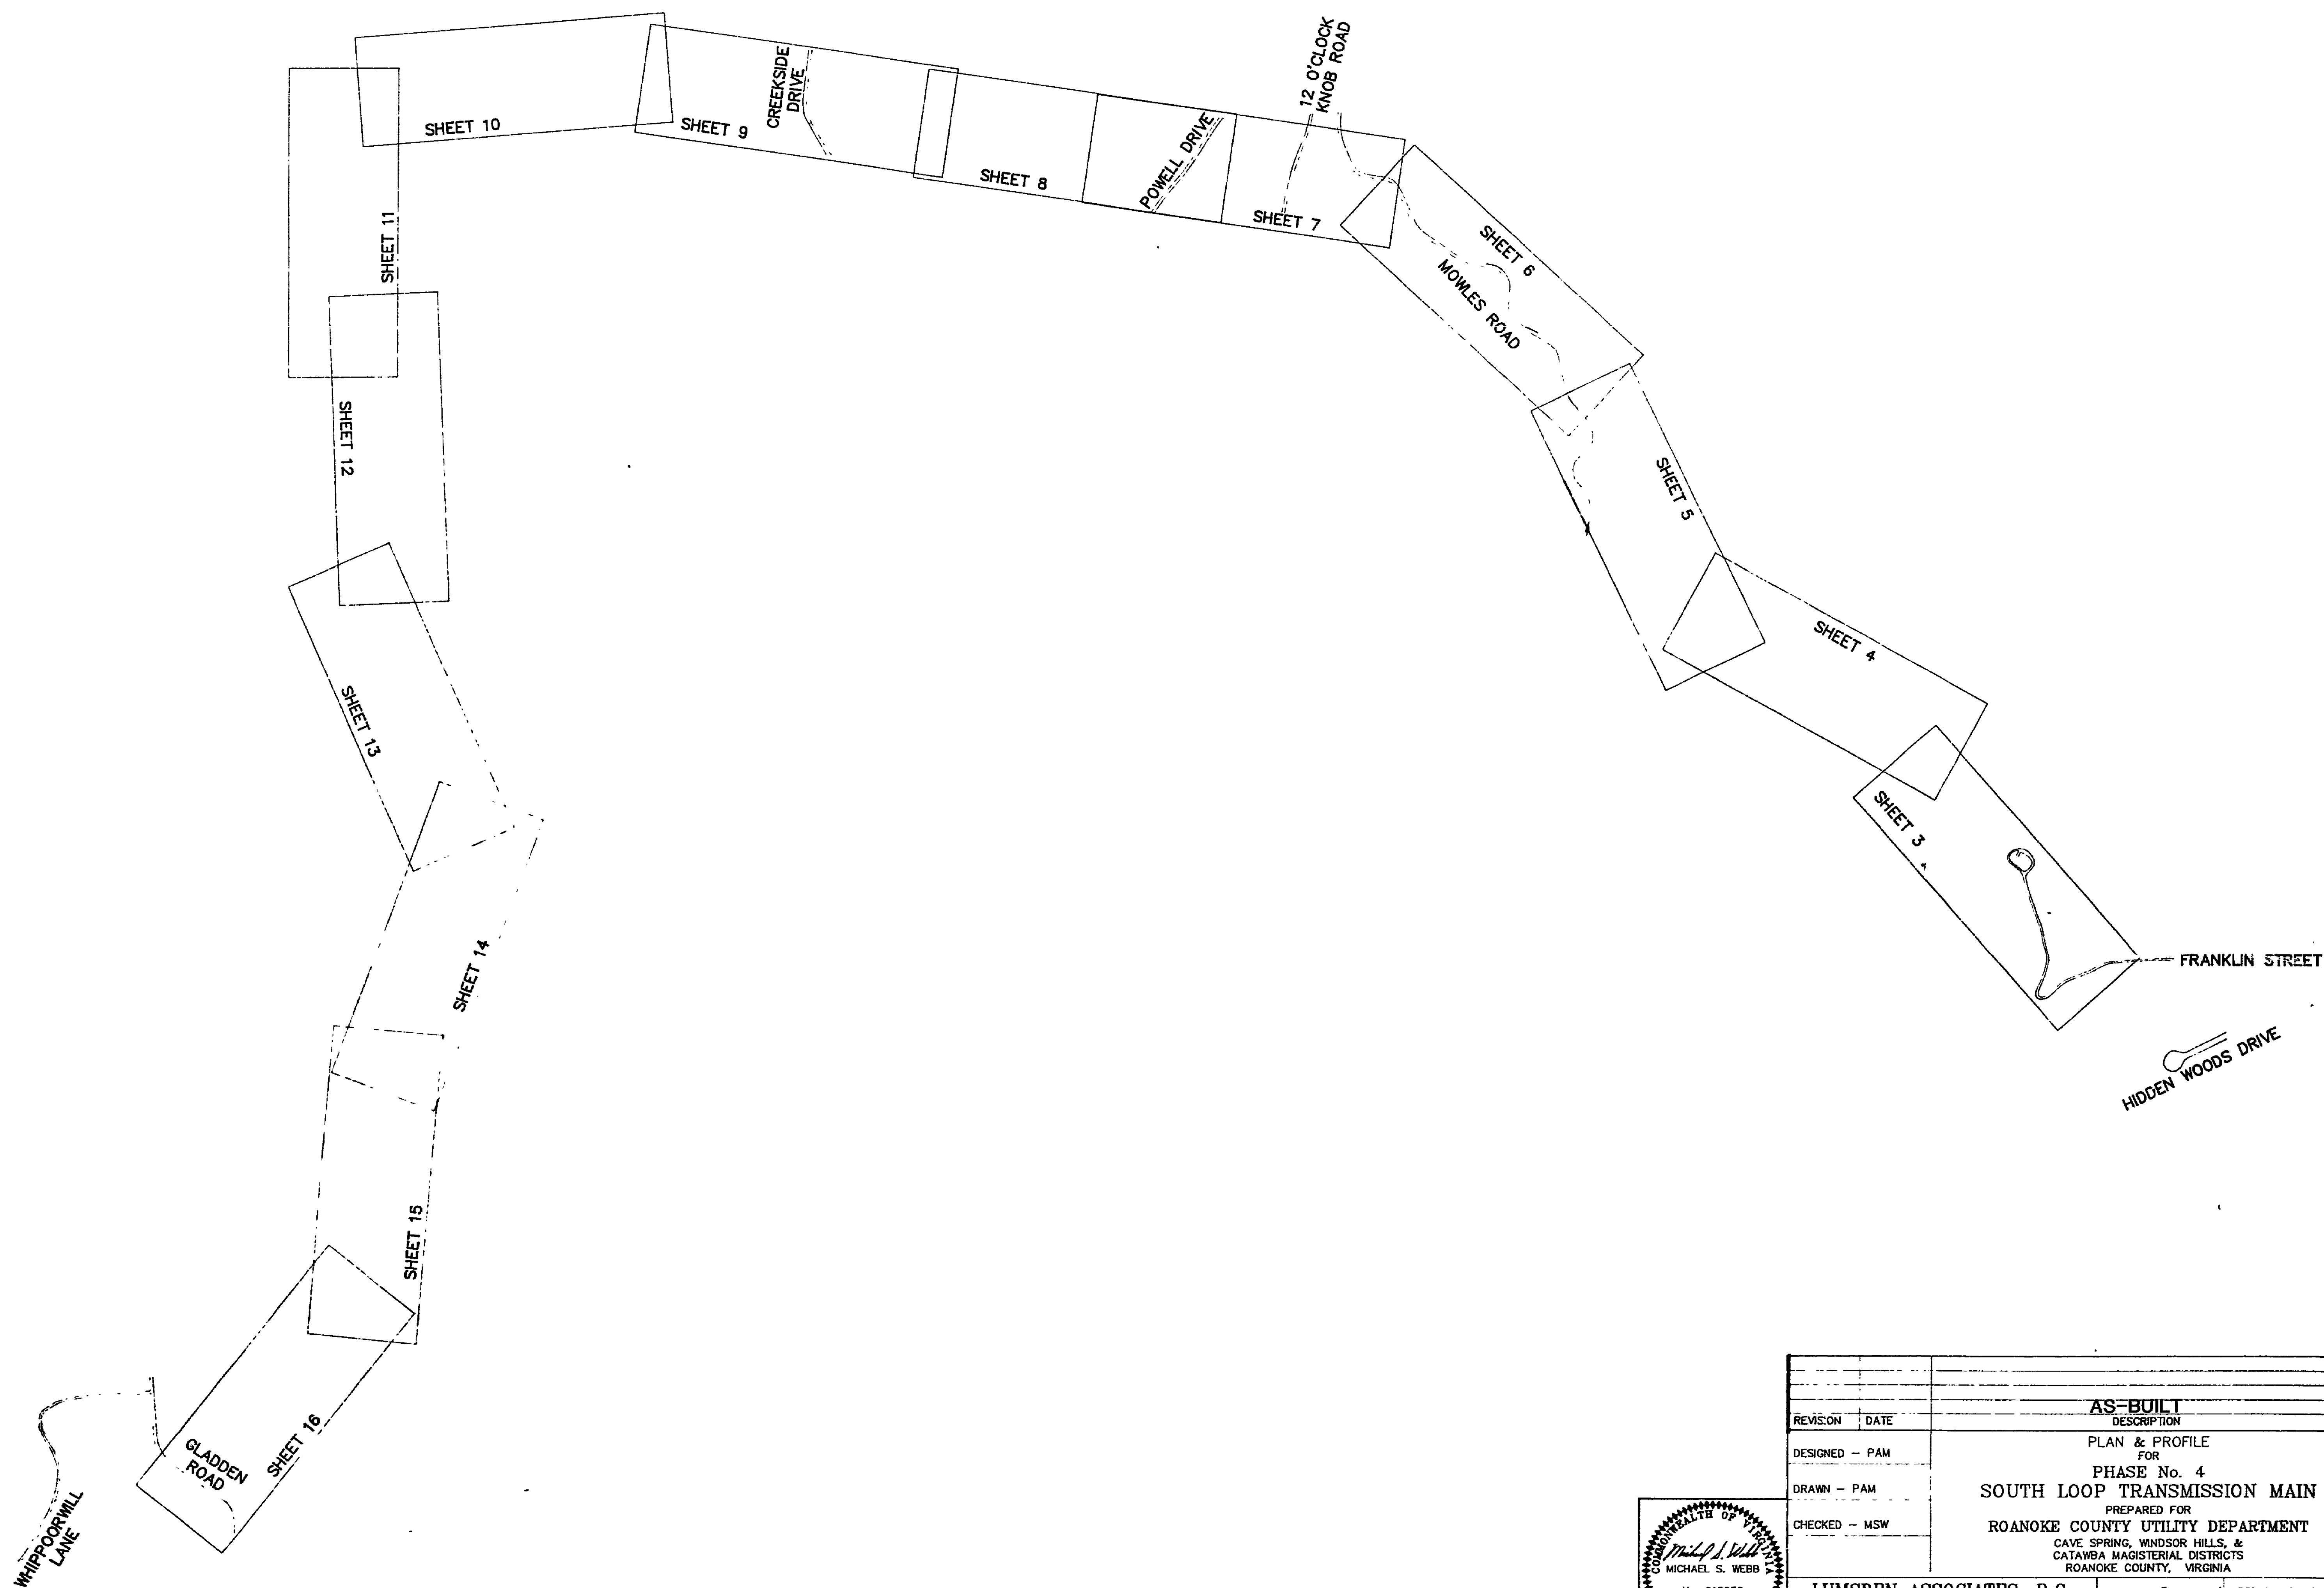

REVISION		DATE	DESCRIPTION
DESIGNED - PAM			AS-BUILT
DRAWN - PAM			PLAN & PROFILE
CHECKED - MSW			FOR
			PHASE No. 4
			SOUTH LOOP TRANSMISSION MAIN
			PREPARED FOR
			ROANOKE COUNTY UTILITY DEPARTMENT
			CAVE SPRING, WINDSOR HILLS, &
			CATAWBA MAGISTERIAL DISTRICTS
			ROANOKE COUNTY, VIRGINIA
LUMSDEN ASSOCIATES, P.C.		SCALE: 1" = 400'	COMM: 91-376
ENGINEERS-SURVEYORS-PLANNERS		DATE: 7/9/96	SHEET 2 of 19
ROANOKE, VIRGINIA			

WT-0497