
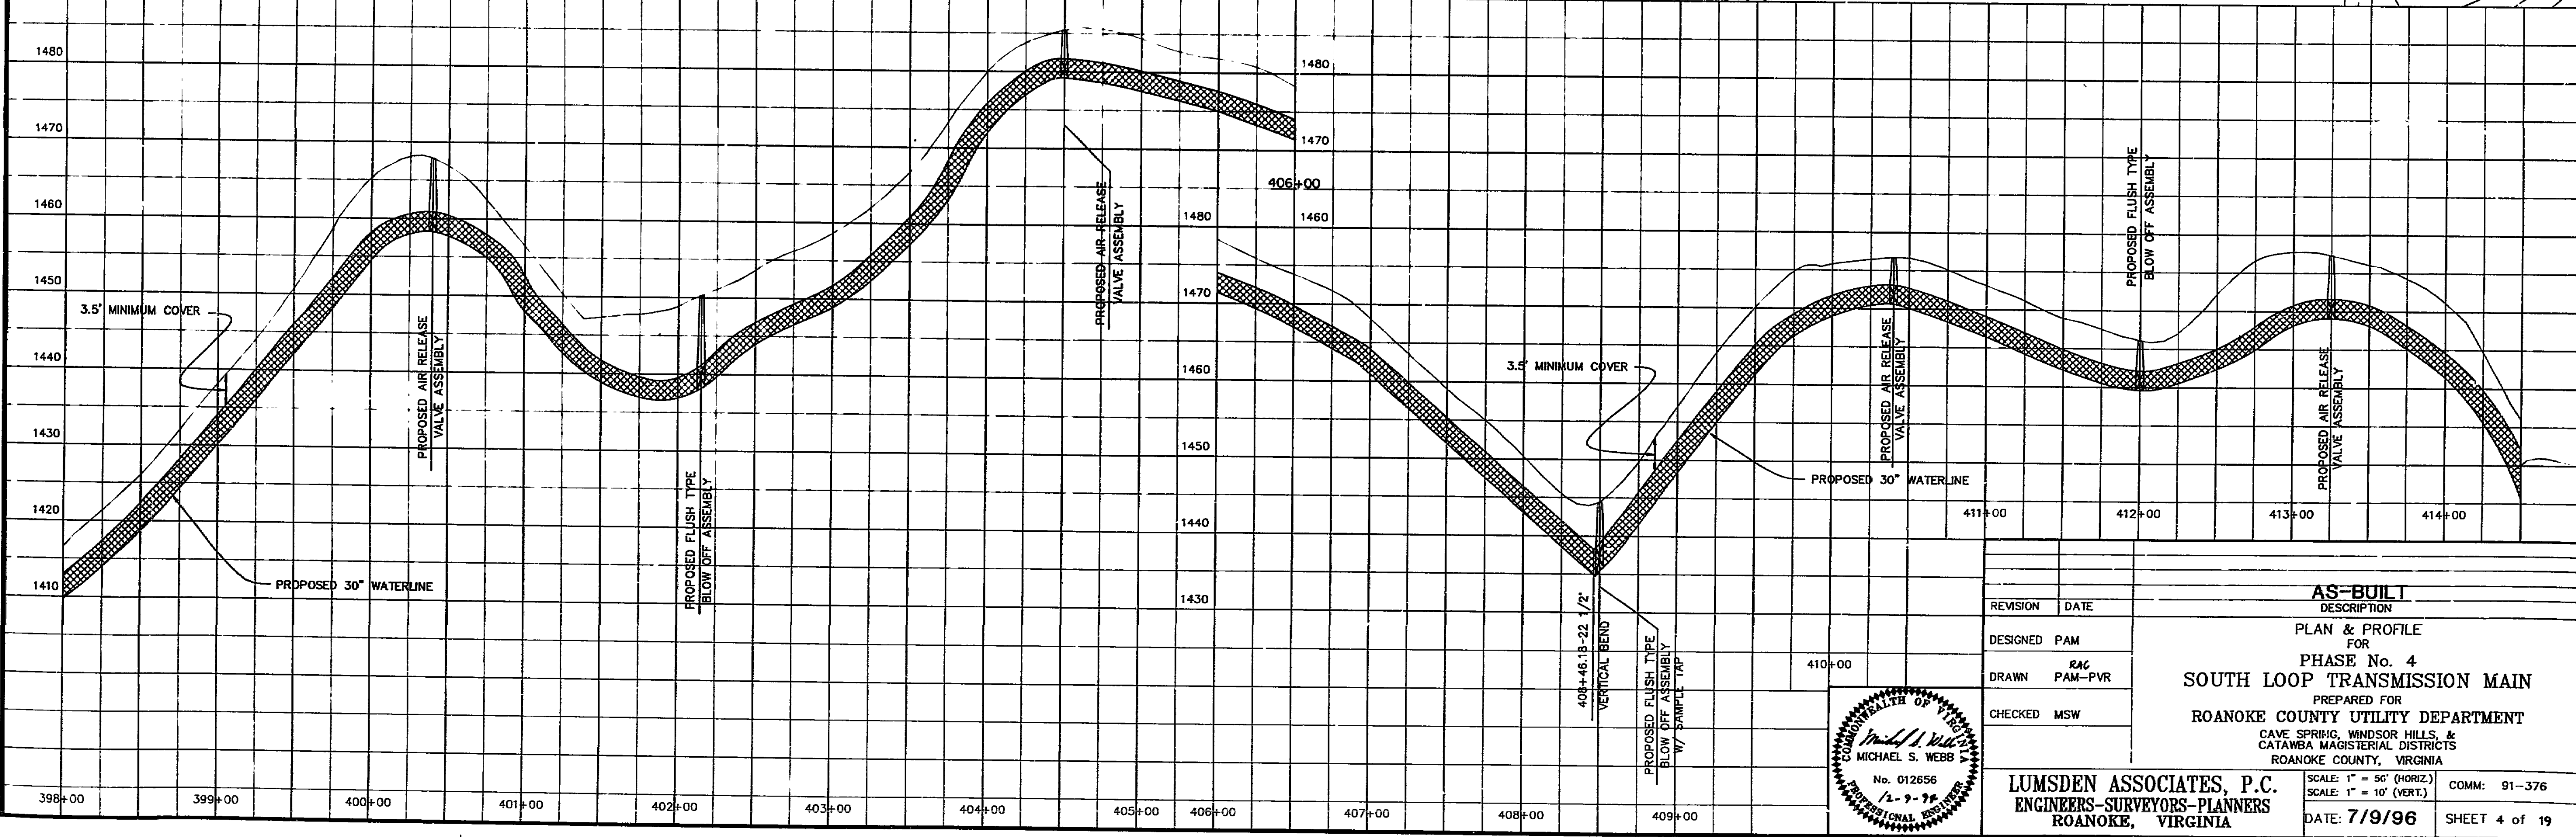


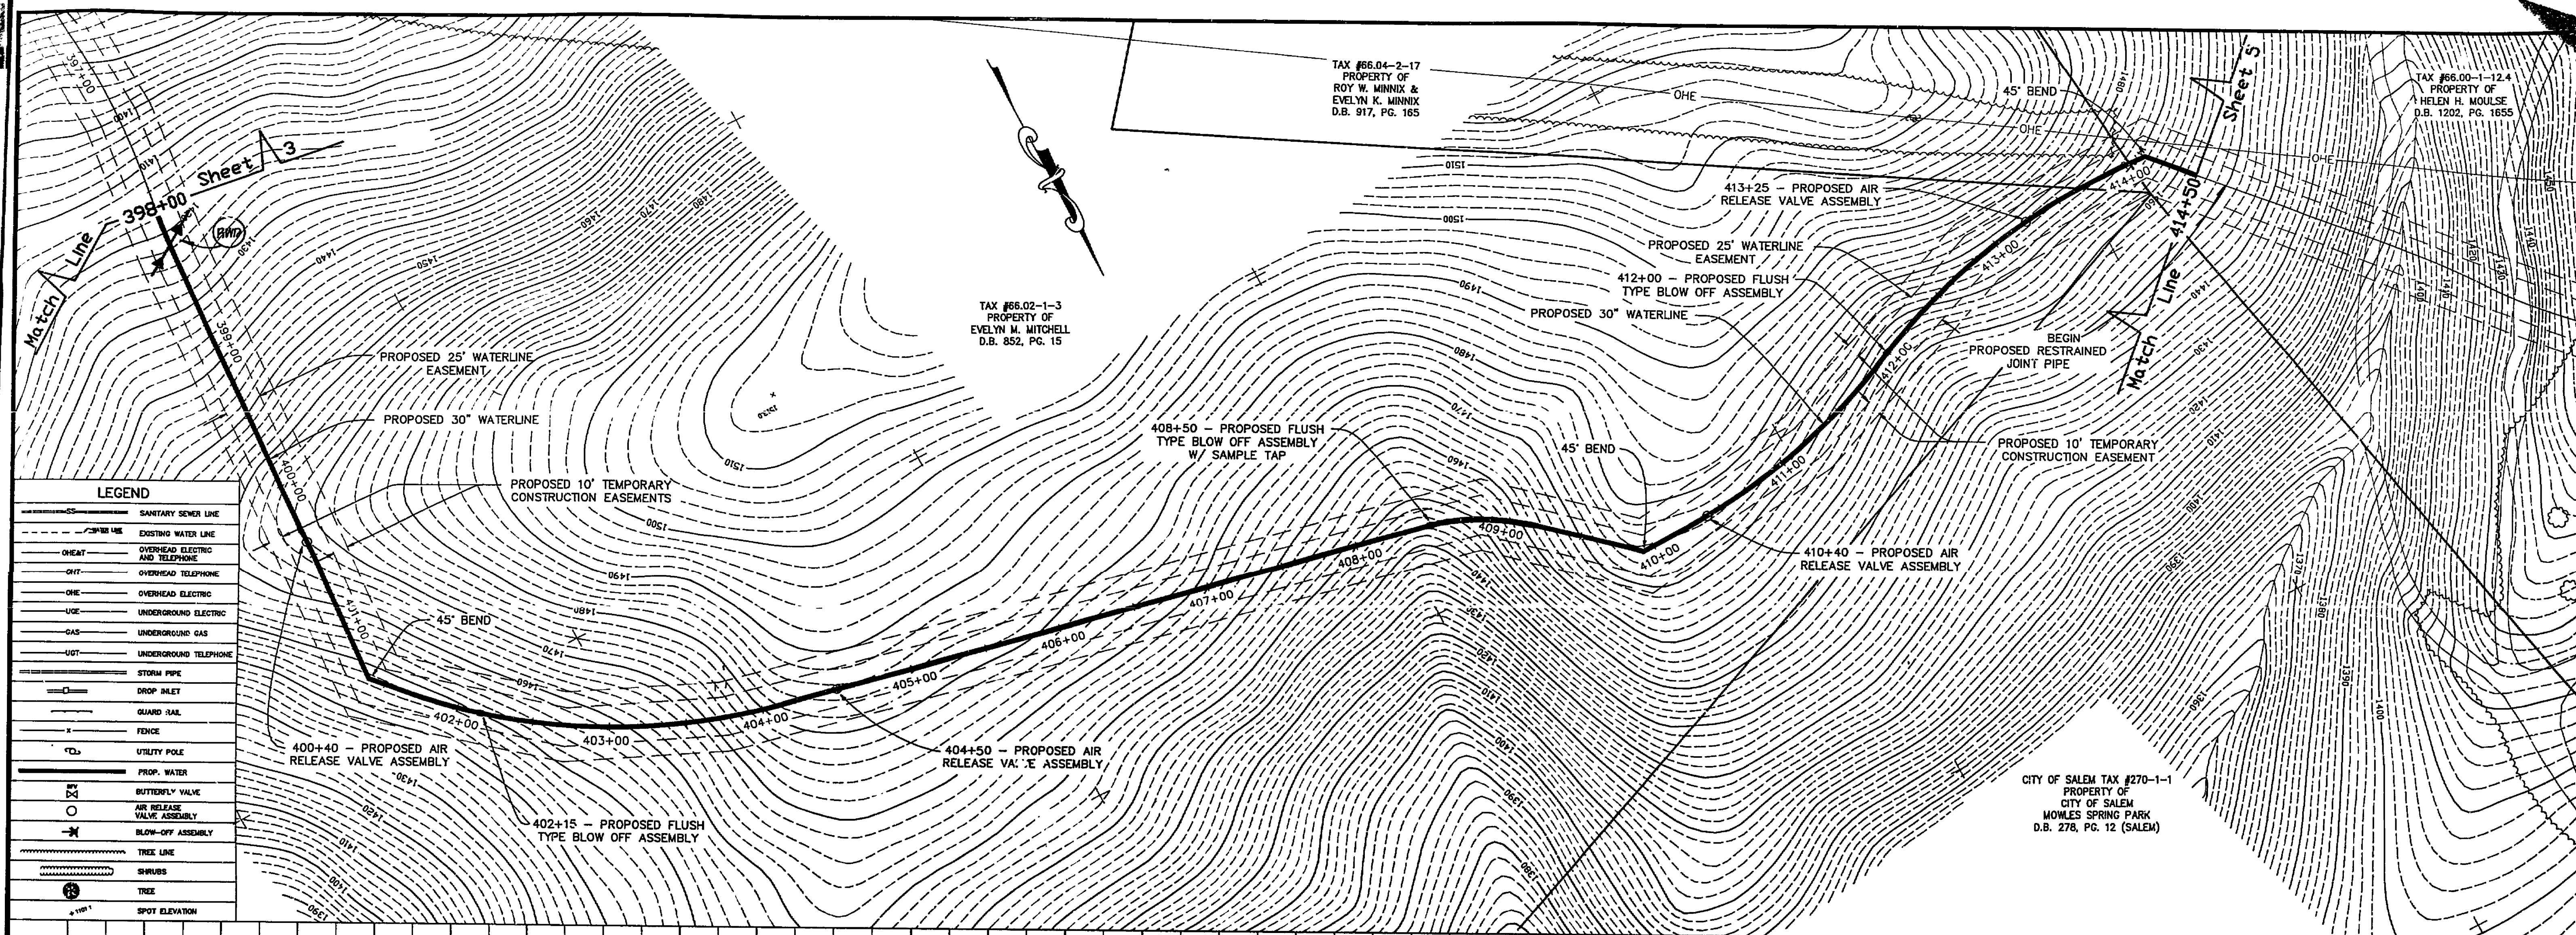

AS-BUILT		DESCRIPTION	
REVISION	DATE	PLAN & PROFILE FOR PHASE No. 4 SOUTH LOOP TRANSMISSION MAIN PREPARED FOR ROANOKE COUNTY UTILITY DEPARTMENT CAVE SPRING, WINDSOR HILLS, & CATAMBA MAGISTERIAL DISTRICTS ROANOKE COUNTY, VIRGINIA	
DESIGNED	PAM		
DRAWN	RAC PAM-PVR		
CHECKED	MSW		
LUMSDEN ASSOCIATES, P.C. ENGINEERS-SURVEYORS-PLANNERS ROANOKE, VIRGINIA		SCALE: 1" = 50' (HORIZ.) SCALE: 1" = 10' (VERT.) DATE: 7/9/96	COMM: 91-376 SHEET 4 of 19

WT-0499