

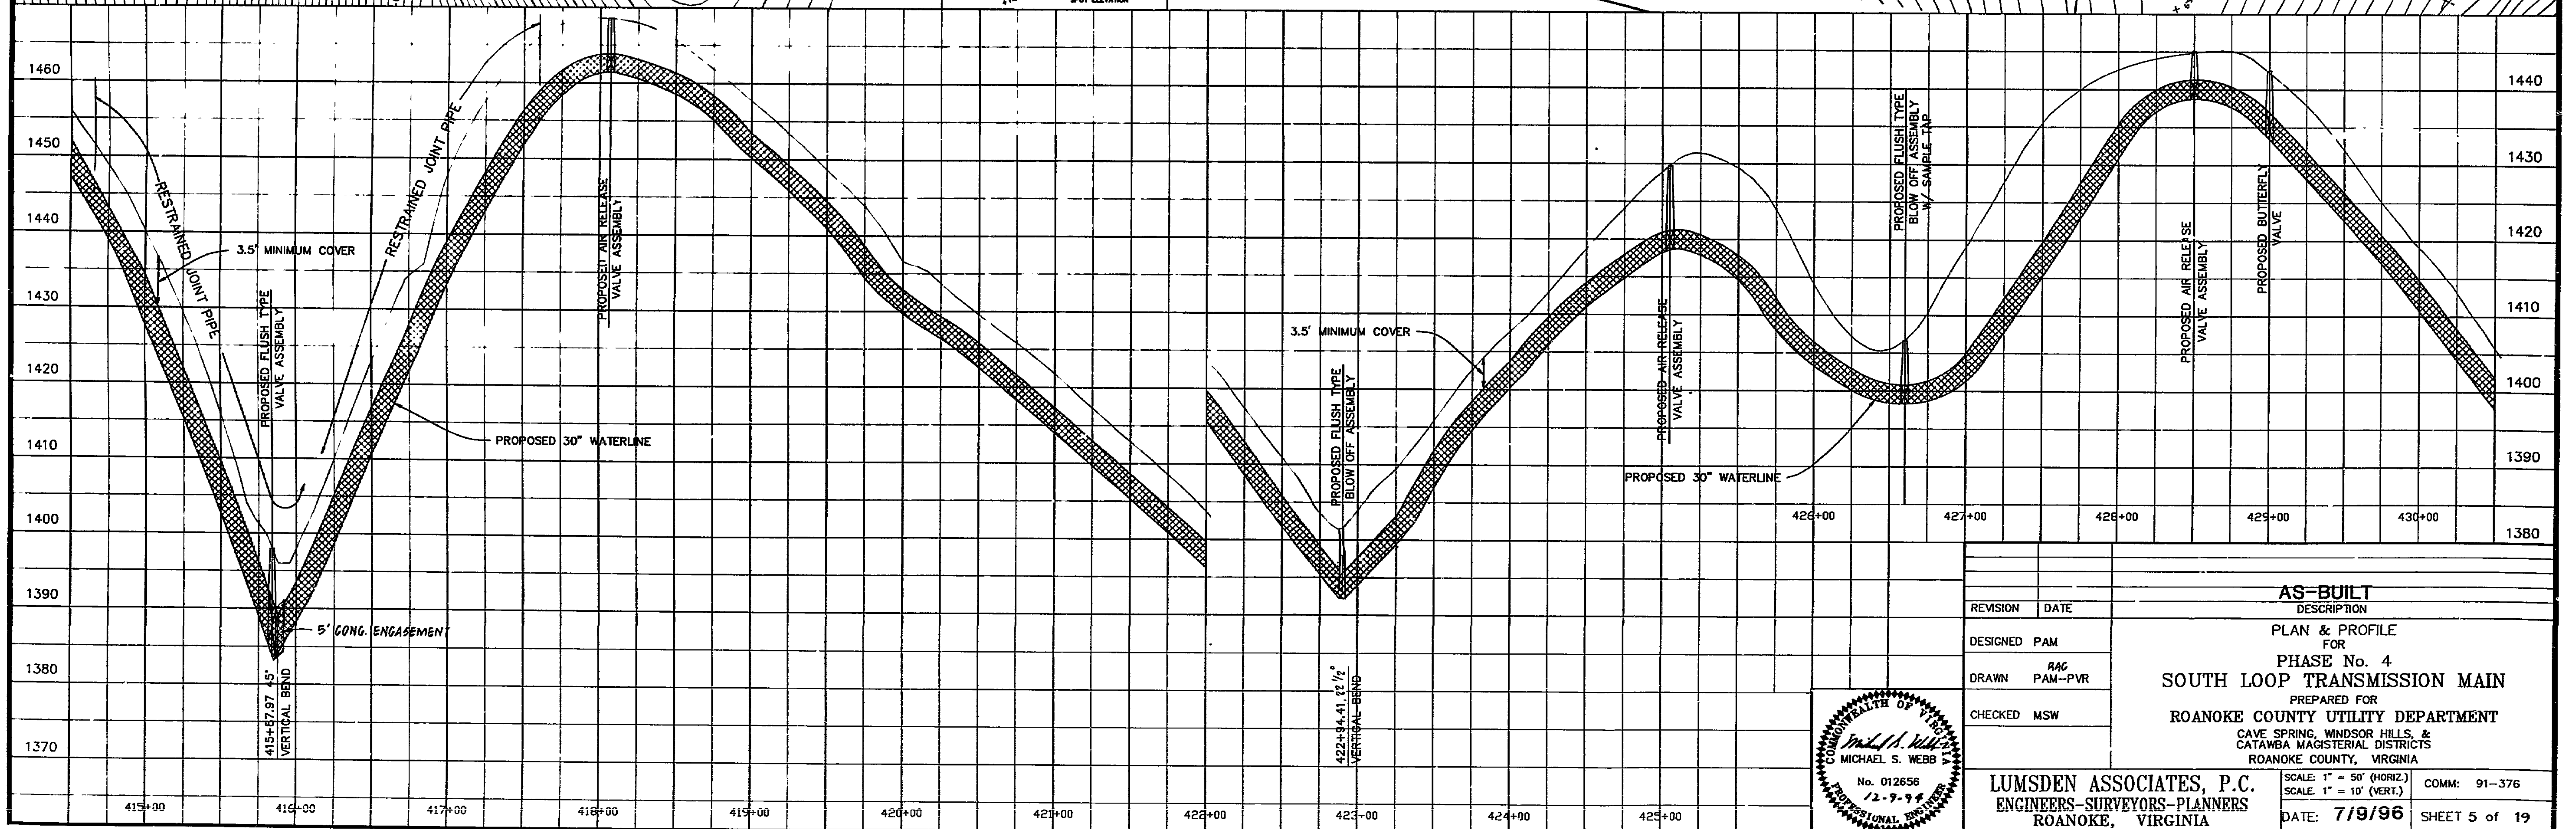


NOTE: CONTRACTOR TO MAINTAIN ACCESS
ACROSS EXISTING DRIVES.

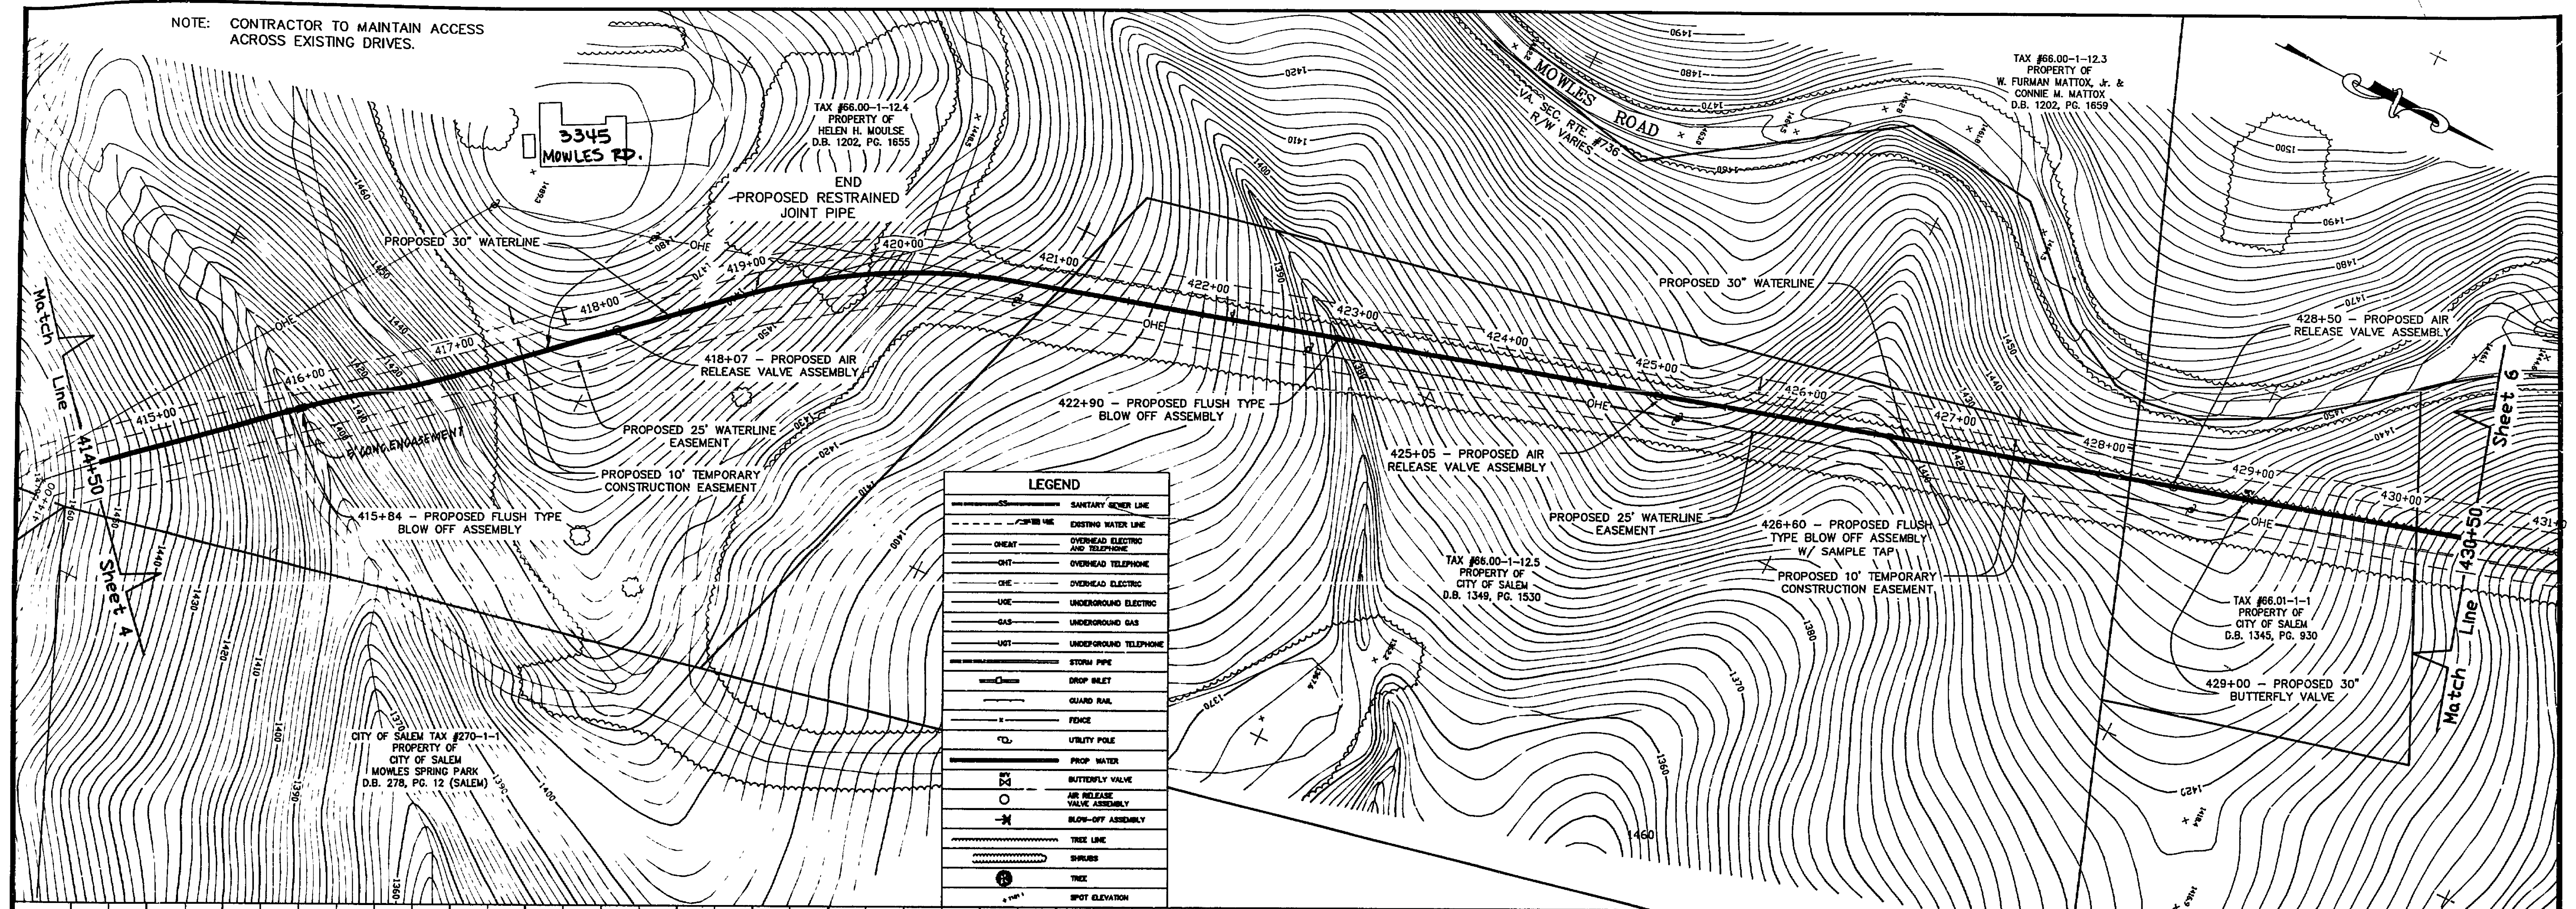

AS-BUILT	
DESCRIPTION	
PLAN & PROFILE	
FOR	
PHASE No. 4	
SOUTH LOOP TRANSMISSION MAIN	
PREPARED FOR	
ROANOKE COUNTY UTILITY DEPARTMENT	
CAVE SPRING, WINDSOR HILLS &	
CATAWBA MAGISTERIAL DISTRICTS	
ROANOKE COUNTY, VIRGINIA	
DESIGNED	PAM
DRAWN	RAC PAM-PVR
CHECKED	MSW
LUMSDEN ASSOCIATES, P.C.	
ENGINEERS-SURVEYORS-PLANNERS	
ROANOKE, VIRGINIA	
SCALE: 1" = 50' (HORIZ.)	COMM: 91-376
SCALE: 1" = 10' (VERT.)	DATE: 7/9/96
SHEET 5 of 19	

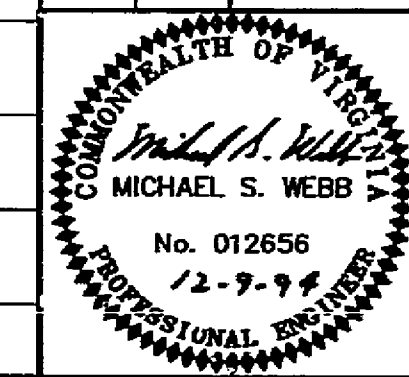

WT-0500