
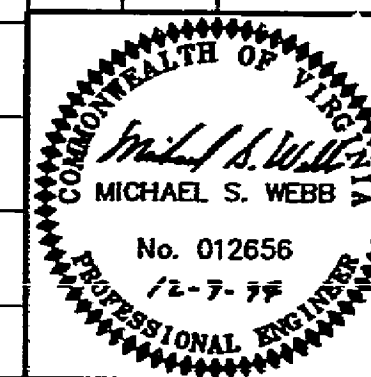


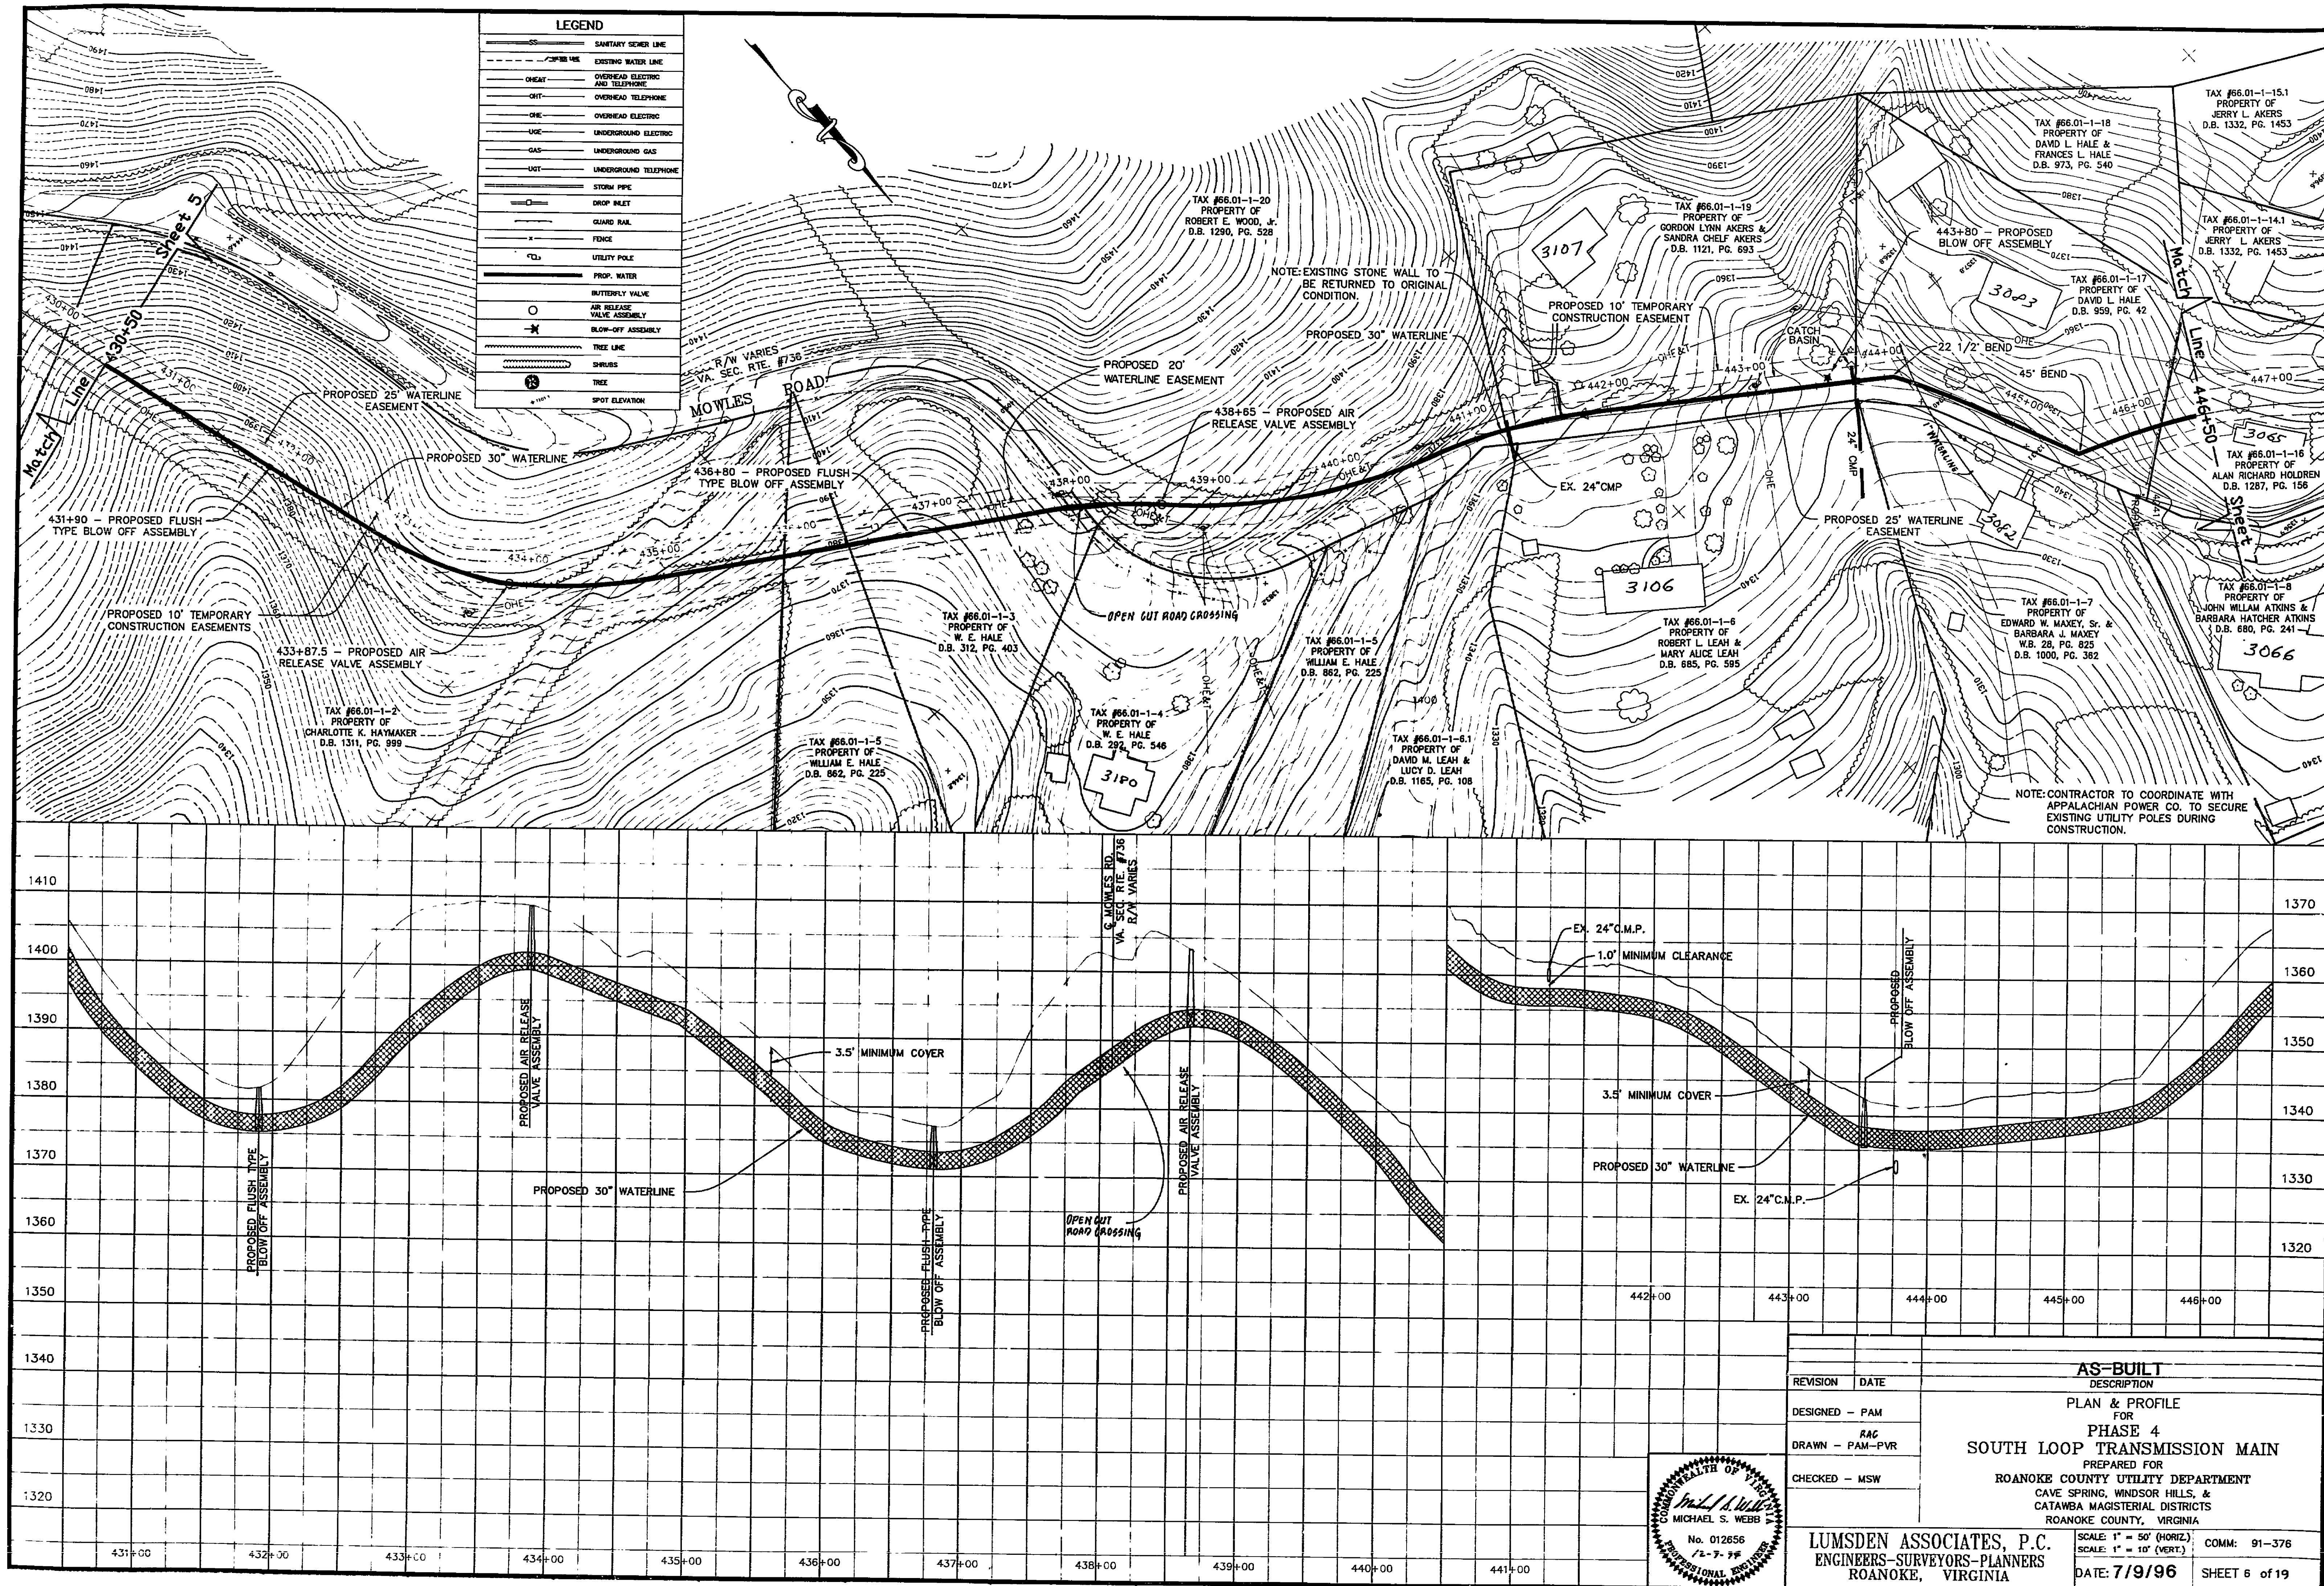

REVISION		DATE	AS-BUILT	
DESIGNED - PAM			DESCRIPTION	
DRAWN - PAM-PVR			PLAN & PROFILE	
CHECKED - MSW			FOR	
			PHASE 4	
			SOUTH LOOP TRANSMISSION MAIN	
			PREPARED FOR	
			ROANOKE COUNTY UTILITY DEPARTMENT	
			CAVE SPRING, WINDSOR HILLS, &	
			CATAWBA MAGISTERIAL DISTRICTS	
			ROANOKE COUNTY, VIRGINIA	
			LUMSDEN ASSOCIATES, P.C.	
			ENGINEERS-SURVEYORS-PLANNERS	
			ROANOKE, VIRGINIA	
			SCALE: 1" = 50' (HORIZ.)	
			SCALE: 1" = 10' (VERT.)	
			DATE: 7/9/96	
			COMM: 91-376	
			SHEET 6 of 19	

WT-0501