


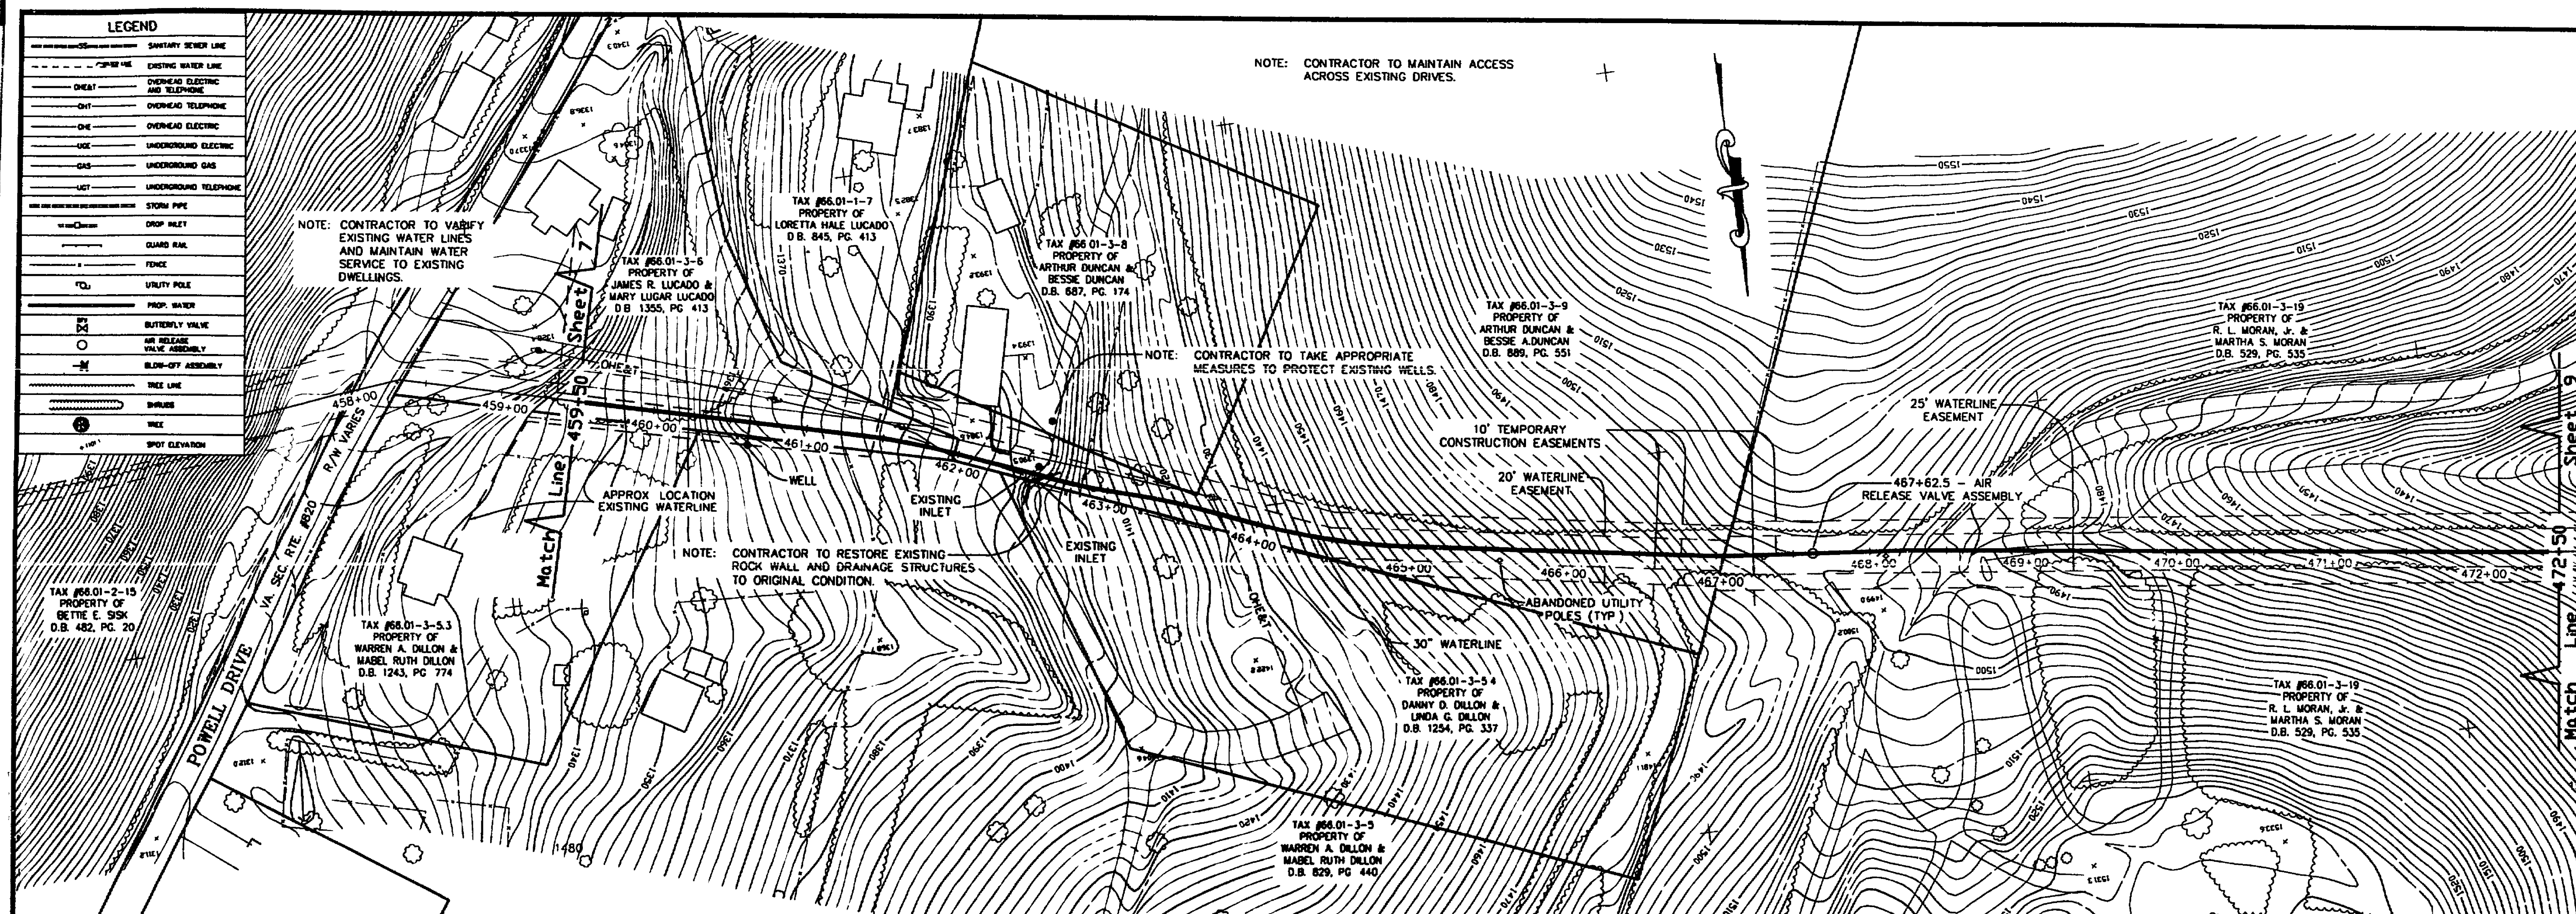

REVISION	DATE	DESCRIPTION
DESIGNED		AS-BUILT PLAN & PROFILE
DRAWN - PAM - SOH		FOR
CHECKED - MSW		PHASE No. 4
		SOUTH LOOP TRANSMISSION MAIN
		PREPARED FOR
		ROANOKE COUNTY UTILITY DEPARTMENT
		CAVE SPRING, WINDSOR HILLS, & CATAMBA MAGISTERIAL DISTRICTS
		ROANOKE COUNTY, VIRGINIA

LUMSDEN ASSOCIATES, P.C.
ENGINEERS-SURVEYORS-PLANNERS
ROANOKE, VIRGINIA

SCALE: 1" = 50' (HORIZ.)
1" = 10' (VERT.)

DATE: 7/9/86

SHEET 8 of 19

WF-0503