



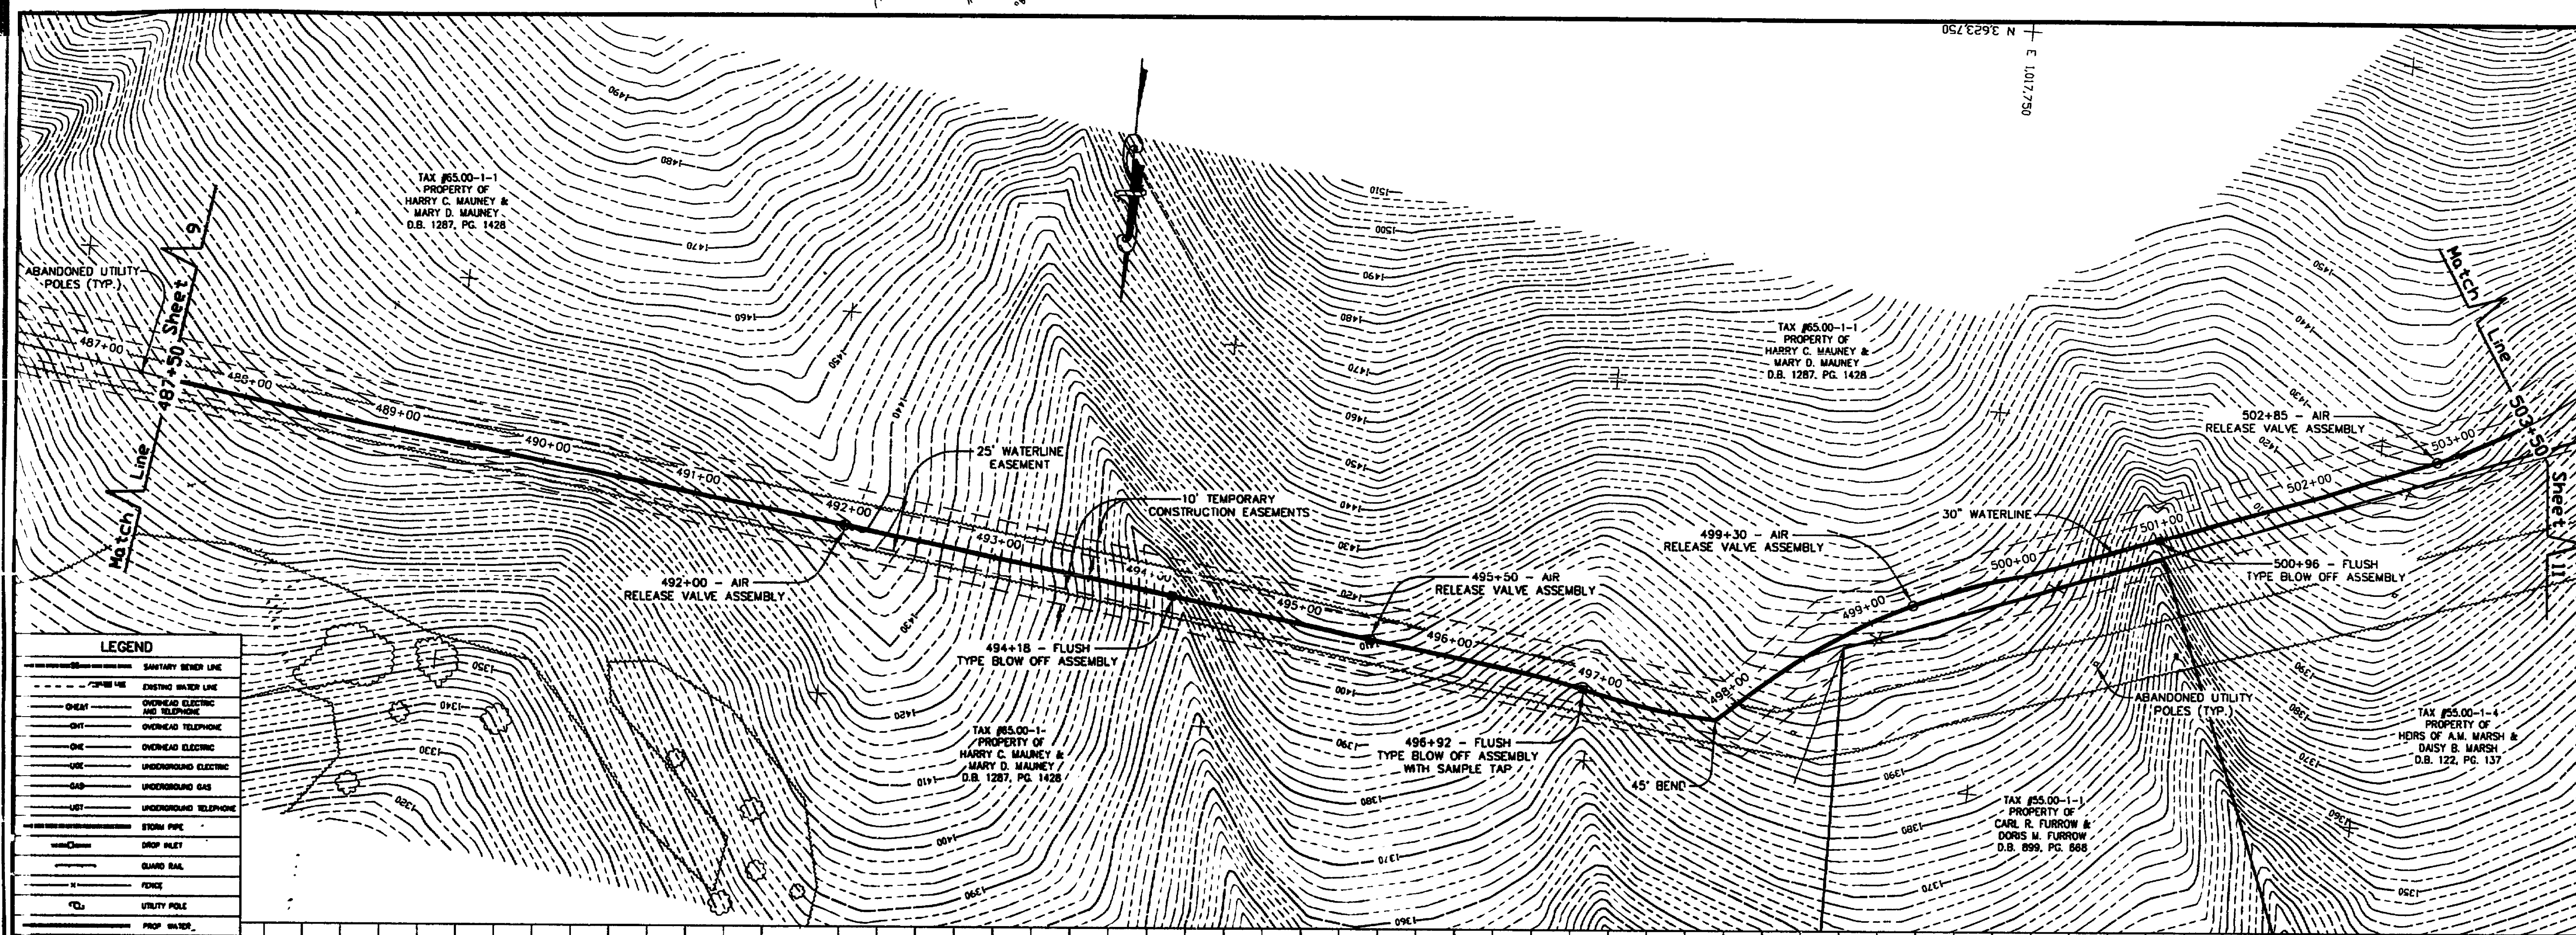

LEGEND

--- SANITARY SEWER LINE
--- EXISTING WATER LINE
--- OVERHEAD ELECTRIC
--- OVERHEAD TELEPHONE
--- OVERHEAD ELECTRIC
--- UNDERGROUND ELECTRIC
--- UNDERGROUND GAS
--- UNDERGROUND TELEPHONE
--- STORM PIPE
--- DROP INLET
--- GUARD RAIL
--- FENCE
--- UTILITY POLE
--- PROP. VALVE
--- BUTTERFLY VALVE
--- AIR RELEASE VALVE ASSEMBLY
--- BLOW-OFF ASSEMBLY
--- TREE LINE
--- SHEDS
--- TREE
--- SPOT ELEVATION

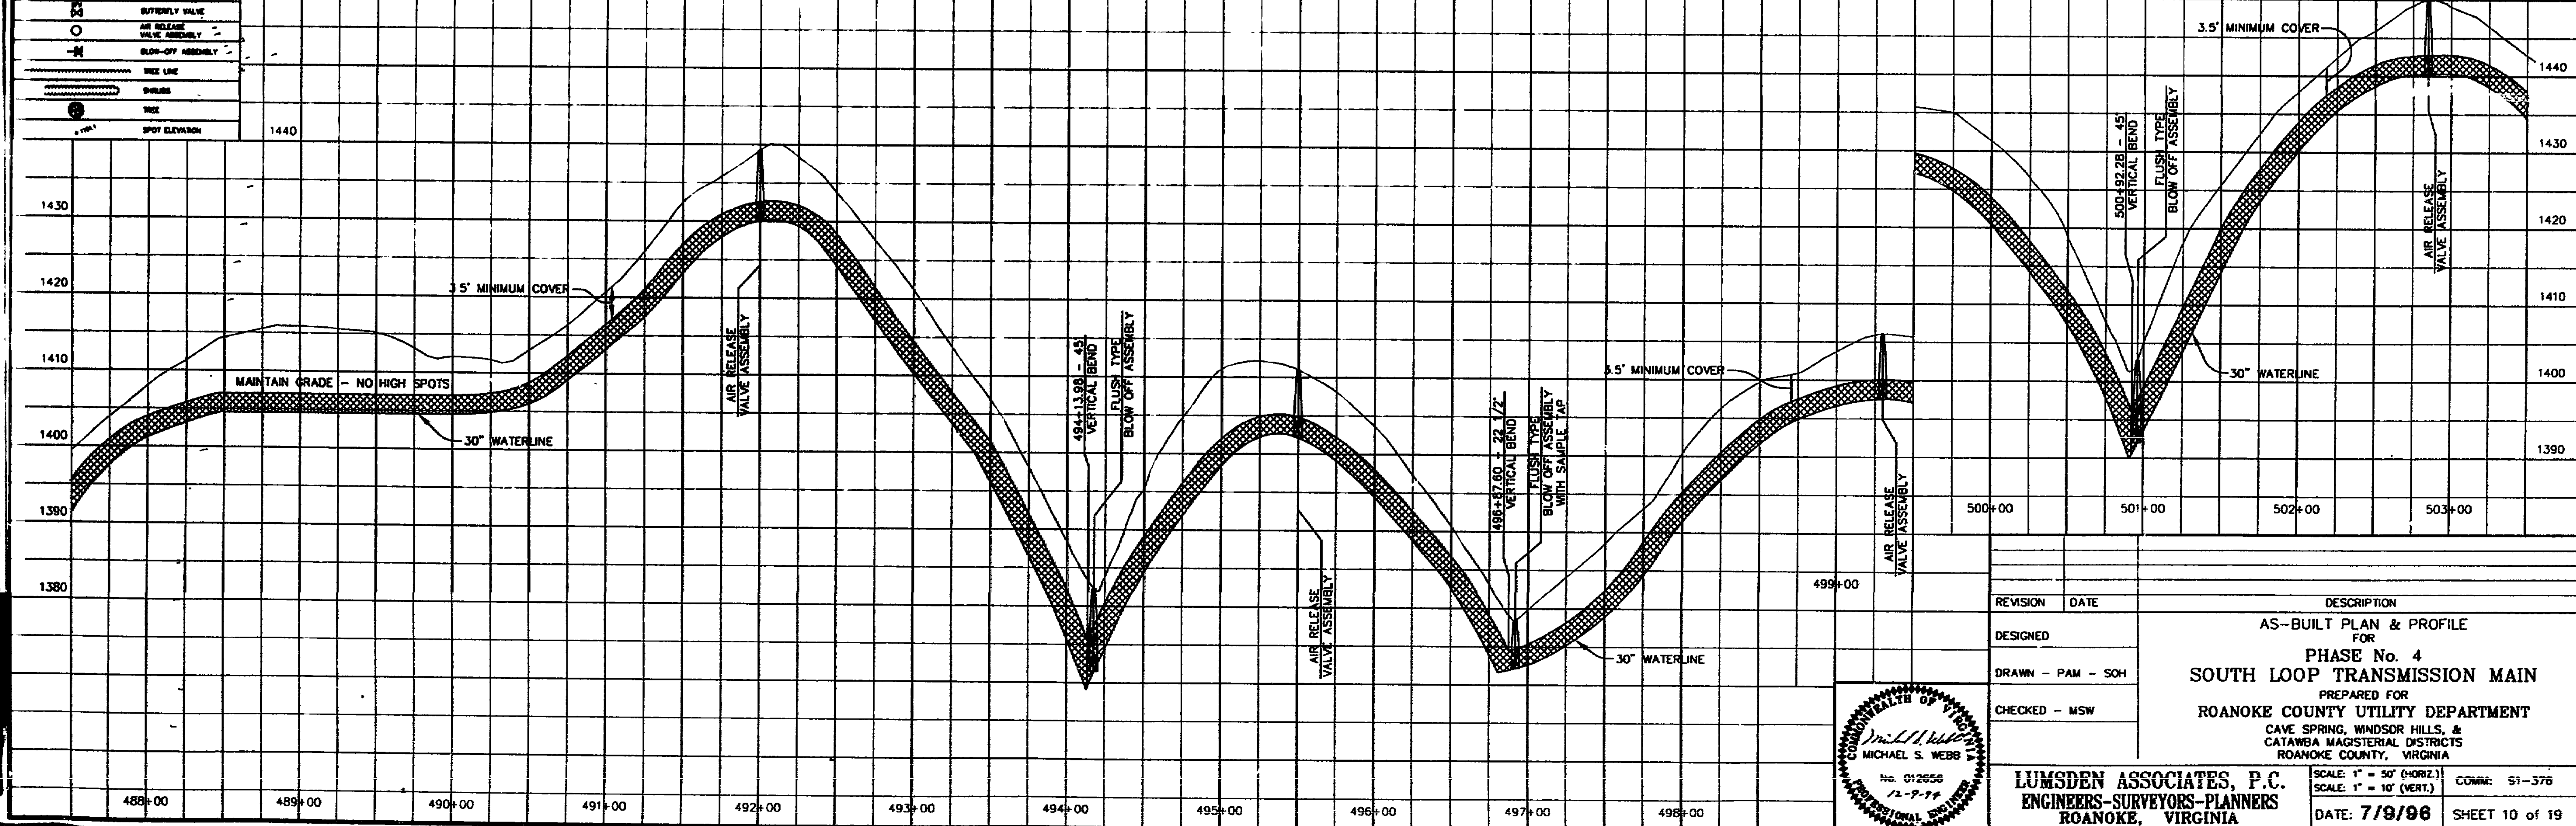

REVISION		DATE	DESCRIPTION AS-BUILT PLAN & PROFILE FOR PHASE No. 4 SOUTH LOOP TRANSMISSION MAIN PREPARED FOR ROANOKE COUNTY UTILITY DEPARTMENT CAVE SPRING, WINDSOR HILLS, & CATAWBA MAGISTERIAL DISTRICTS ROANOKE COUNTY, VIRGINIA
DESIGNED			
DRAWN - PAM - SOH			
CHECKED - MSW			

Michael S. Webb
No. 012656
12-9-79

LUMSDEN ASSOCIATES, P.C.
ENGINEERS-SURVEYORS-PLANNERS
ROANOKE, VIRGINIA

SCALE: 1" = 50' (HORIZ.)
 SCALE: 1" = 10' (VERT.)
 DATE: 7/9/96
 SHEET 10 of 19

WT-0505