

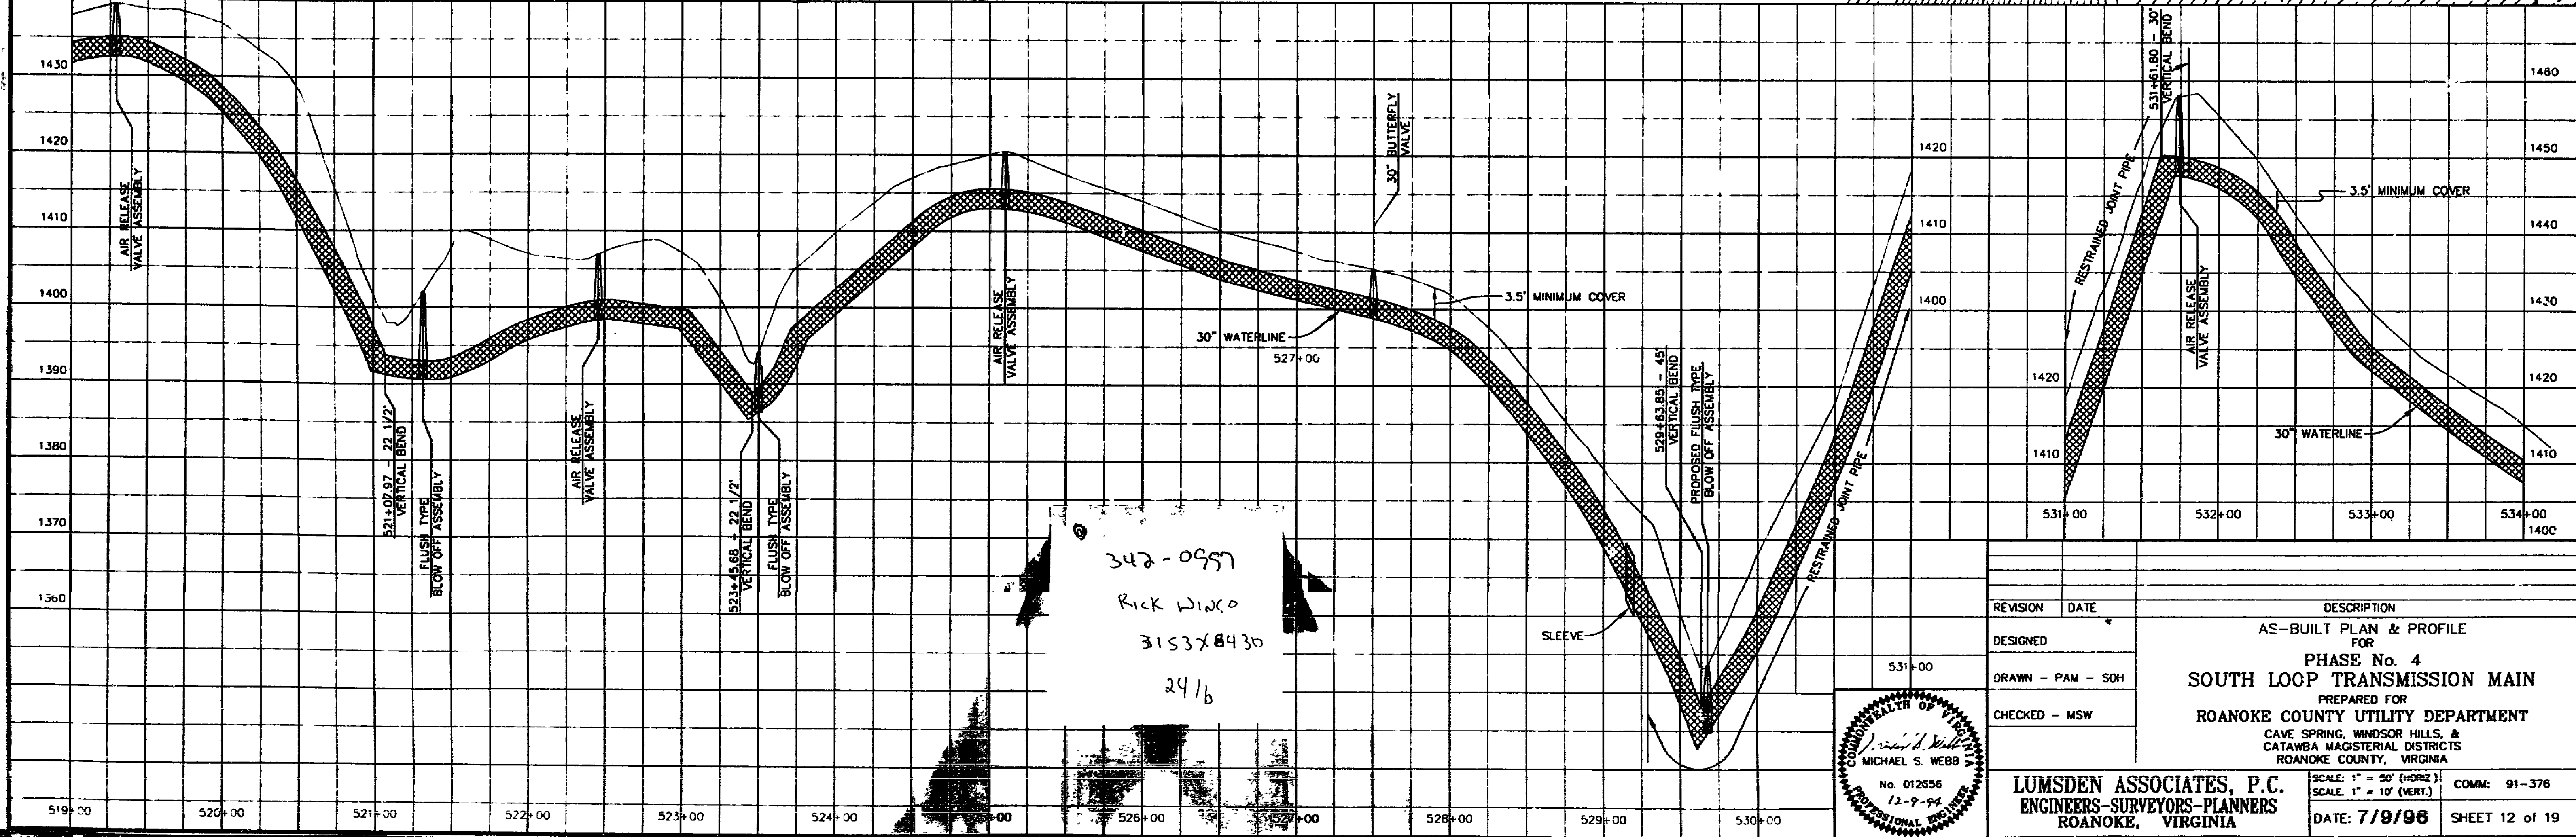


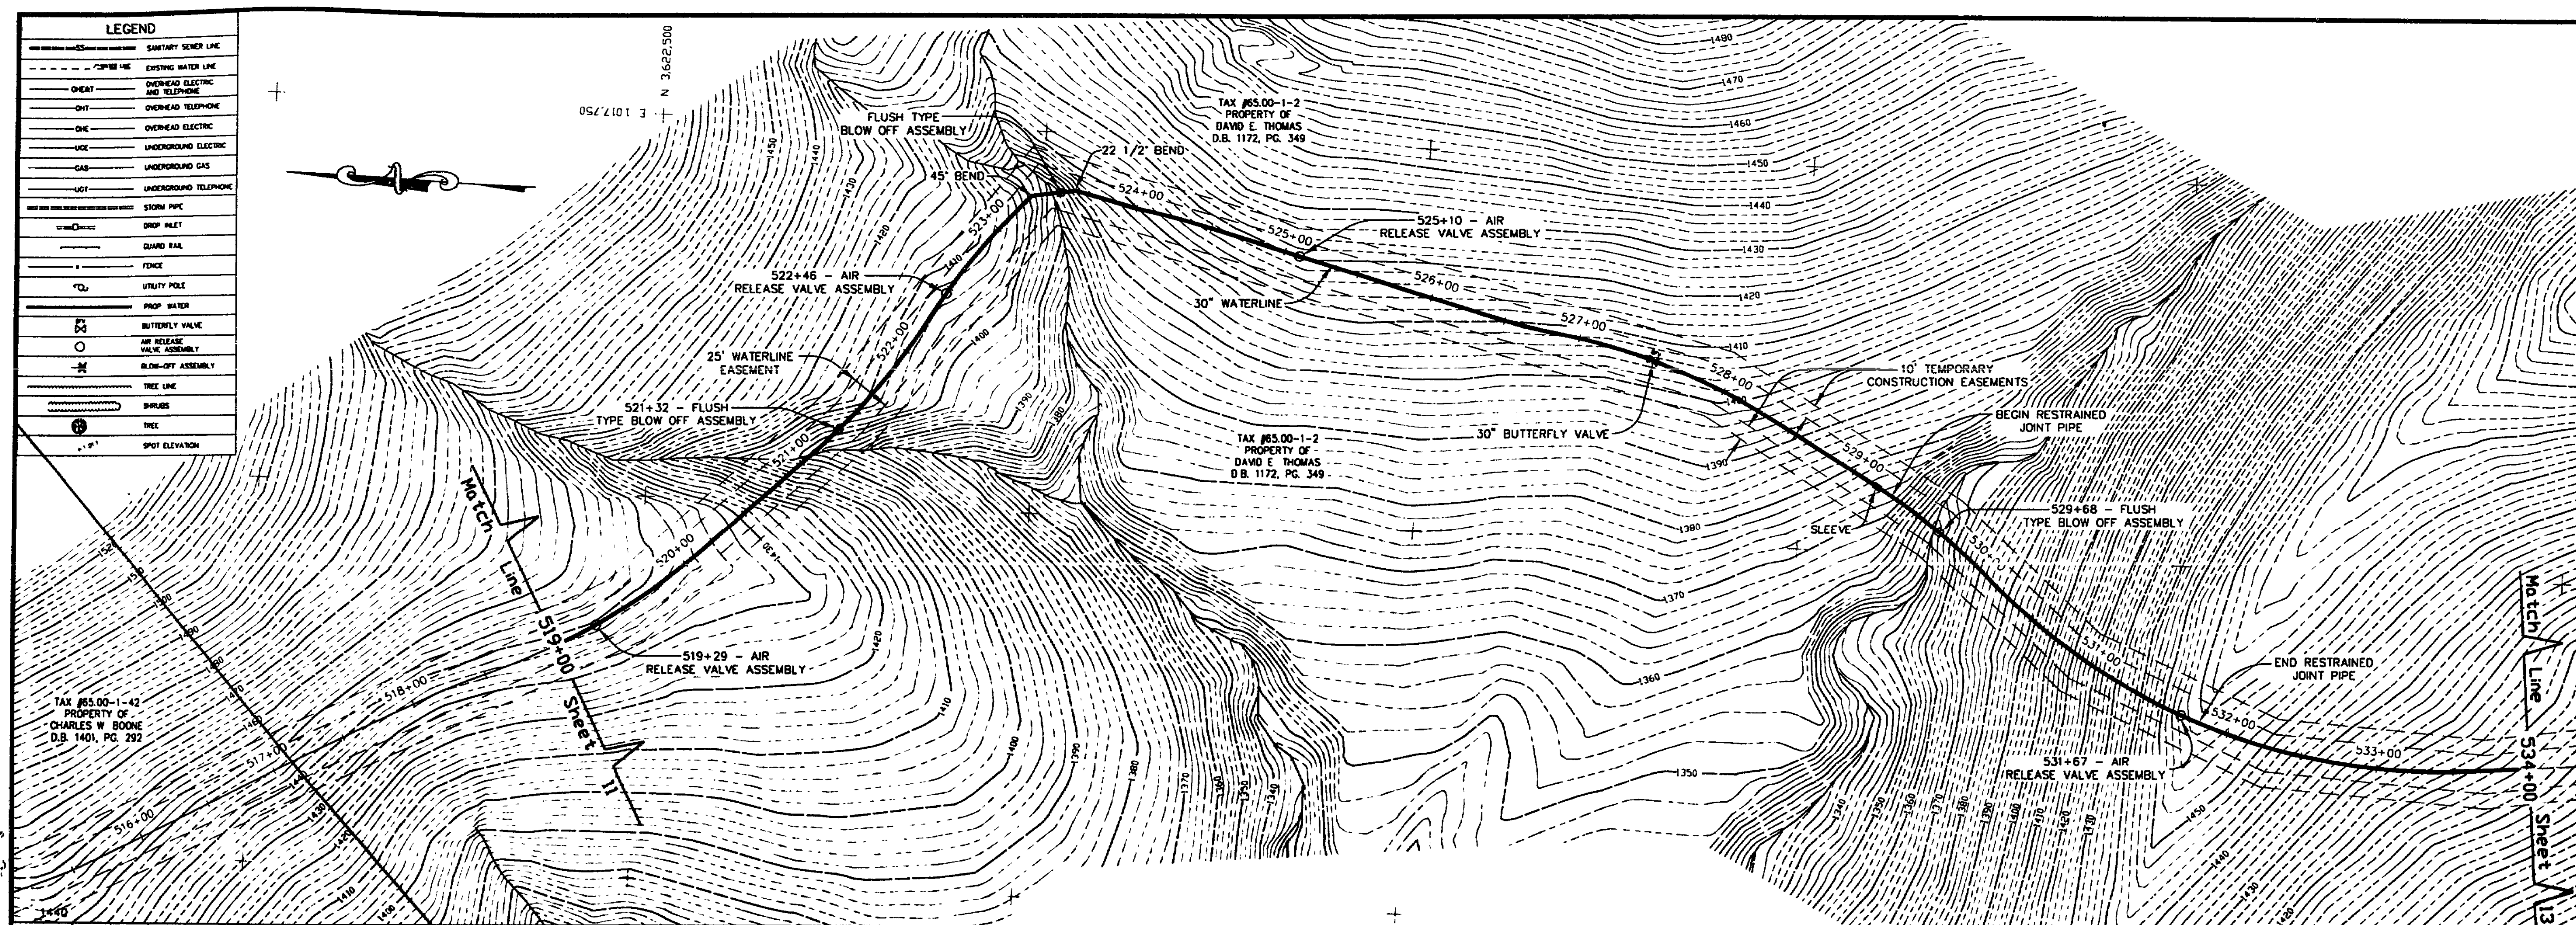

342-0957
 Rick Wingo
 315378430
 2416

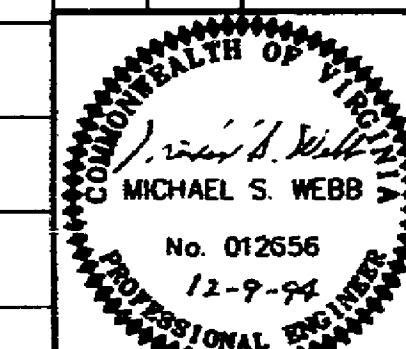

REVISION		DATE	DESCRIPTION
DESIGNED			AS-BUILT PLAN & PROFILE FOR PHASE No. 4 SOUTH LOOP TRANSMISSION MAIN
DRAWN - PAM - SOH			PREPARED FOR ROANOKE COUNTY UTILITY DEPARTMENT
CHECKED - MSW			CAVE SPRING, WINDSOR HILLS, & CATANHA MAGISTERIAL DISTRICTS, ROANOKE COUNTY, VIRGINIA
LUMSDEN ASSOCIATES, P.C. ENGINEERS-SURVEYORS-PLANNERS ROANOKE, VIRGINIA			SCALE: 1" = 50' (HORIZ.) SCALE: 1" = 10' (VERT.) DATE: 7/9/96 SHEET 12 OF 19