



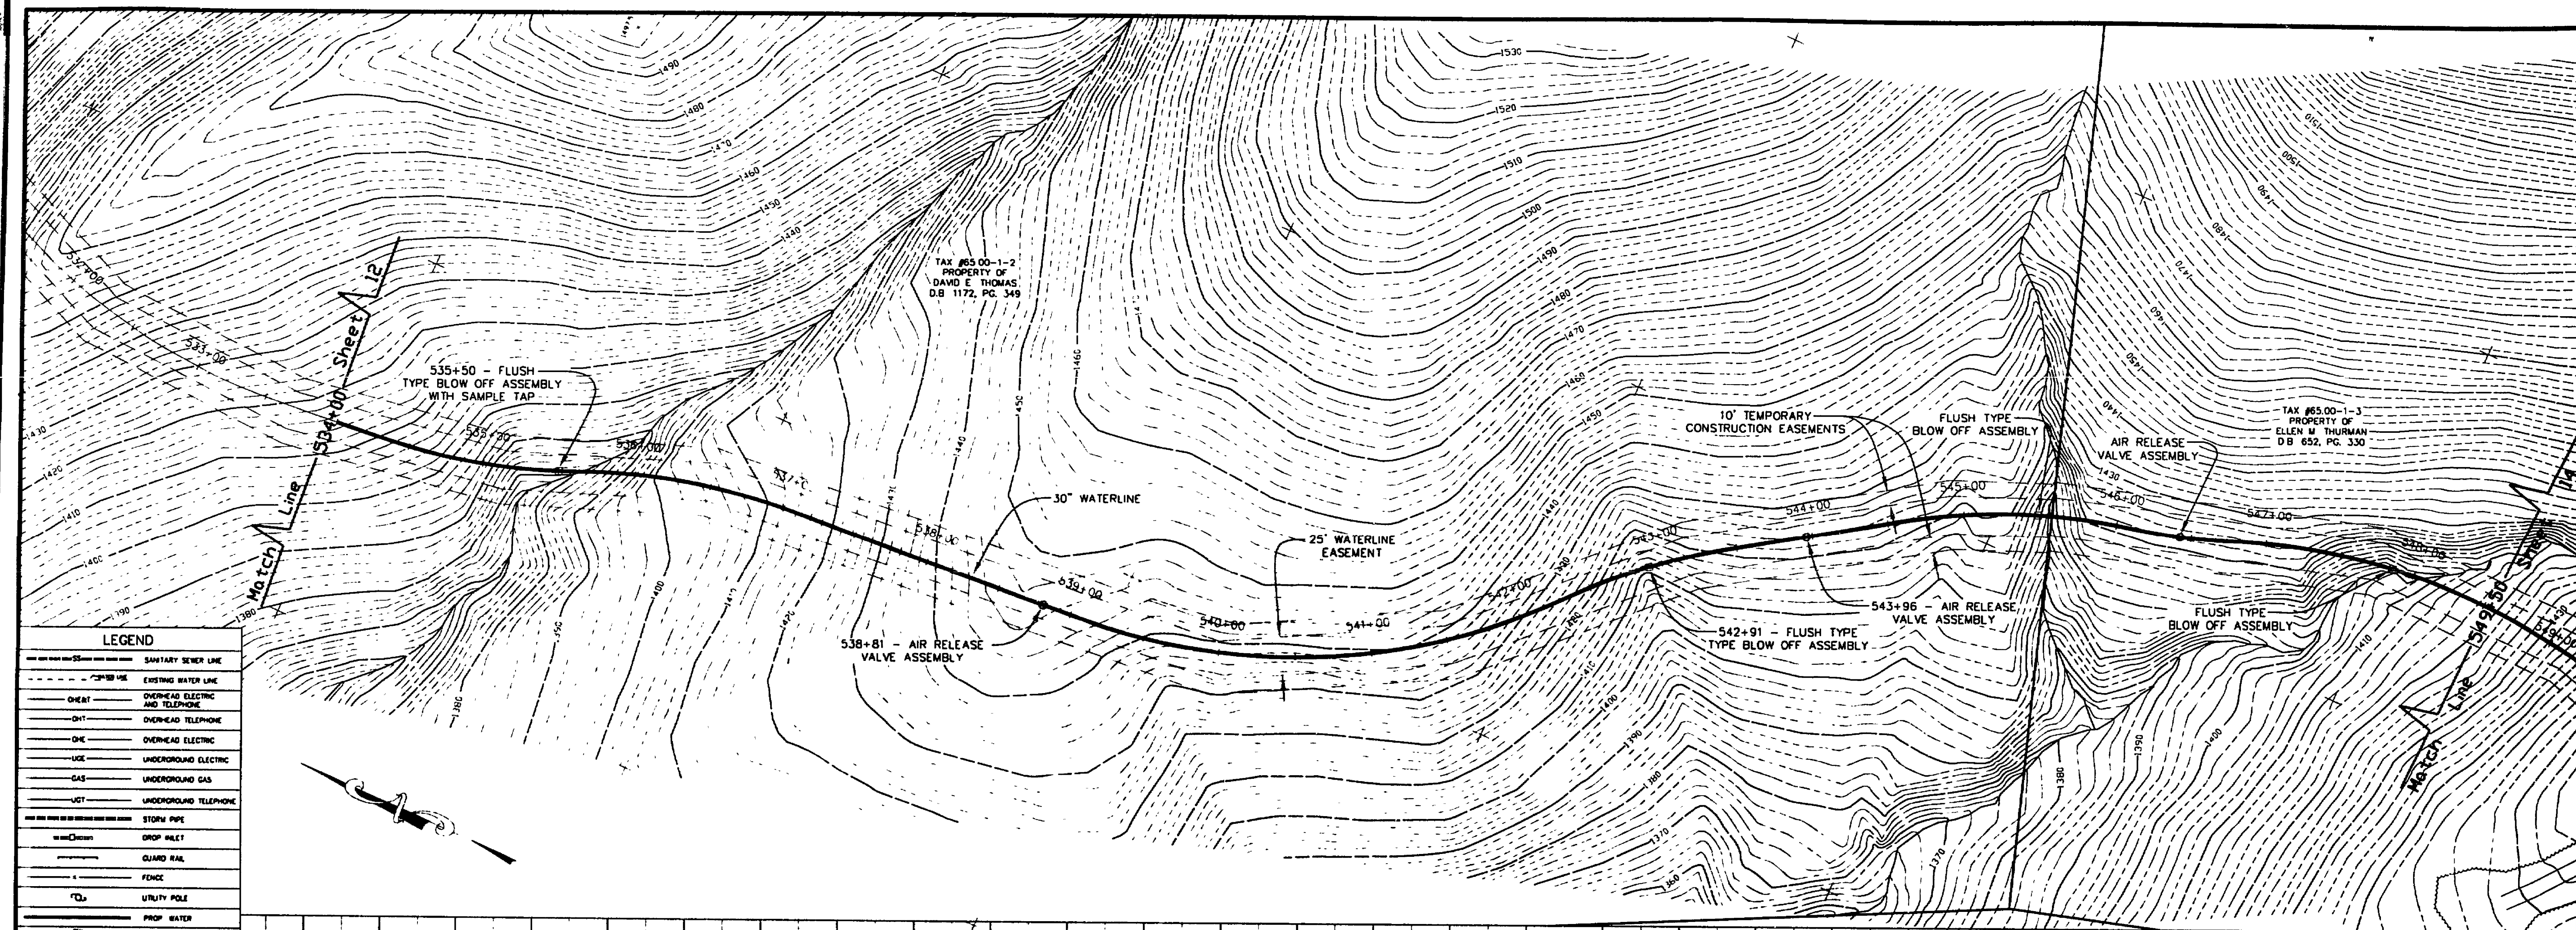

LEGEND

---	SANITARY SEWER LINE
---	EXISTING WATER LINE
---	OVERHEAD ELECTRIC AND TELEPHONE
---	OVERHEAD ELECTRIC
---	UNDERGROUND ELECTRIC
---	UNDERGROUND GAS
---	UNDERGROUND TELEPHONE
---	STORM PIPE
---	DROP PILE
---	GUARD RAIL
---	FENCE
---	UTILITY POLE
---	PROP. WATER
---	BUTTERFLY VALVE
---	AIR RELEASE VALVE ASSEMBLY
---	BLOW-OFF ASSEMBLY
---	TRICE LINE
---	SHRUBS
---	TREE
---	SPOT ELEVATION

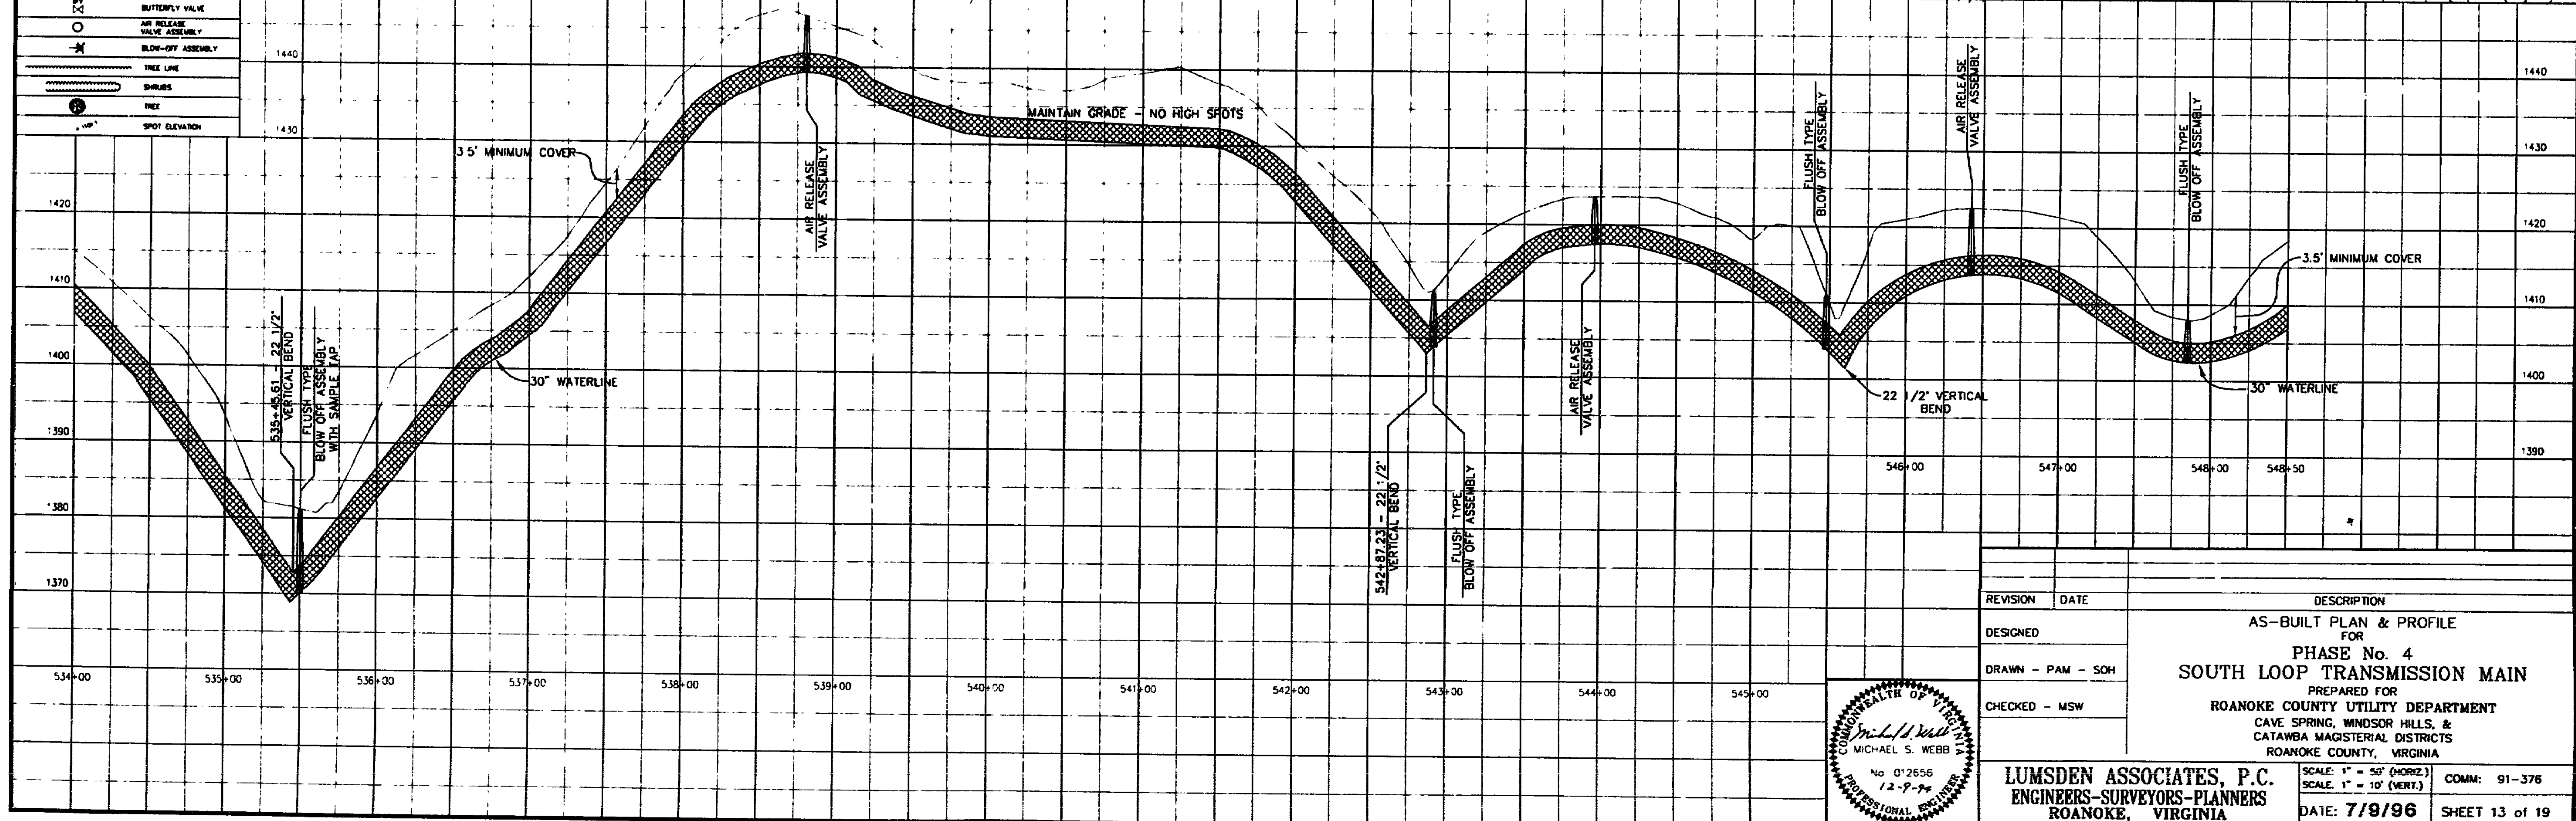

REVISION	DATE	DESCRIPTION
DESIGNED		AS-BUILT PLAN & PROFILE FOR
DRAWN - PAM - SOH		PHASE No. 4
CHECKED - MSW		SOUTH LOOP TRANSMISSION MAIN
		PREPARED FOR
		ROANOKE COUNTY UTILITY DEPARTMENT
		CAVE SPRING, WINDSOR HILLS, & CATAWBA MAGISTERIAL DISTRICTS
		ROANOKE COUNTY, VIRGINIA
LUMSDEN ASSOCIATES, P.C. ENGINEERS-SURVEYORS-PLANNERS ROANOKE, VIRGINIA		SCALE: 1" = 50' (HORIZ.) SCALE: 1" = 10' (VERT.) DATE: 7/9/96 COMM: 91-376 SHEET 13 of 19

