


"AS-BUILT" 19 SEPTEMBER 1996
DEVELOPMENT PLANS
FOR
PHASE #5
SOUTH LOOP TRANSMISSION MAIN
SITUATED IN
CAVE SPRING, WINDSOR HILLS &
CATAWBA MAGISTERIAL DISTRICTS
ROANOKE COUNTY, VIRGINIA

DATE: 10 FEBRUARY 1995
REVISED : 5 MAY 1995
PREPARED FOR

ROANOKE COUNTY UTILITY DEPARTMENT

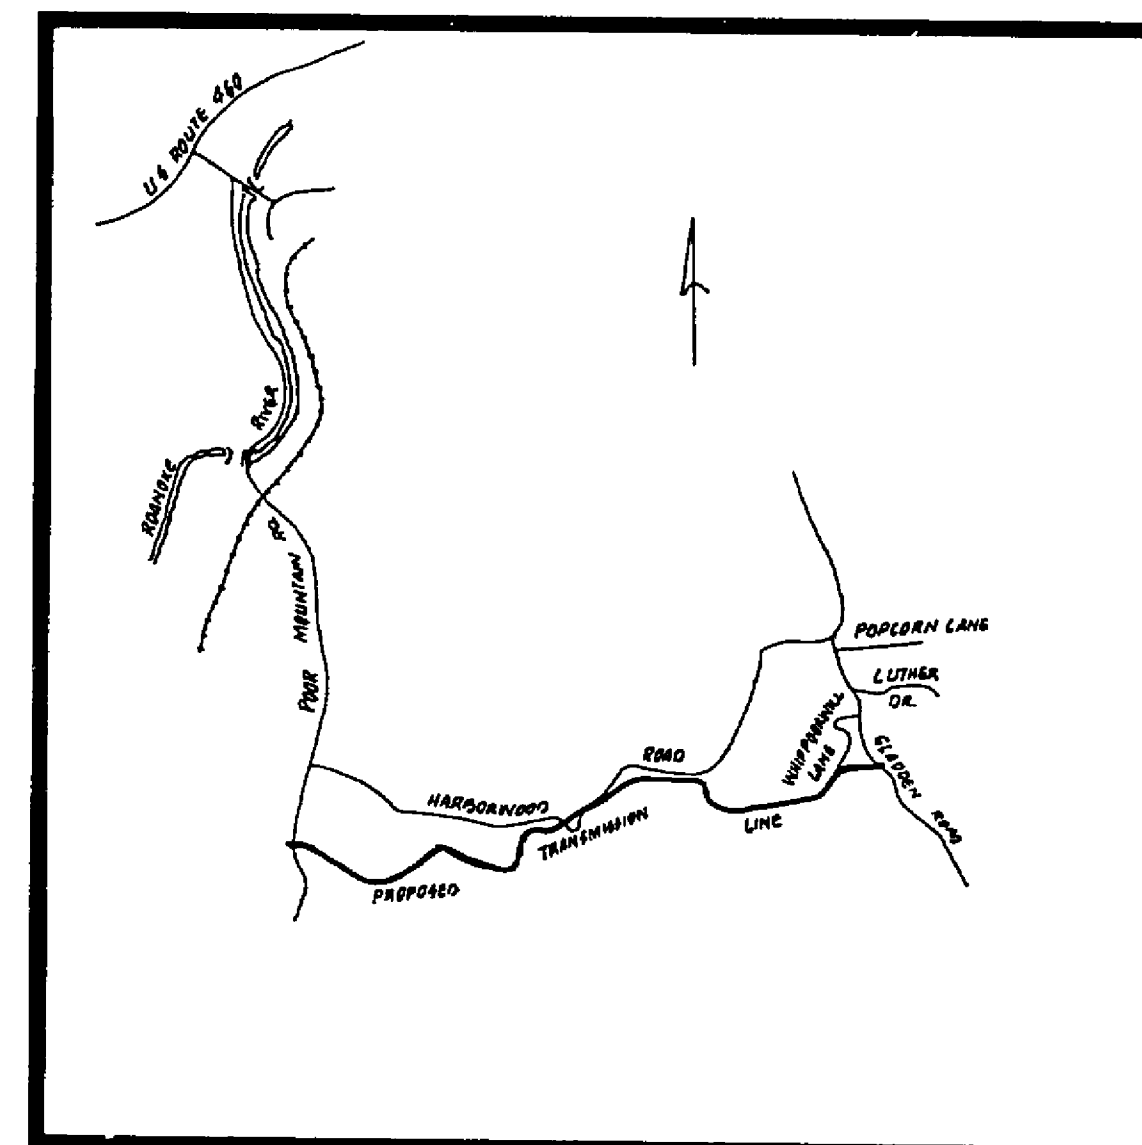

"AS-BUILT"

NOTES:
1) "AS-BUILT" INFORMATION TAKEN FROM
PLANS FURNISHED BY ROANOKE COUNTY.
2) "AS-BUILT" DIMENSIONS SHOWN IN
BRACKETS.

INDEX OF DRAWINGS

SHEET No.	DESCRIPTION
------------------	--------------------

- | | |
|-------|---|
| 1. | LUMSDEN ASSOCIATES COVER SHEET |
| 2. | PLAN & PROFILE SHEET LAYOUT |
| 3-10. | PLAN & PROFILE |
| 11. | WATER DETAILS |
| 12. | ROANOKE CO. STD. EROSION CONTROL DETAIL SHEET |

LUMSDEN ASSOCIATES, P.C.
ENGINEERS-SURVEYORS-PLANNERS
ROANOKE, VIRGINIA