
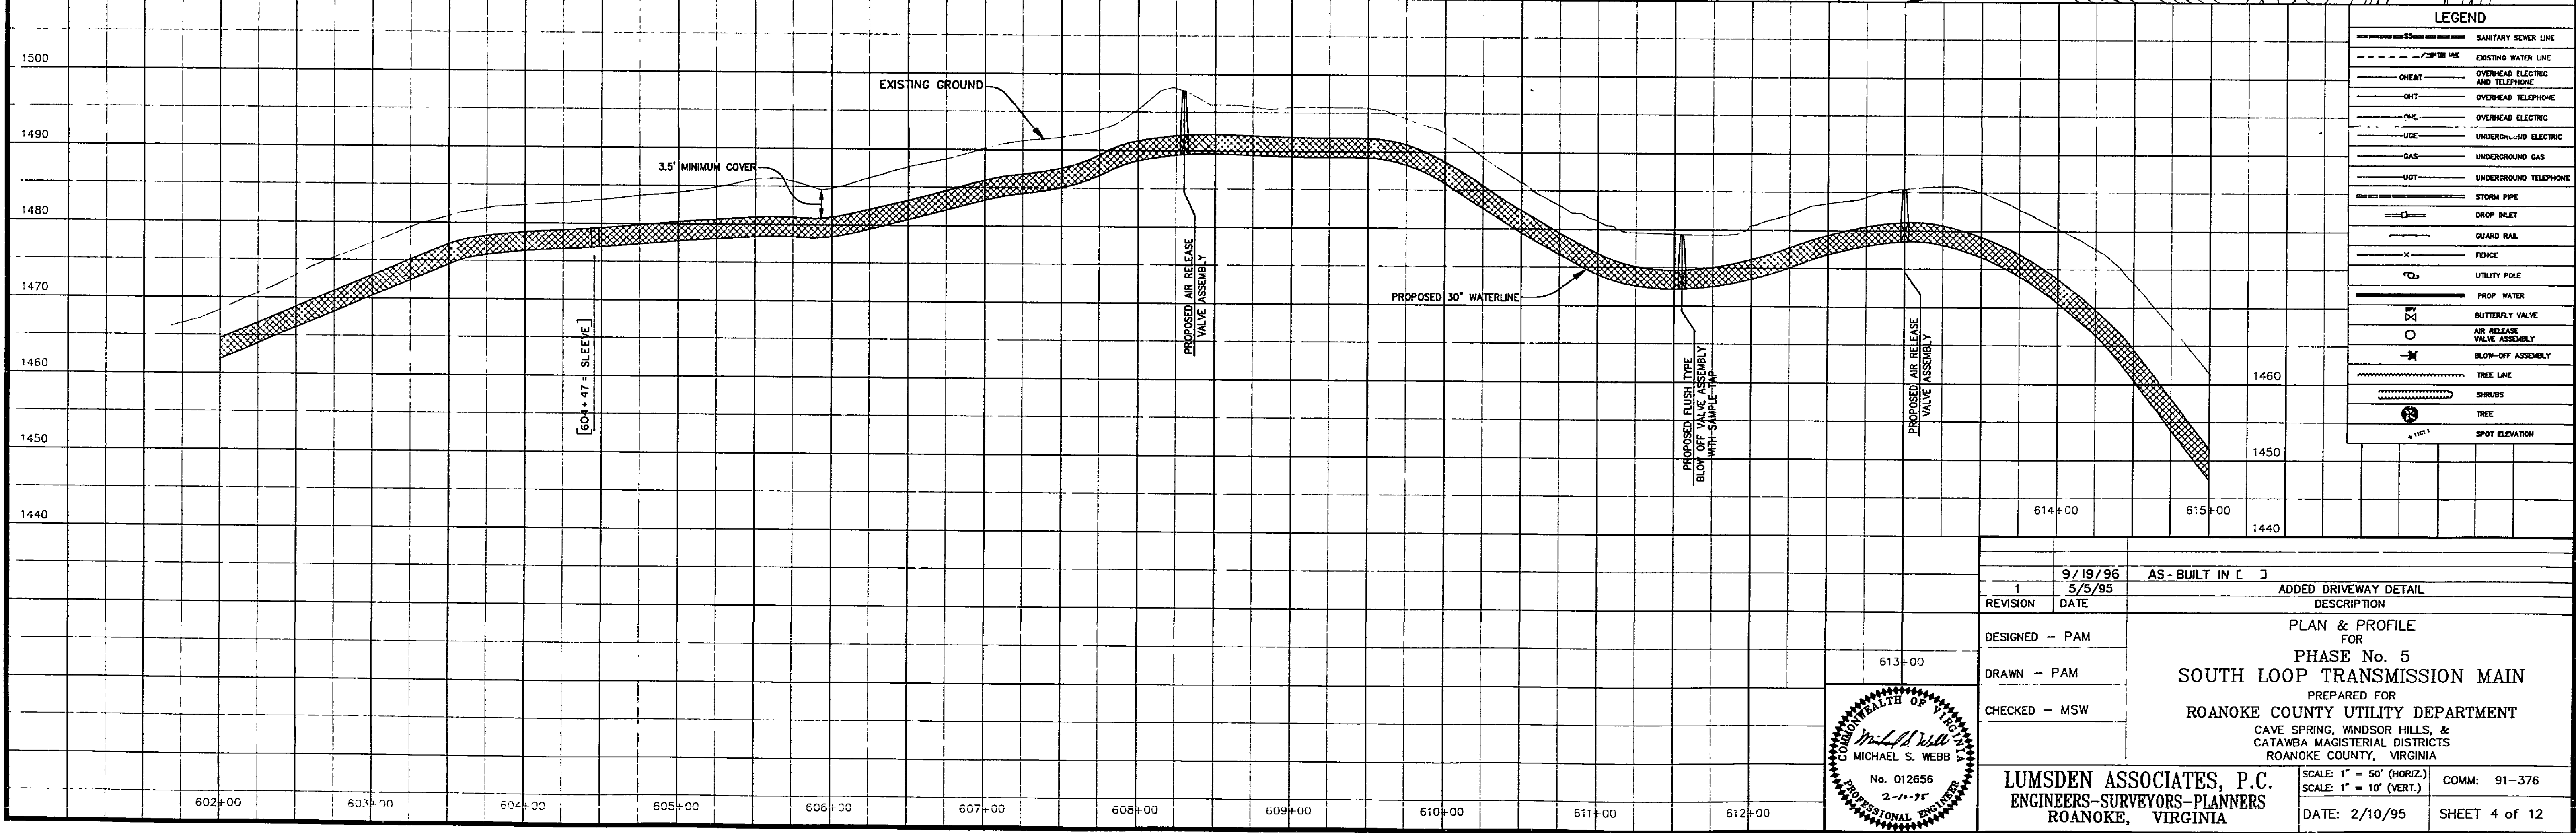
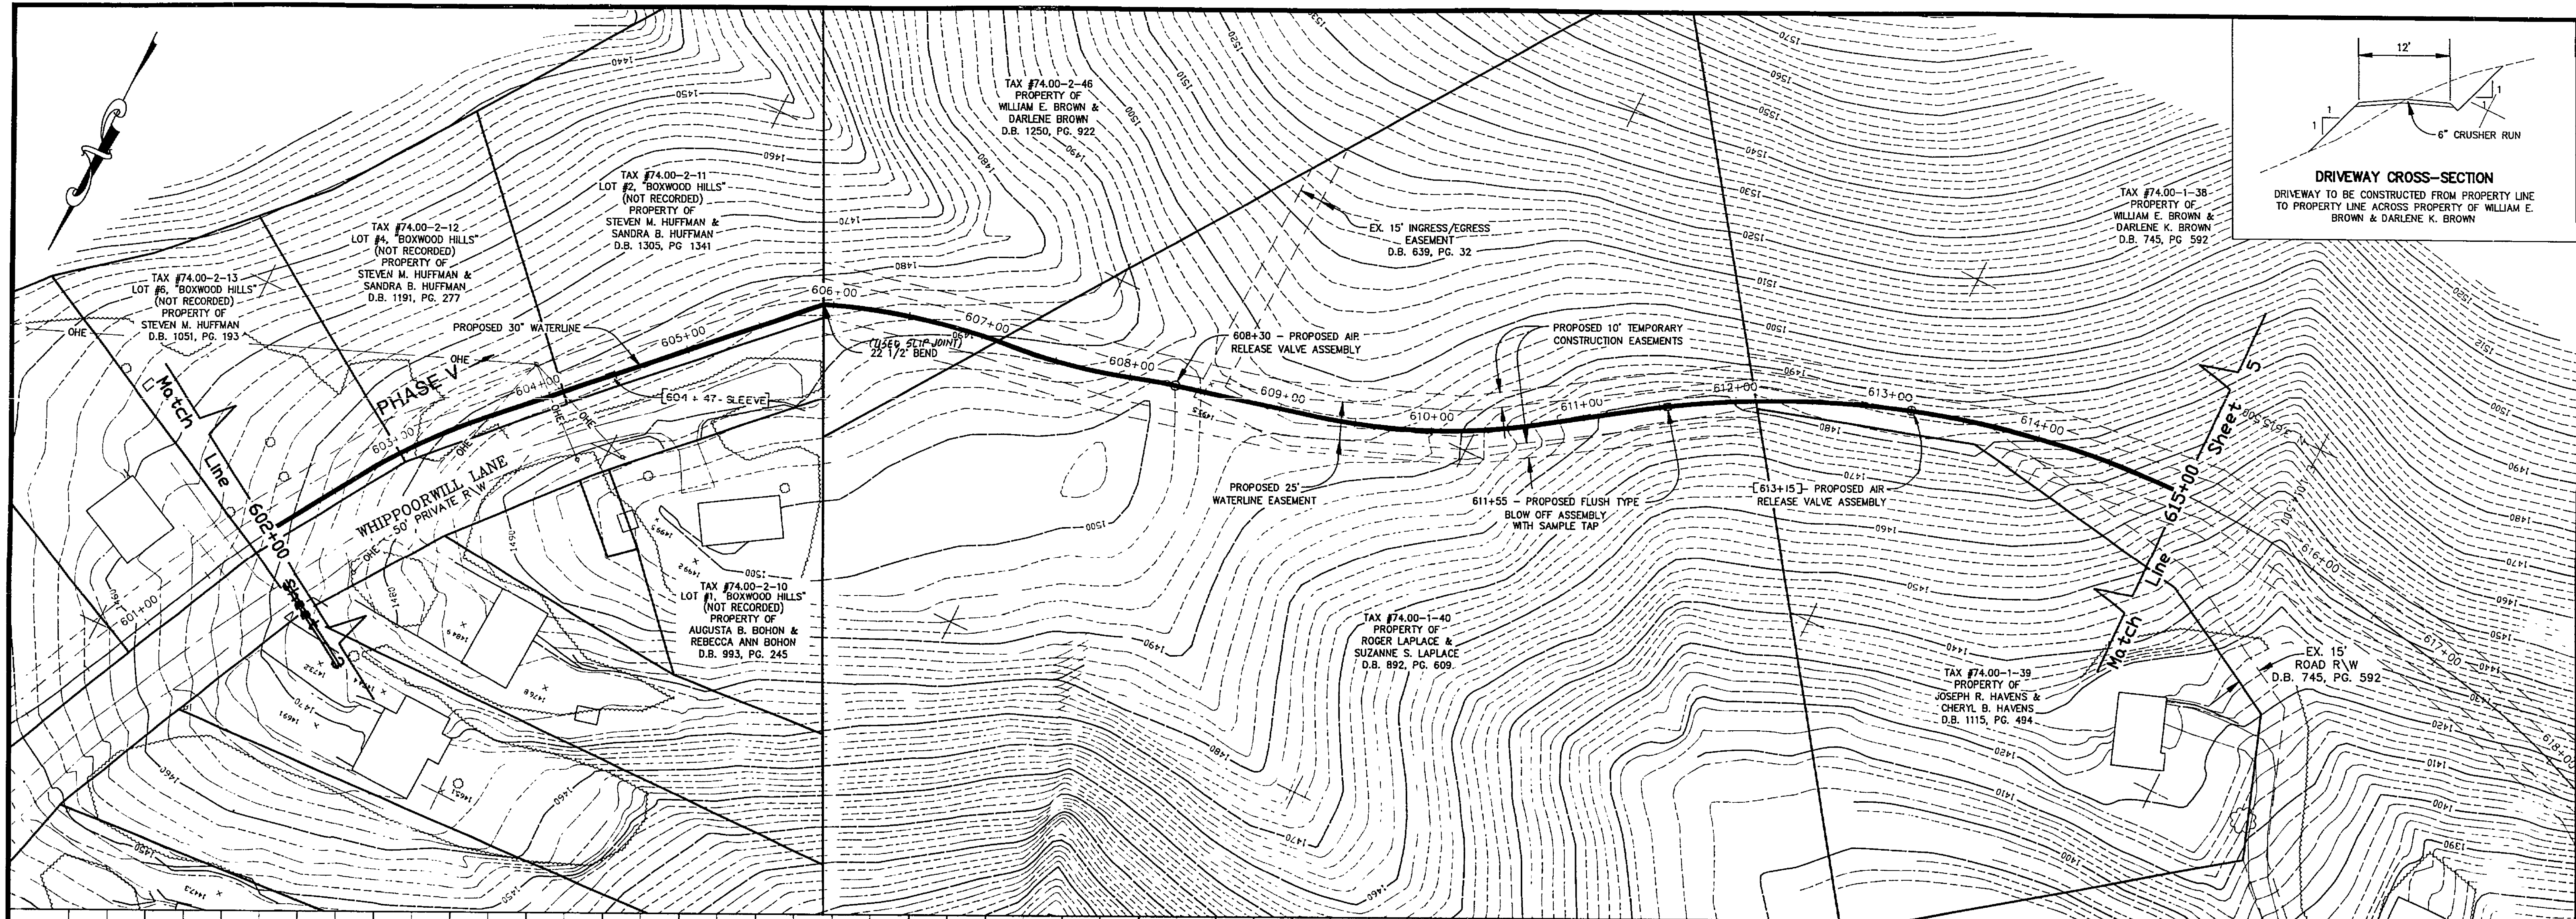


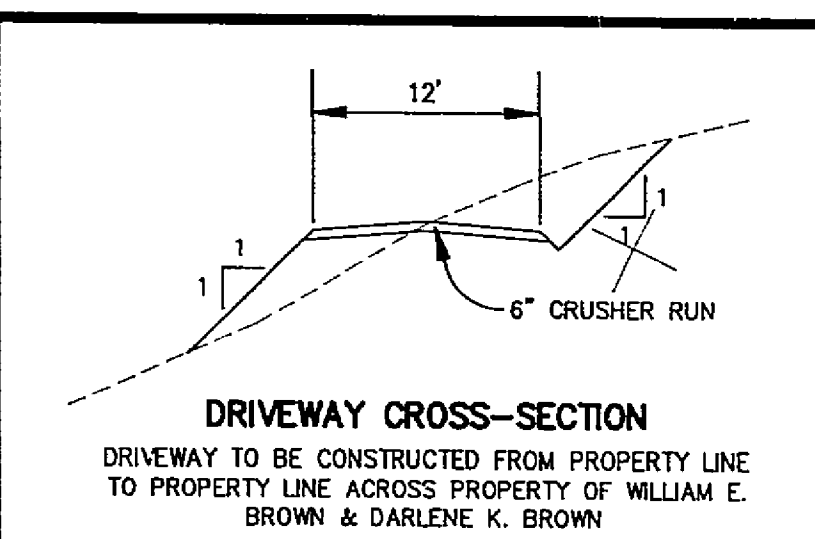

LEGEND


---	SANITARY SEWER LINE
---	EXISTING WATER LINE
---	OVERHEAD ELECTRIC AND TELEPHONE
---	OVERHEAD ELECTRIC
---	OVERHEAD TELEPHONE
---	UNDERGROUND ELECTRIC
---	UNDERGROUND GAS
---	UNDERGROUND TELEPHONE
---	STORM PIPE
---	DROP INLET
---	GUARD RAIL
---	FENCE
---	UTILITY POLE
---	PROP. WATER
---	BUTTERFLY VALVE
---	AIR RELEASE VALVE ASSEMBLY
---	BLOW-OFF ASSEMBLY
---	TREE LINE
---	SHRUBS
---	TREE
---	SPOT ELEVATION

1	9/19/96	AS-BUILT IN C
REVISION	DATE	DESCRIPTION
DESIGNED - PAM		
DRAWN - PAM		
CHECKED - MSW		

PLAN & PROFILE FOR
 PHASE No. 5
 SOUTH LOOP TRANSMISSION MAIN
 PREPARED FOR
 ROANOKE COUNTY UTILITY DEPARTMENT
 CAVE SPRING, WINDSOR HILLS, &
 CATAMBA MAGISTERIAL DISTRICTS
 ROANOKE COUNTY, VIRGINIA

LUMSDEN ASSOCIATES, P.C.
 ENGINEERS-SURVEYORS-PLANNERS
 ROANOKE, VIRGINIA

SCALE: 1" = 50' (HORIZ.)
 SCALE: 1" = 10' (VERT.)
 DATE: 2/10/95
 COMM: 91-376
 SHEET 4 of 12

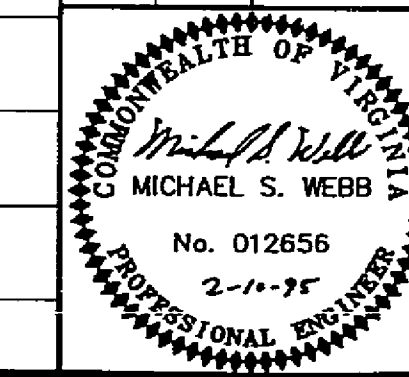

WT-0518