

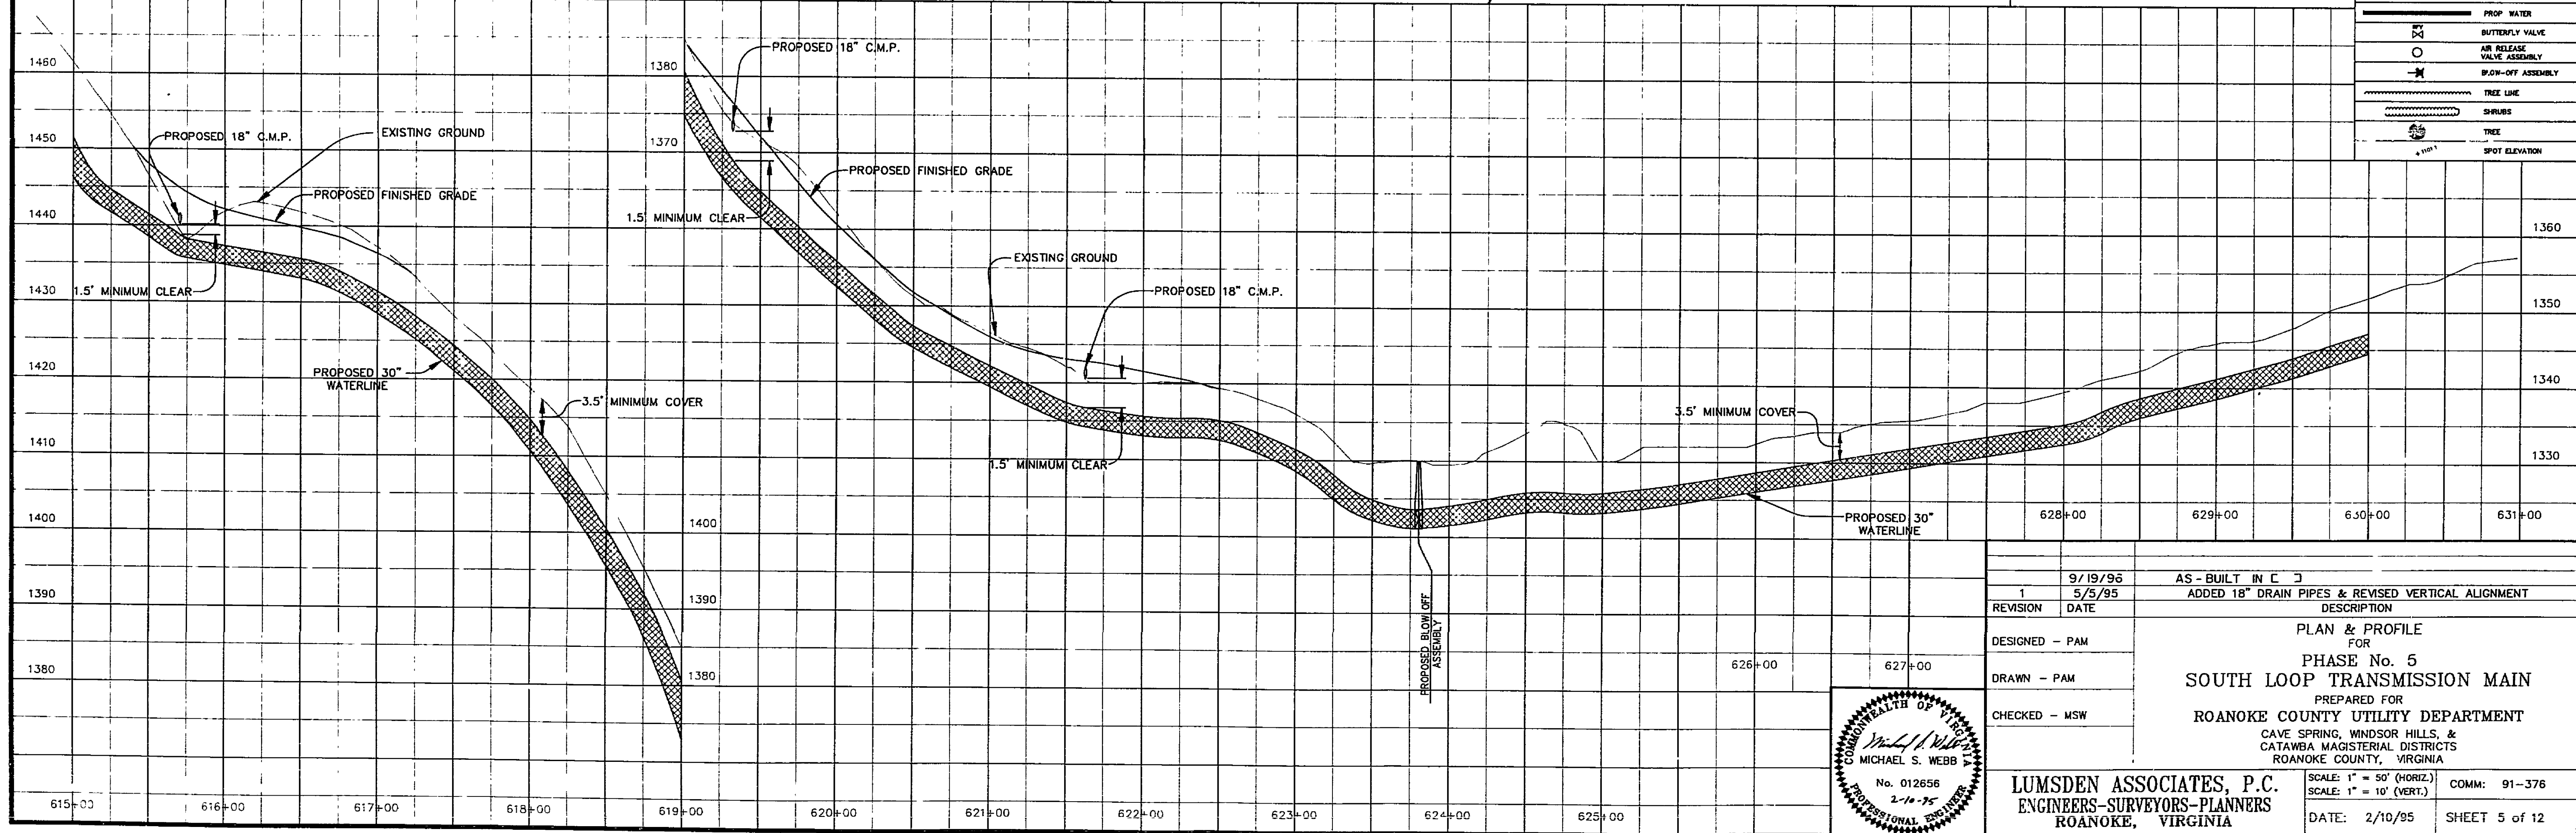


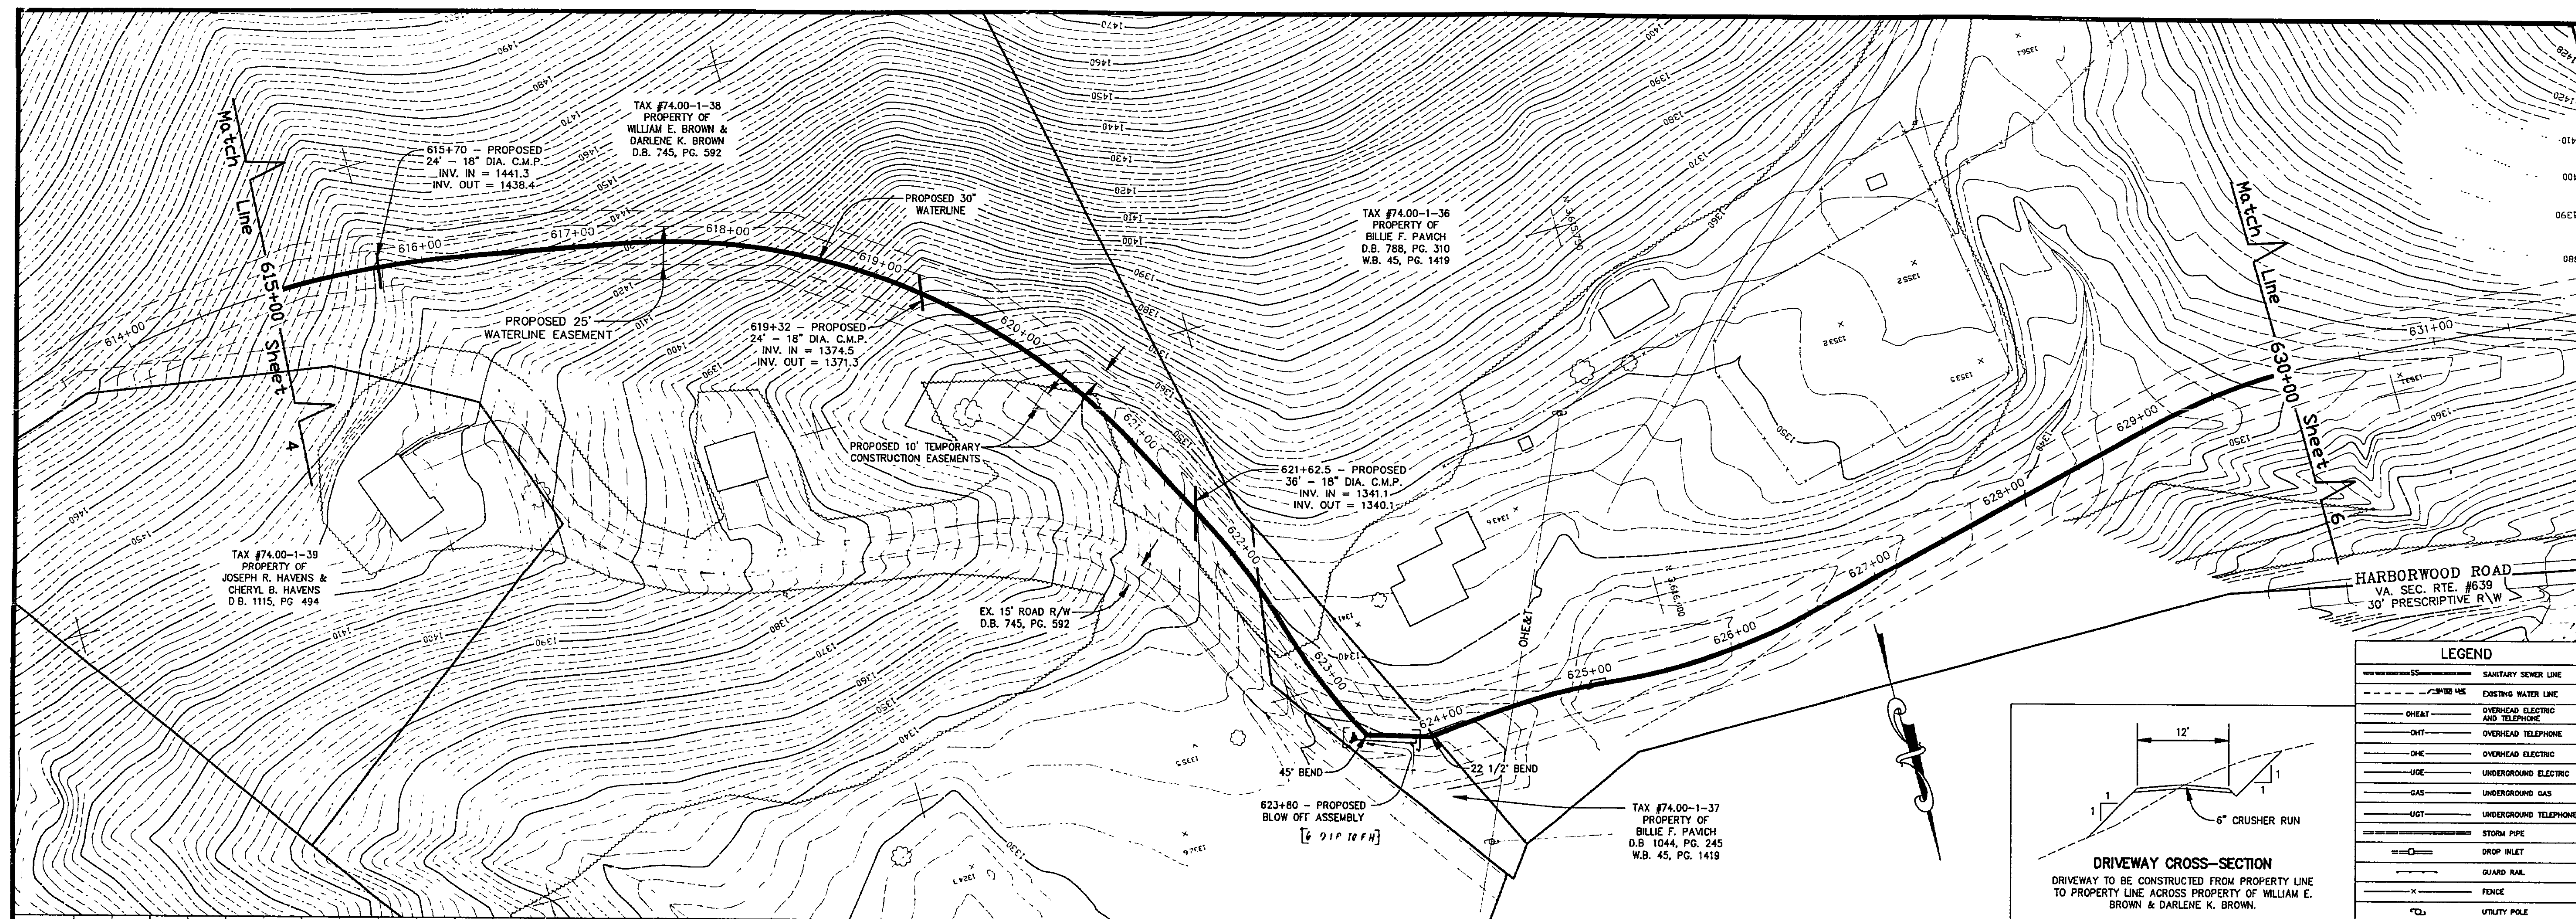

LEGEND

---	SANITARY SEWER LINE
---	EXISTING WATER LINE
---	OVERHEAD ELECTRIC AND TELEPHONE
---	OVERHEAD ELECTRIC
---	UNDERGROUND ELECTRIC
---	UNDERGROUND GAS
---	UNDERGROUND TELEPHONE
---	STORM PIPE
---	DROP INLET
---	GUARD RAIL
---	FENCE
---	UTILITY POLE
---	PROP. WATER
---	BUTTERFLY VALVE
---	AIR RELEASE VALVE ASSEMBLY
---	BLOW-OFF ASSEMBLY
---	TREE LINE
---	SHRUBS
---	TREE
---	SPOT ELEVATION

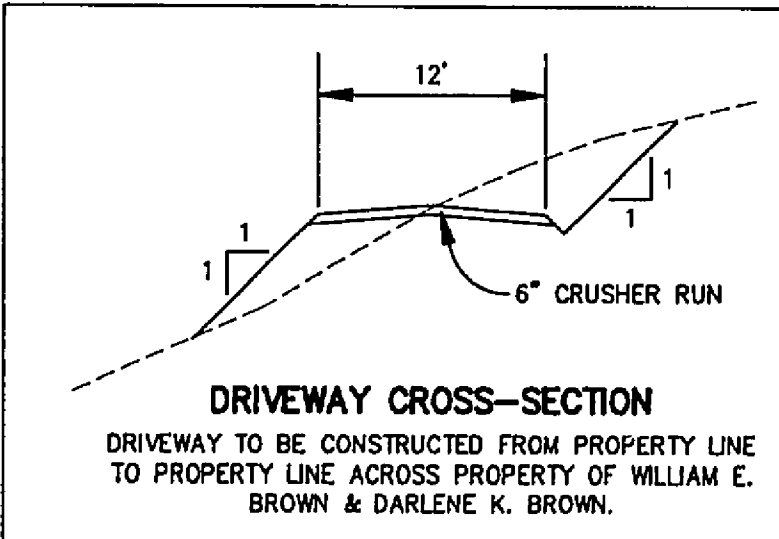

DESIGNED - PAM	9/19/96	AS-BUILT IN C.C.
DRAWN - PAM	5/5/95	ADDED 18\"/>
CHECKED - MSW		

PLAN & PROFILE FOR PHASE No. 5 SOUTH LOOP TRANSMISSION MAIN PREPARED FOR ROANOKE COUNTY UTILITY DEPARTMENT CAVE SPRING, WINDSOR HILLS, & CATAWBA MAGISTERIAL DISTRICTS ROANOKE COUNTY, VIRGINIA		SCALE: 1" = 50' (HORIZ.) SCALE: 1" = 10' (VERT.) DATE: 2/10/95 COMM: 91-376 SHEET 5 of 12
---	--	---

