



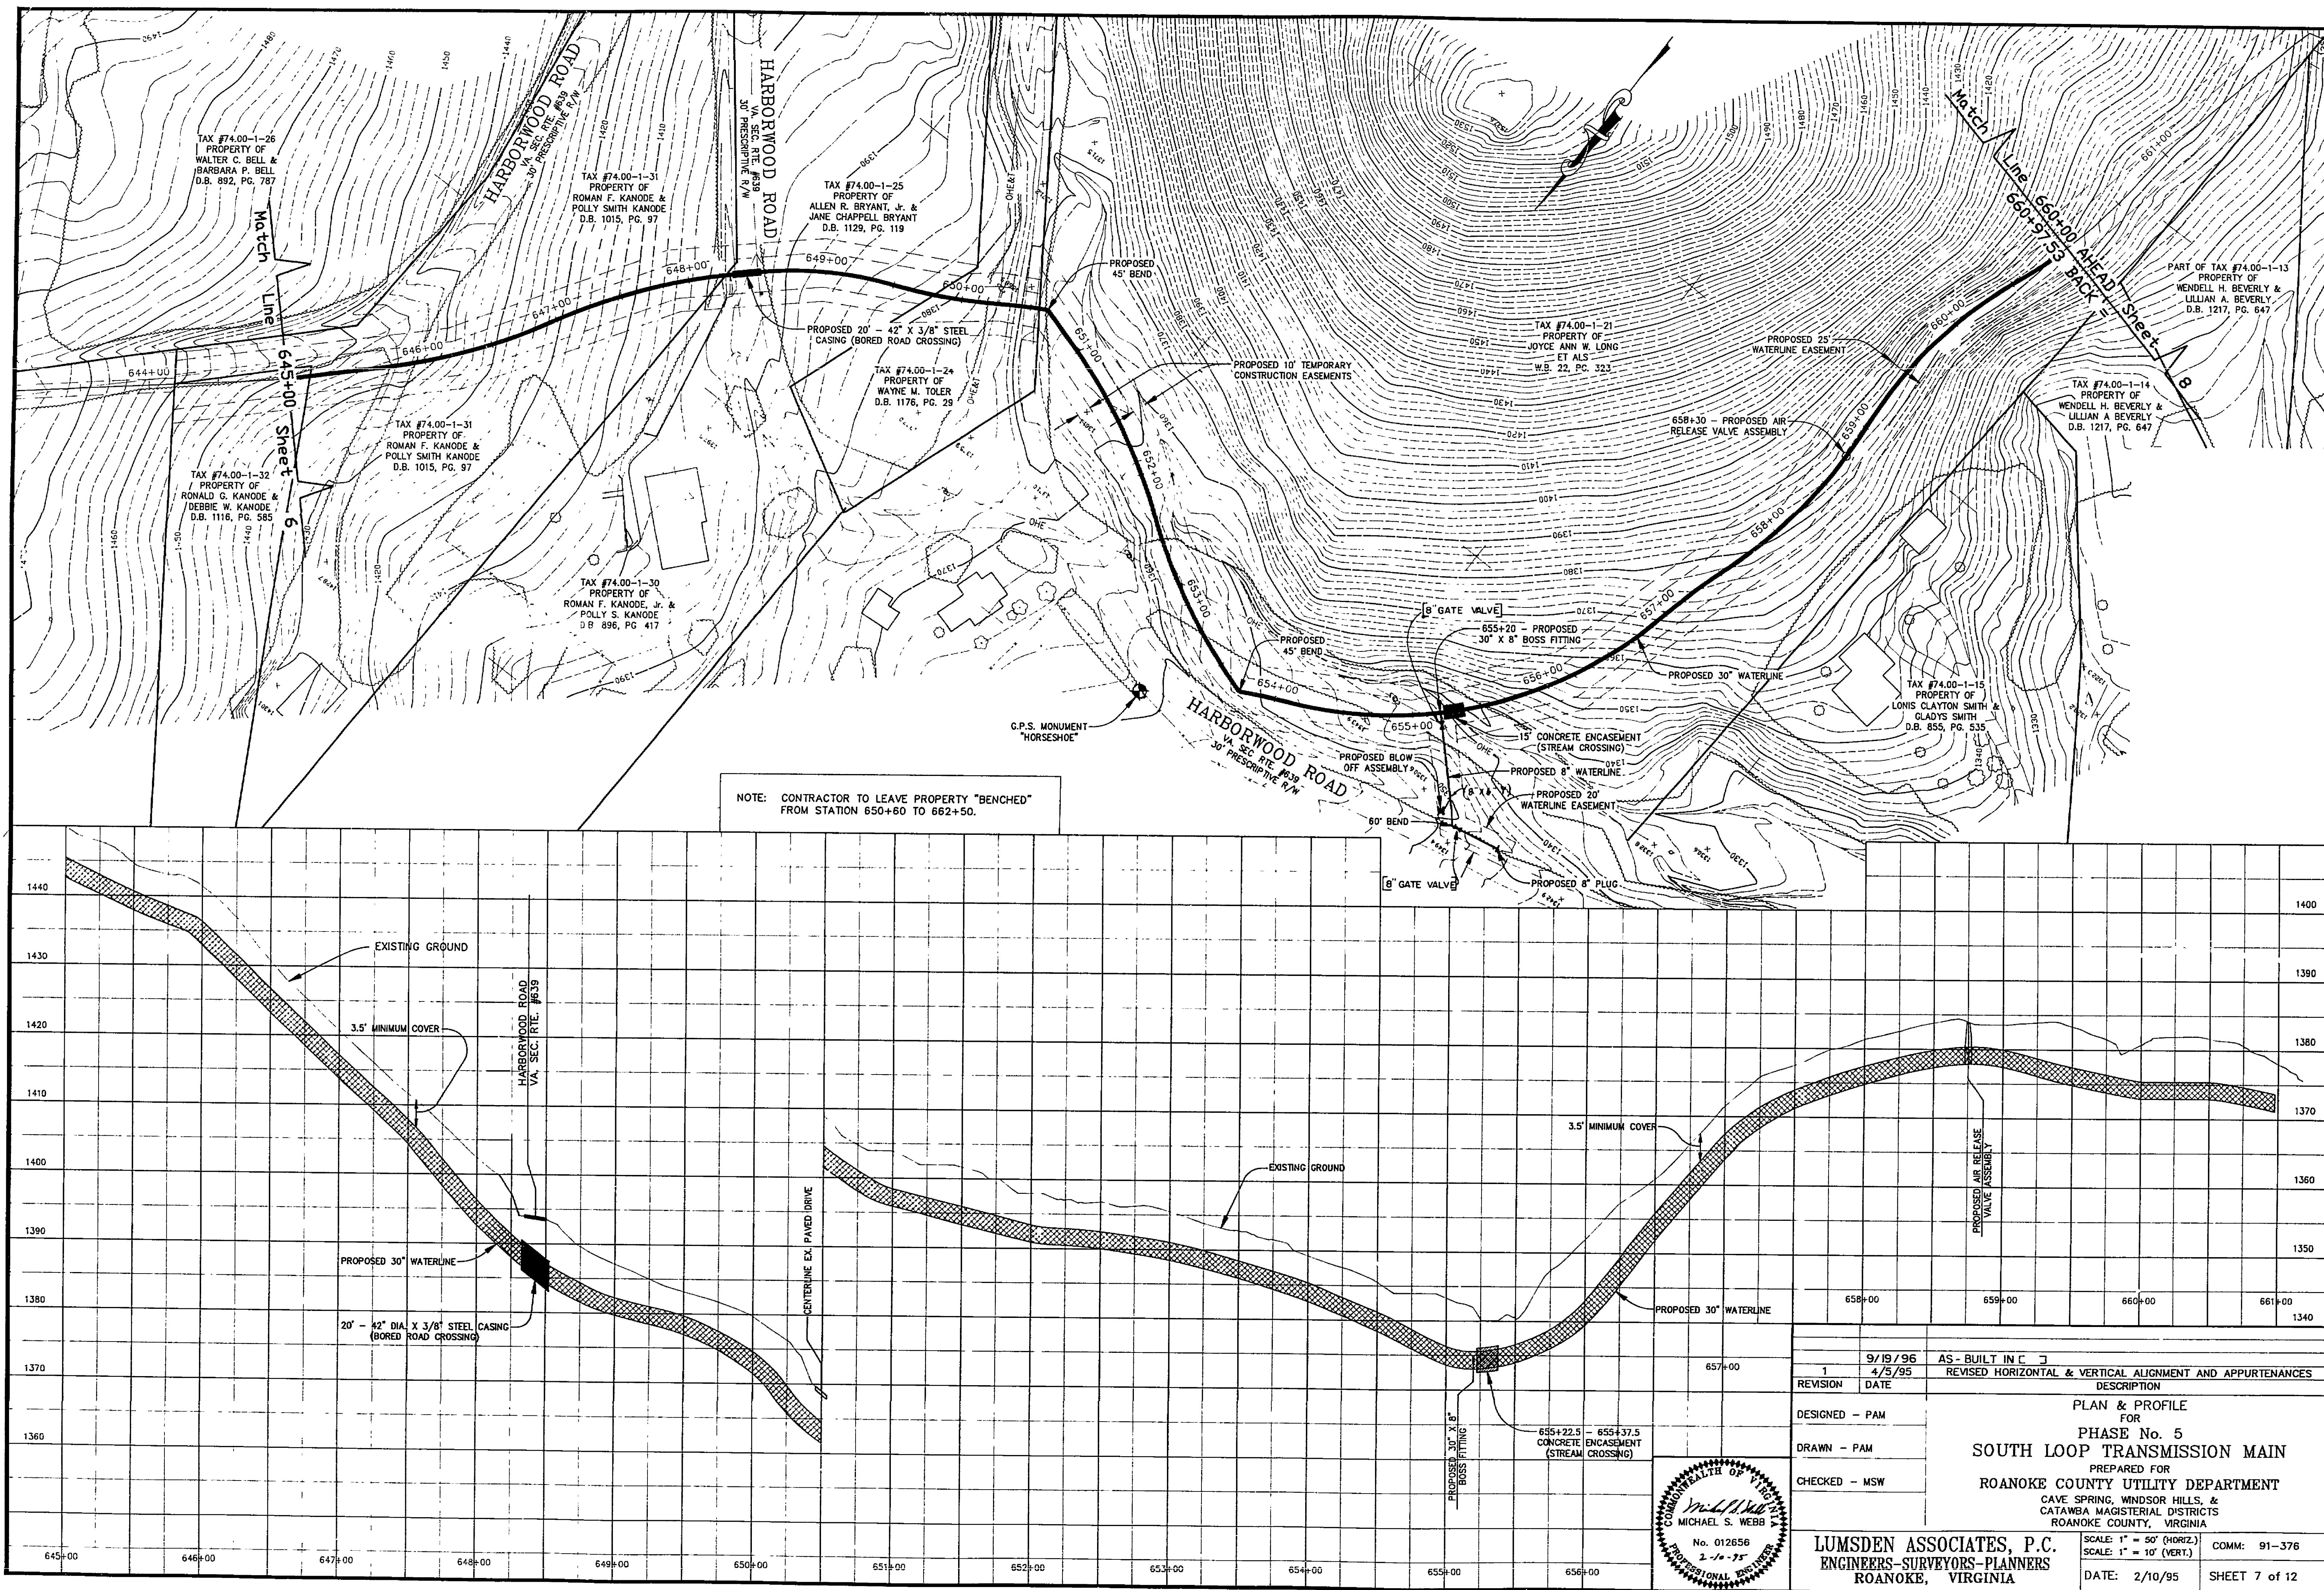

1	9/19/96	AS - BUILT IN C
REVISION	DATE	DESCRIPTION
DESIGNED - PAM		PLAN & PROFILE FOR
DRAWN - PAM		PHASE No. 5
CHECKED - MSW		SOUTH LOOP TRANSMISSION MAIN
		PREPARED FOR
		ROANOKE COUNTY UTILITY DEPARTMENT
		CAVE SPRING, WINDSOR HILLS, &
		CATAWBA MAGISTERIAL DISTRICTS
		ROANOKE COUNTY, VIRGINIA
		SCALE: 1" = 50' (HORIZ.)
		SCALE: 1" = 10' (VERT.)
		DATE: 2/10/95
		SHEET 7 of 12

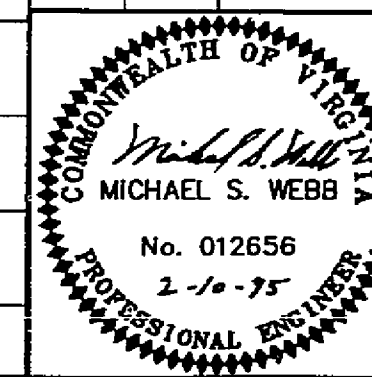

LUMSDEN ASSOCIATES, P.C.
ENGINEERS-SURVEYORS-PLANNERS
ROANOKE, VIRGINIA

WT-0521