



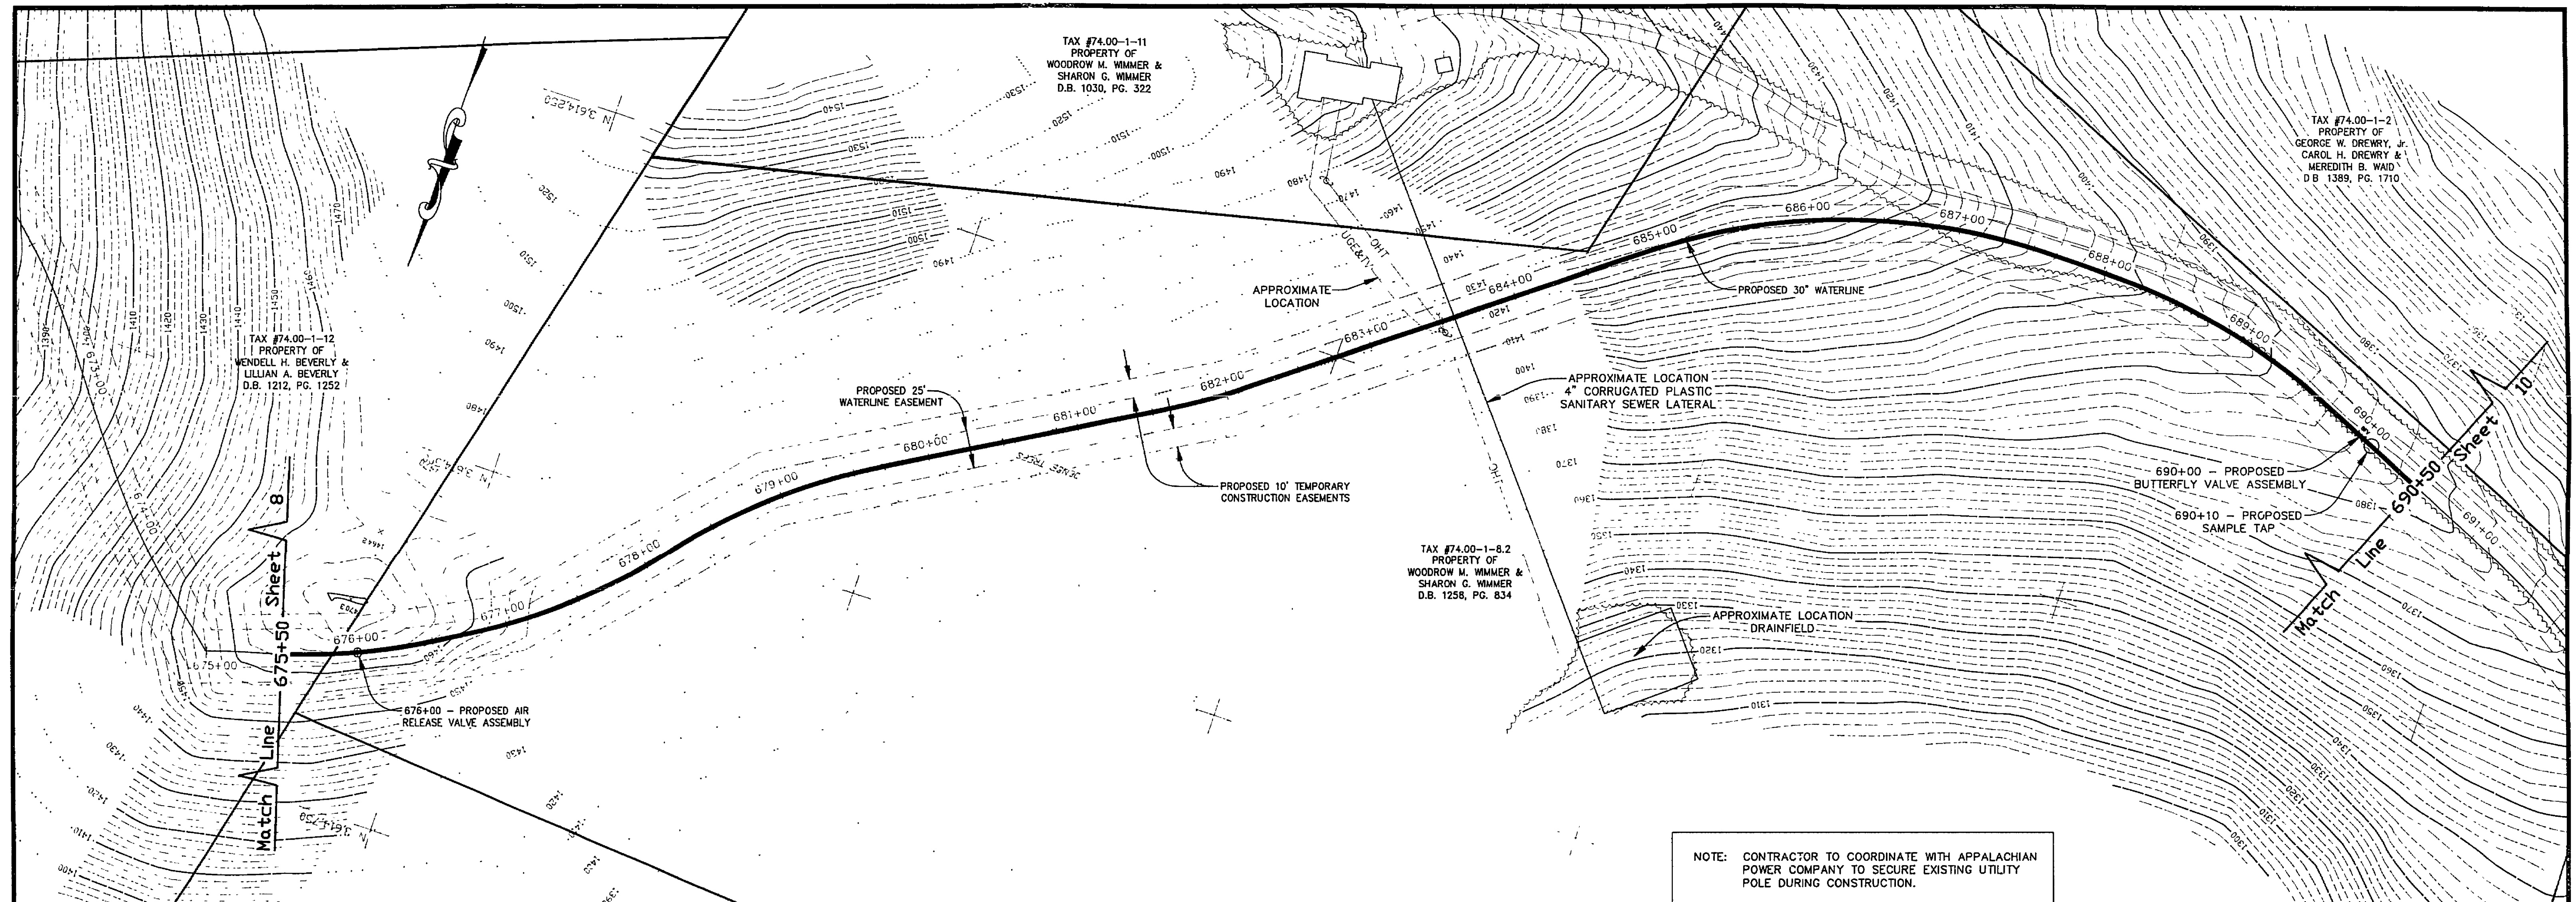


NOTE: CONTRACTOR TO COORDINATE WITH APPALACHIAN POWER COMPANY TO SECURE EXISTING UTILITY POLE DURING CONSTRUCTION.

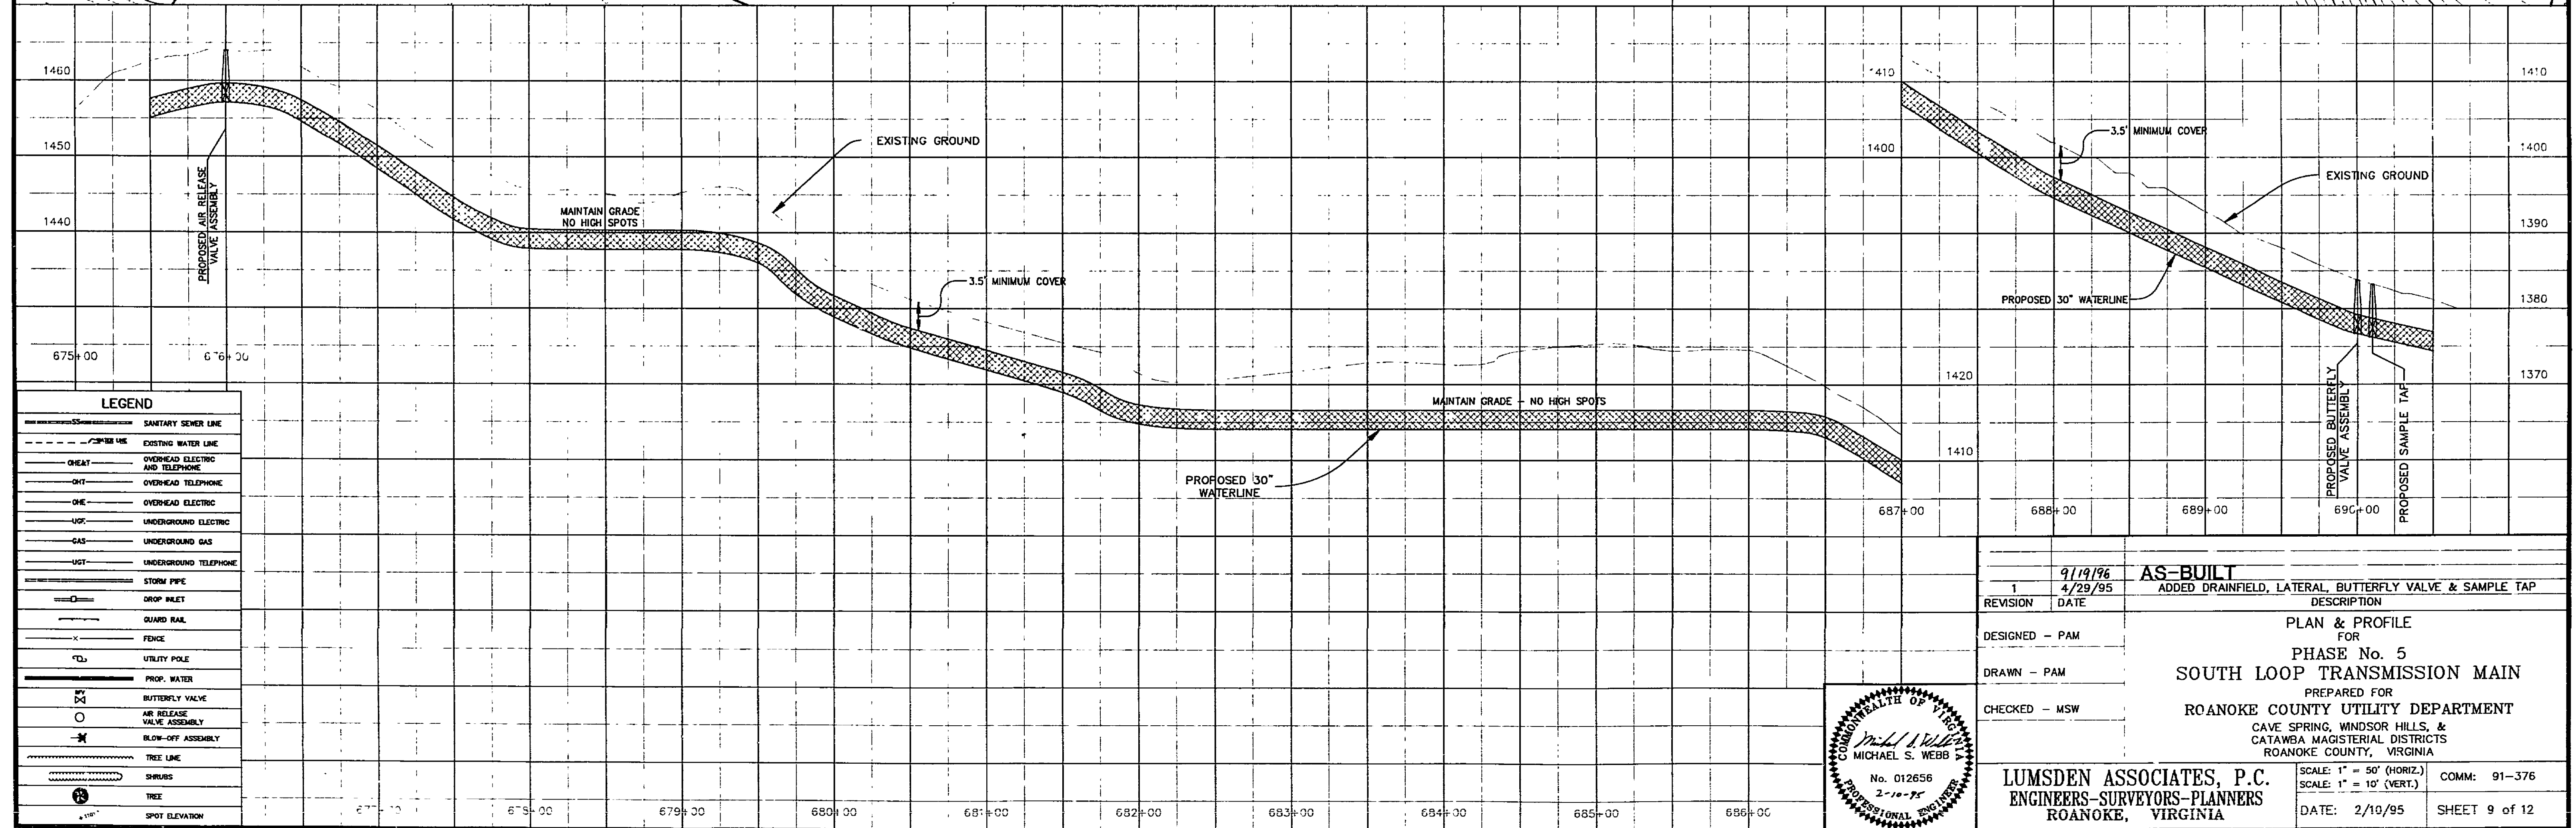

LEGEND

---	SANITARY SEWER LINE
---	EXISTING WATER LINE
---	OVERHEAD ELECTRIC AND TELEPHONE
---	OVERHEAD ELECTRIC
---	UNDERGROUND ELECTRIC
---	UNDERGROUND GAS
---	UNDERGROUND TELEPHONE
---	STORM PIPE
---	DROP INLET
---	GUARD RAIL
---	FENCE
---	UTILITY POLE
---	PROP. WATER
---	BUTTERFLY VALVE
---	AIR RELEASE VALVE ASSEMBLY
---	BLOW-OFF ASSEMBLY
---	TREE LINE
---	SHRUBS
---	TREE
---	SPOT ELEVATION

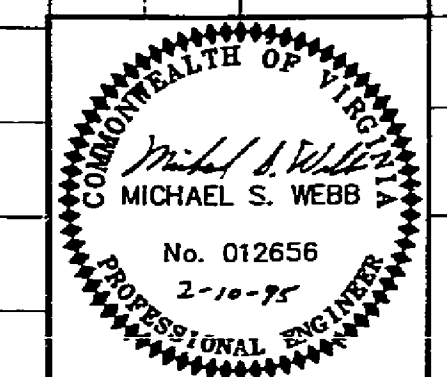

1	9/19/96	AS-BUILT
REVISION	DATE	
ADDED DRAINFIELD, LATERAL, BUTTERFLY VALVE & SAMPLE TAP		
DESCRIPTION		
DESIGNED - PAM		
DRAWN - PAM		
CHECKED - MSW		
LUMSDEN ASSOCIATES, P.C. ENGINEERS-SURVEYORS-PLANNERS ROANOKE, VIRGINIA		
SCALE: 1" = 50' (HORIZ.) SCALE: 1" = 10' (VERT.) DATE: 2/10/95		
COMM: 91-376 SHEET 9 of 12		