
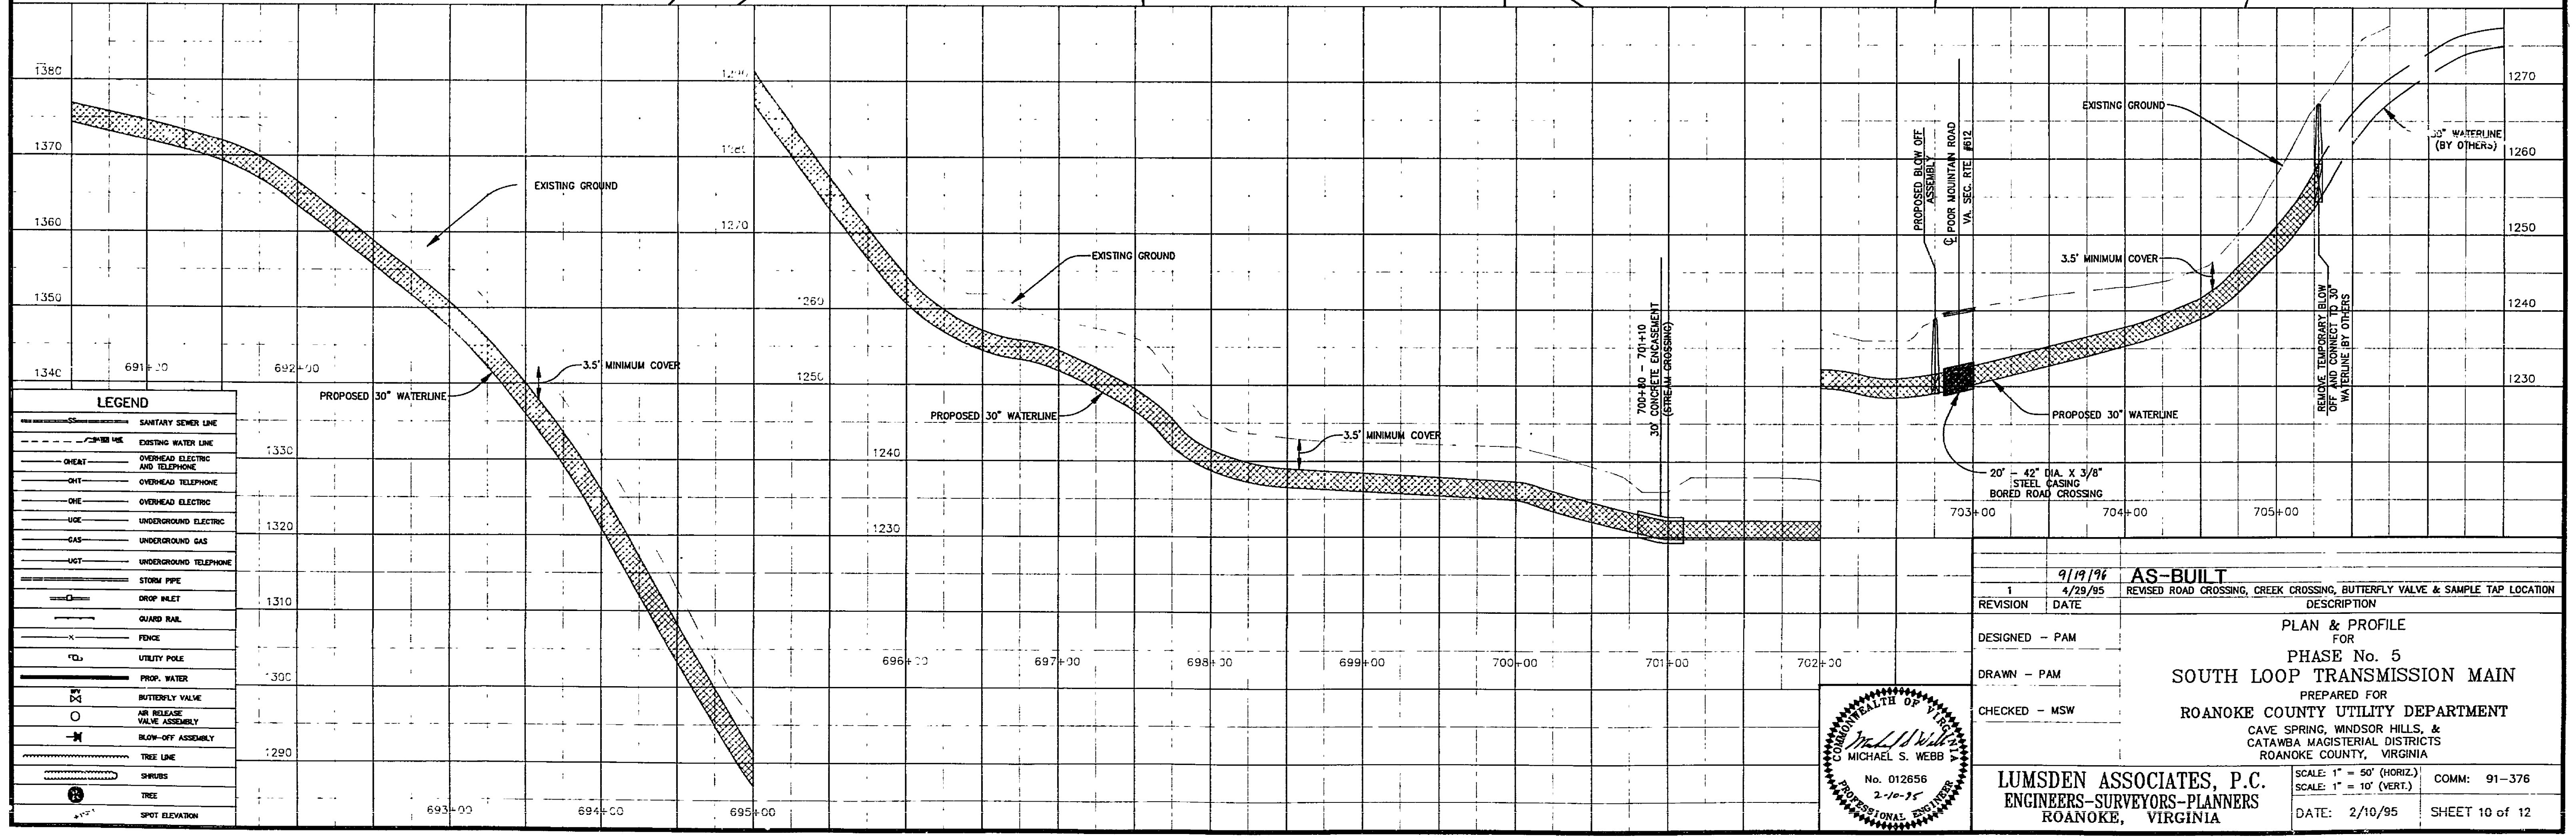


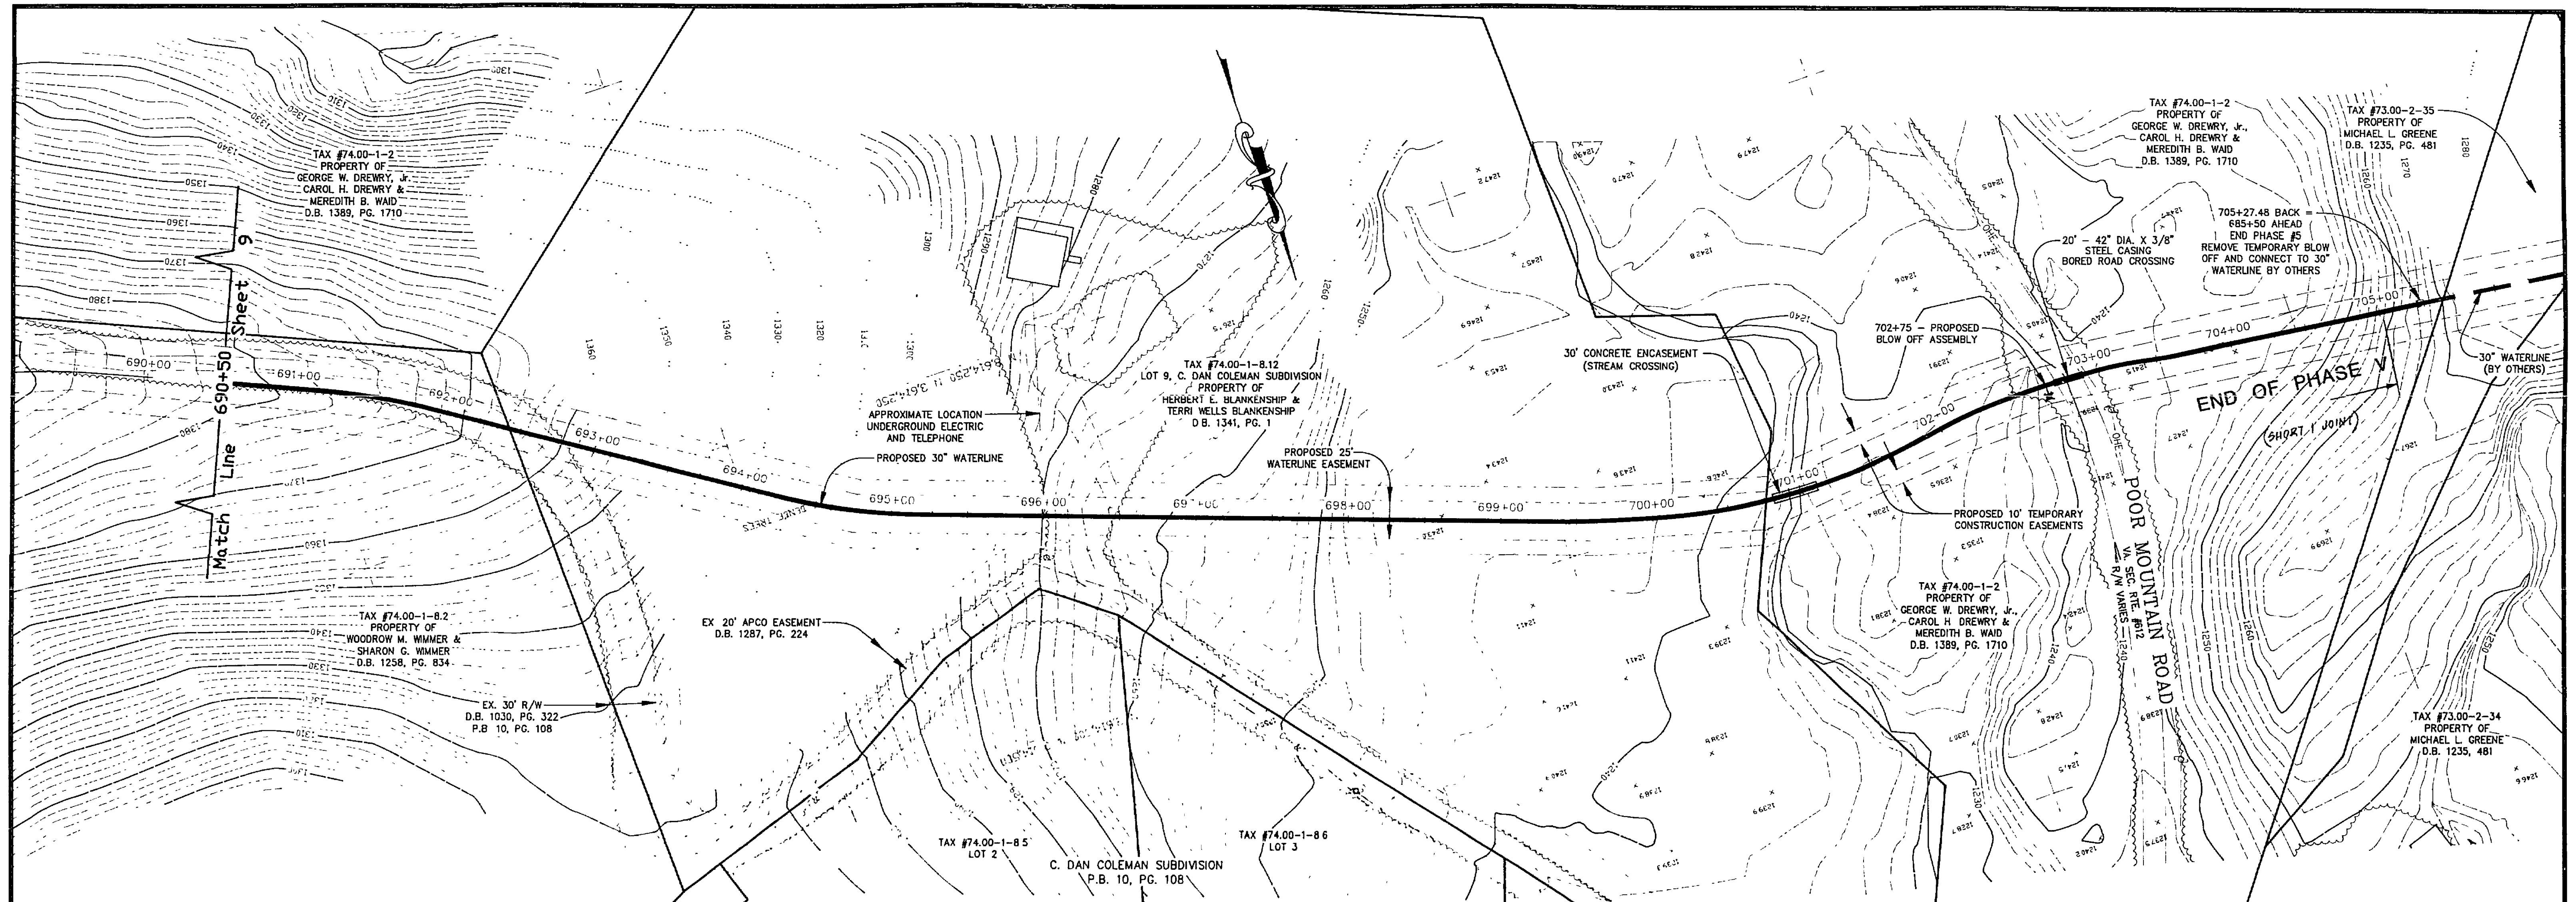

LEGEND

--- SANITARY SEWER LINE
--- EXISTING WATER LINE
--- OVERHEAD ELECTRIC AND TELEPHONE
--- OVERHEAD ELECTRIC
--- OVERHEAD TELEPHONE
--- UNDERGROUND ELECTRIC
--- UNDERGROUND GAS
--- UNDERGROUND TELEPHONE
--- STORM PIPE
--- DROP INLET
--- GUARD RAIL
--- FENCE
--- UTILITY POLE
--- PROP. WATER
--- BUTTERFLY VALVE
--- AIR RELEASE VALVE ASSEMBLY
--- BLOW-OFF ASSEMBLY
--- TREE LINE
--- SHRUBS
--- TREE
--- SPOT ELEVATION

9/19/96 1 REVISION DATE DESIGNED - PAM DRAWN - PAM CHECKED - MSW	AS-BUILT REVISED ROAD CROSSING, CREEK CROSSING, BUTTERFLY VALVE & SAMPLE TAP LOCATION DESCRIPTION PLAN & PROFILE FOR PHASE No. 5 SOUTH LOOP TRANSMISSION MAIN PREPARED FOR ROANOKE COUNTY UTILITY DEPARTMENT CAVE SPRING, WINDSOR HILLS, & CATAWBA MAGISTERIAL DISTRICTS ROANOKE COUNTY, VIRGINIA
--	--

Michael S. Webb
No. 012656
2-10-95

LUMSDEN ASSOCIATES, P.C.
ENGINEERS-SURVEYORS-PLANNERS
ROANOKE, VIRGINIA

SCALE: 1" = 50' (HORIZ.)
 SCALE: 1" = 10' (VERT.)
 DATE: 2/10/95
 COMM: 91-376
 SHEET 10 of 12