

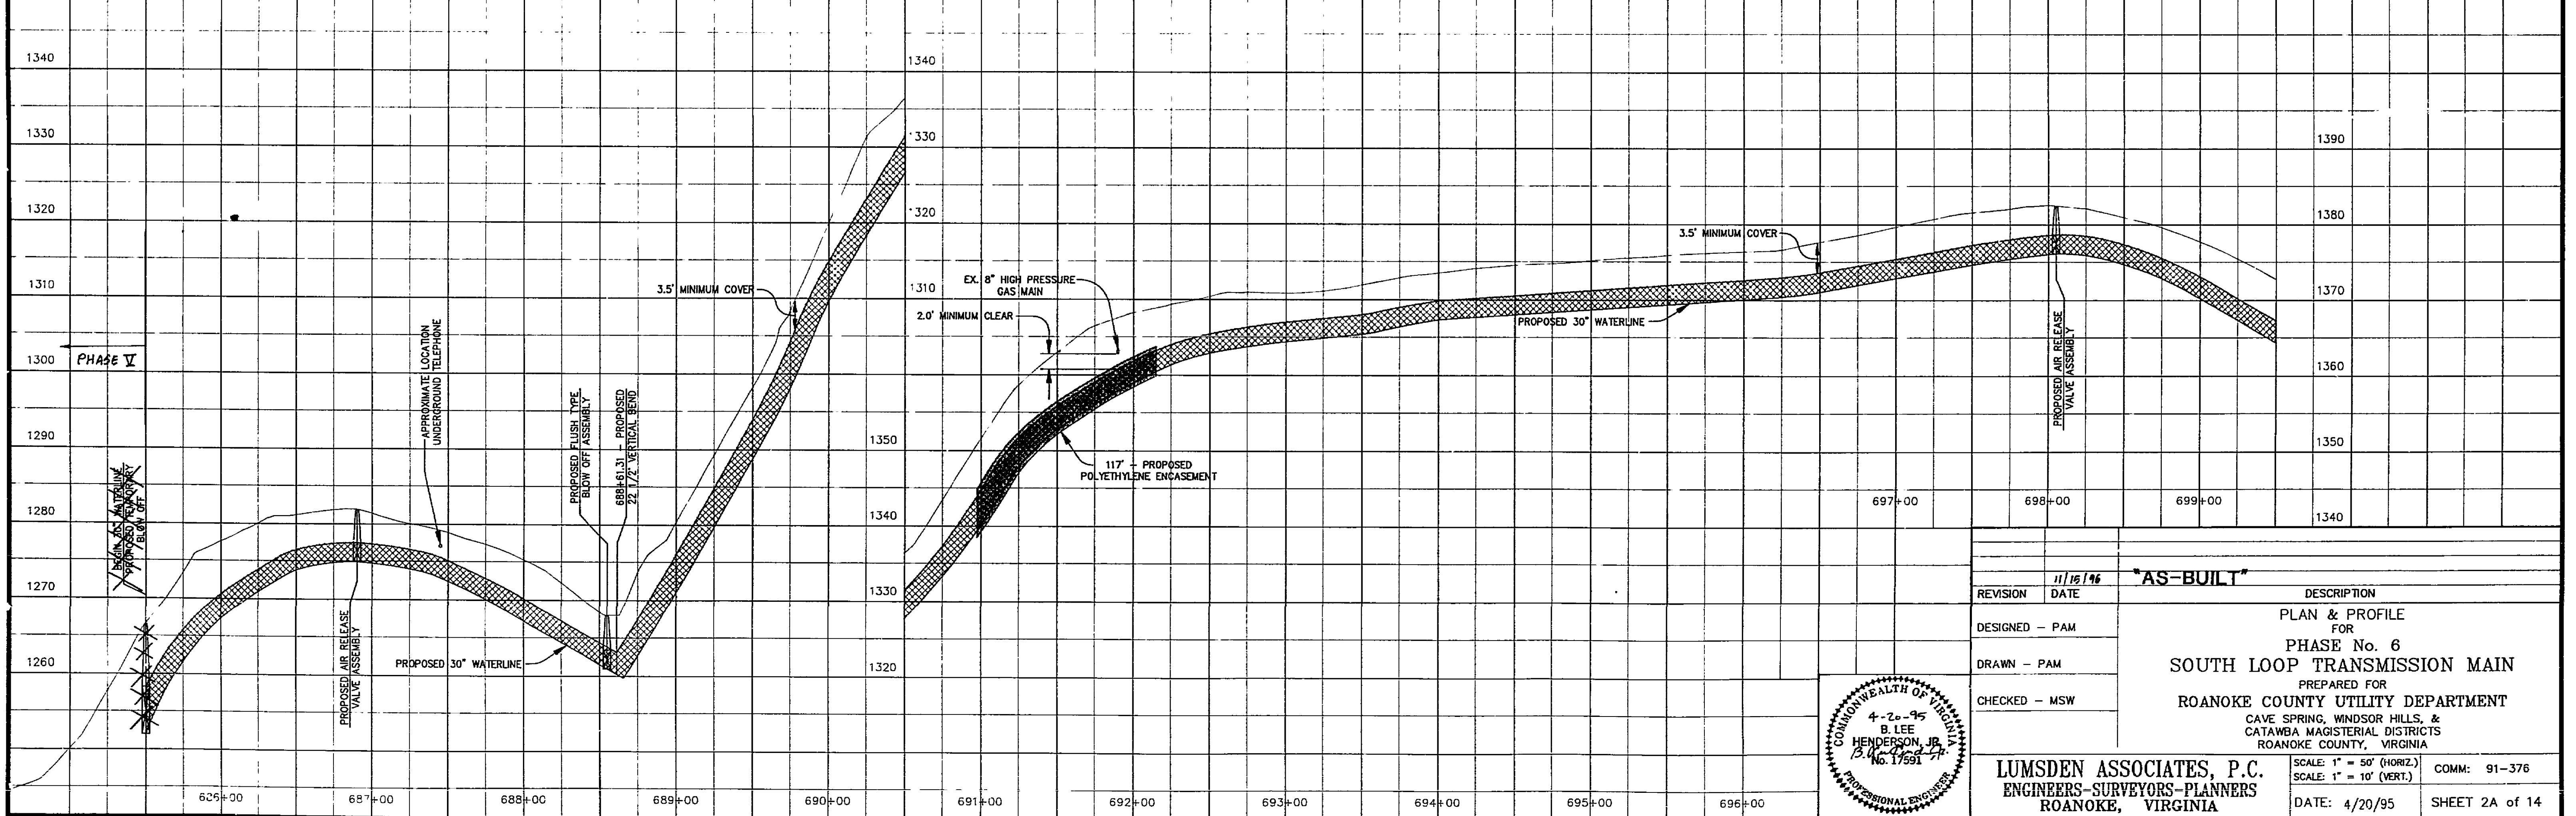


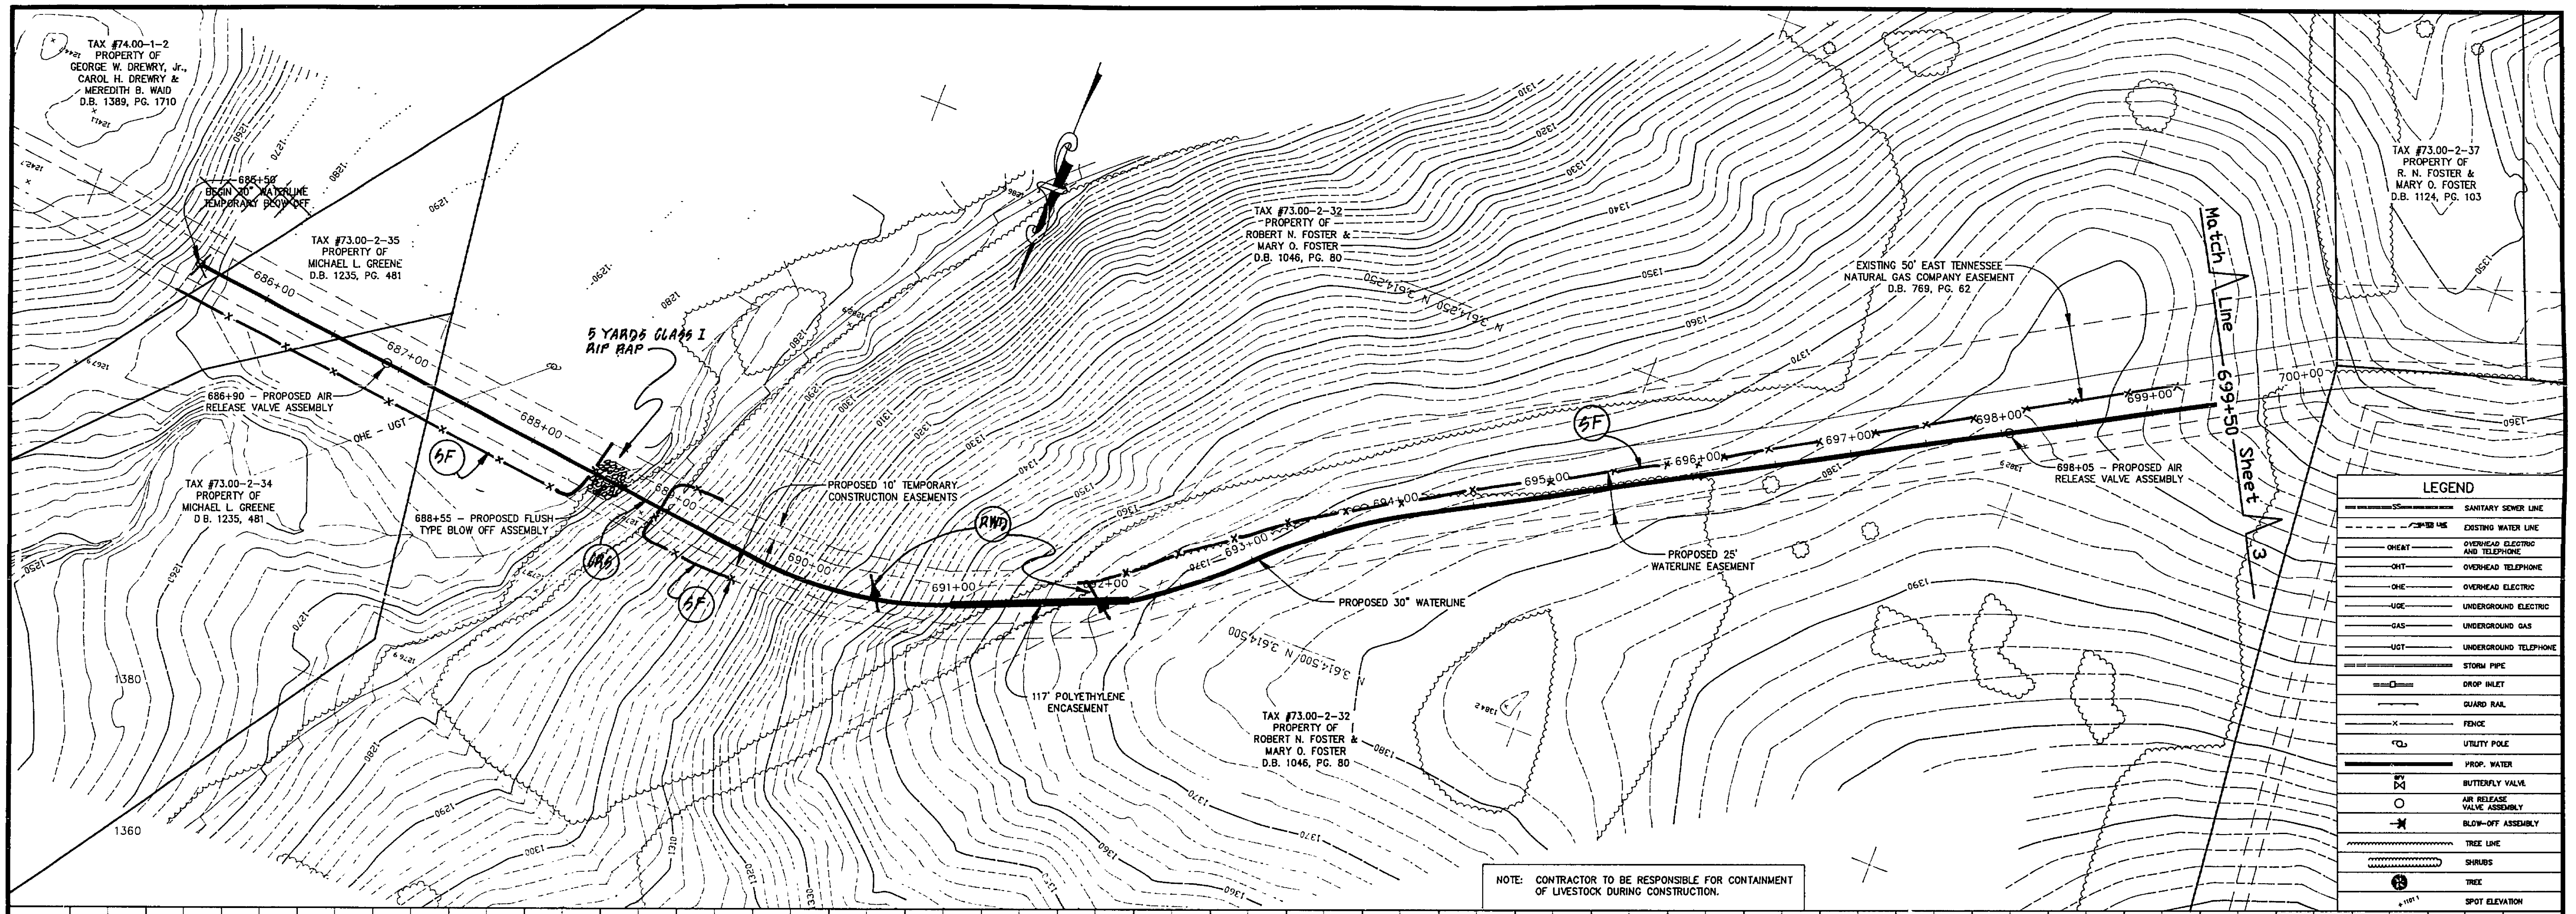

REVISION	11/16/96	DATE	11/16/96	DESCRIPTION	AS-BUILT
DESIGNED	PAM				
DRAWN	PAM				
CHECKED	MSW				
				PLAN & PROFILE FOR PHASE No. 6 SOUTH LOOP TRANSMISSION MAIN PREPARED FOR ROANOKE COUNTY UTILITY DEPARTMENT CAVE SPRING, WINDSOR HILLS, & CATAWBA MAGISTERIAL DISTRICTS ROANOKE COUNTY, VIRGINIA	
				SCALE: 1" = 50' (HORIZ.) SCALE: 1" = 10' (VERT.) DATE: 4/20/95	COMM: 91-376 SHEET 2A of 14

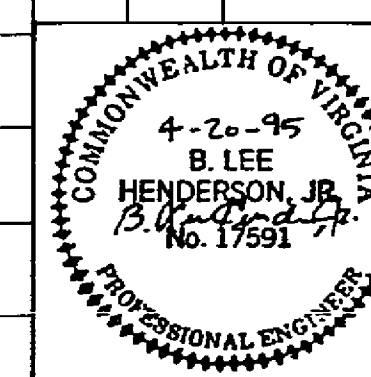

WT-0529