



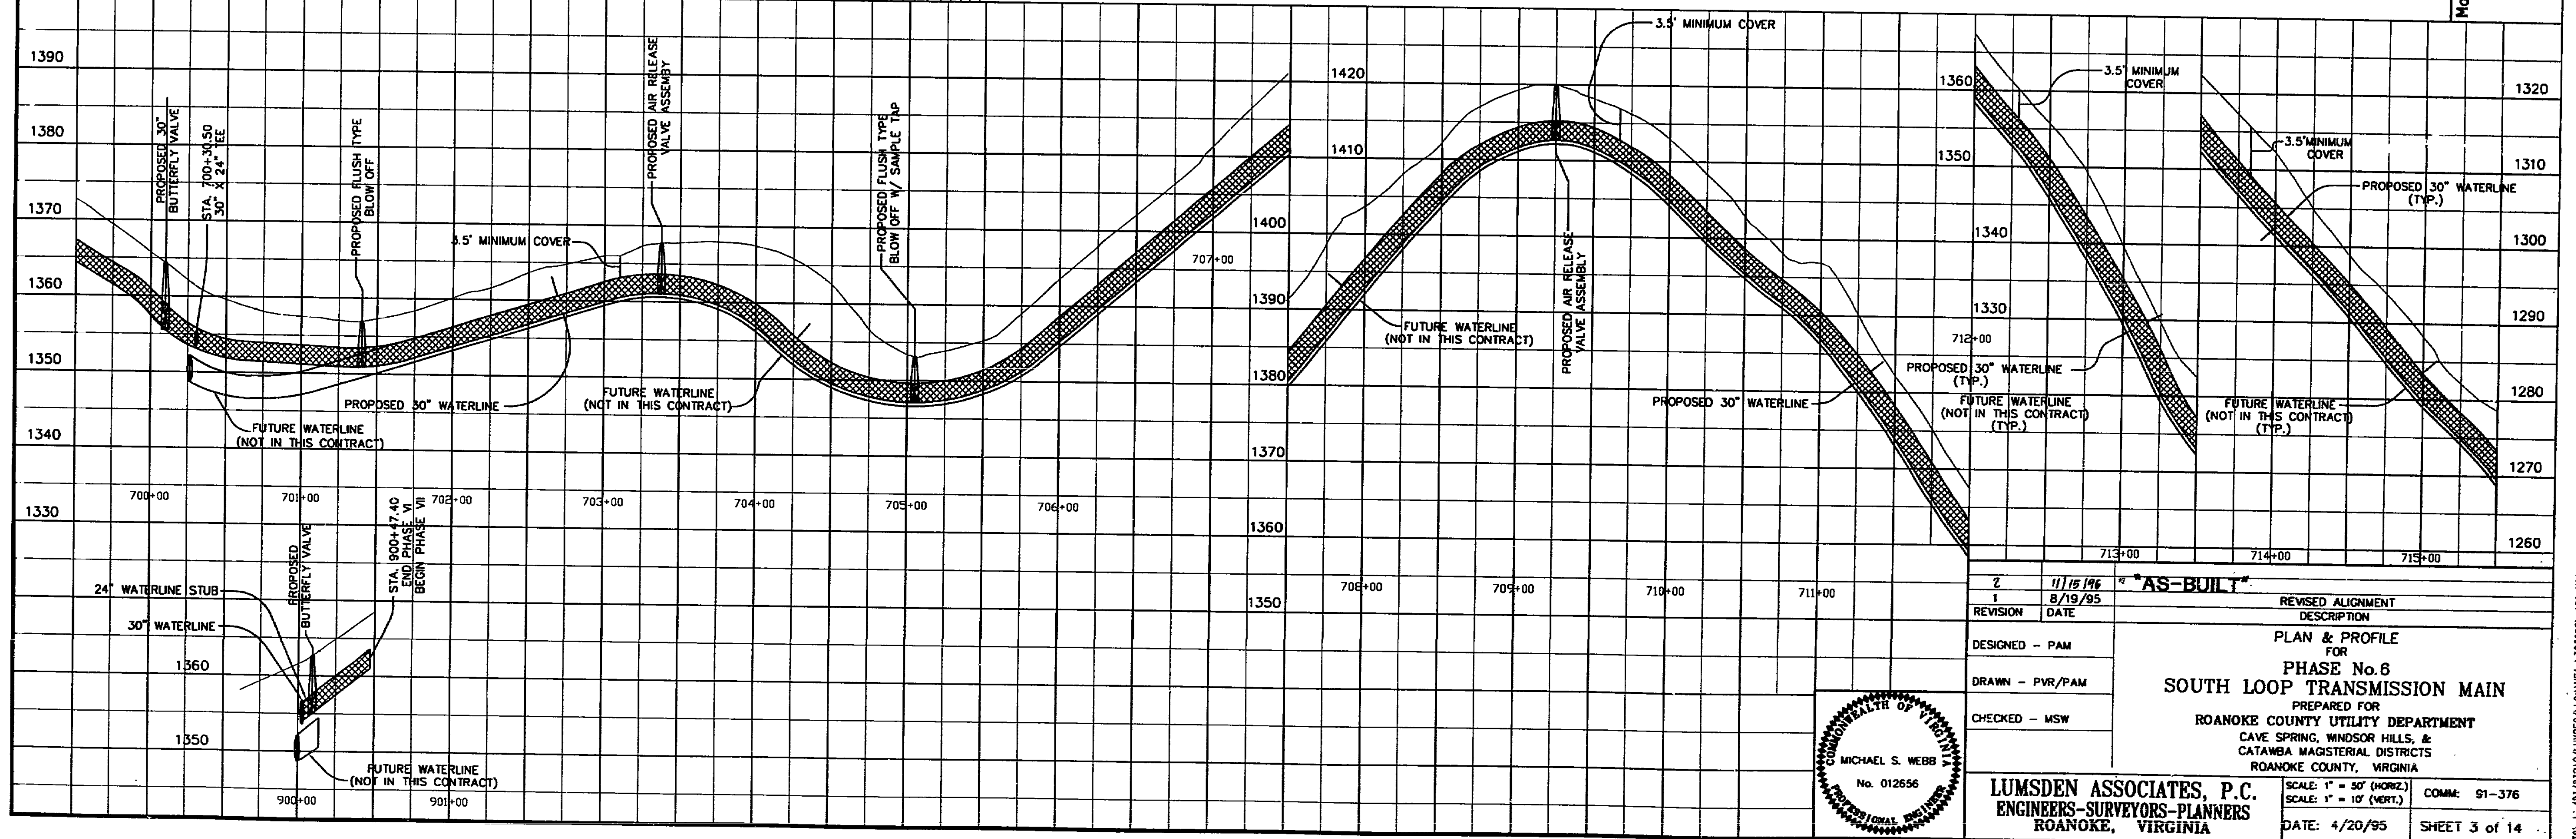

REVISION 1 11/18/96 8/19/95		AS-BUILT REVISED ALIGNMENT DESCRIPTION	
DESIGNED - PAM DRAWN - PVR/PAM CHECKED - MSW		PLAN & PROFILE FOR PHASE No. 6 SOUTH LOOP TRANSMISSION MAIN PREPARED FOR ROANOKE COUNTY UTILITY DEPARTMENT CAVE SPRING, WINDSOR HILLS, & CATAWBA MAGISTERIAL DISTRICTS ROANOKE COUNTY, VIRGINIA	
SCALE: 1" = 30' (HORIZ.) SCALE: 1" = 10' (VERT.)		COMM: 91-376 DATE: 4/20/95 SHEET 3 of 14	

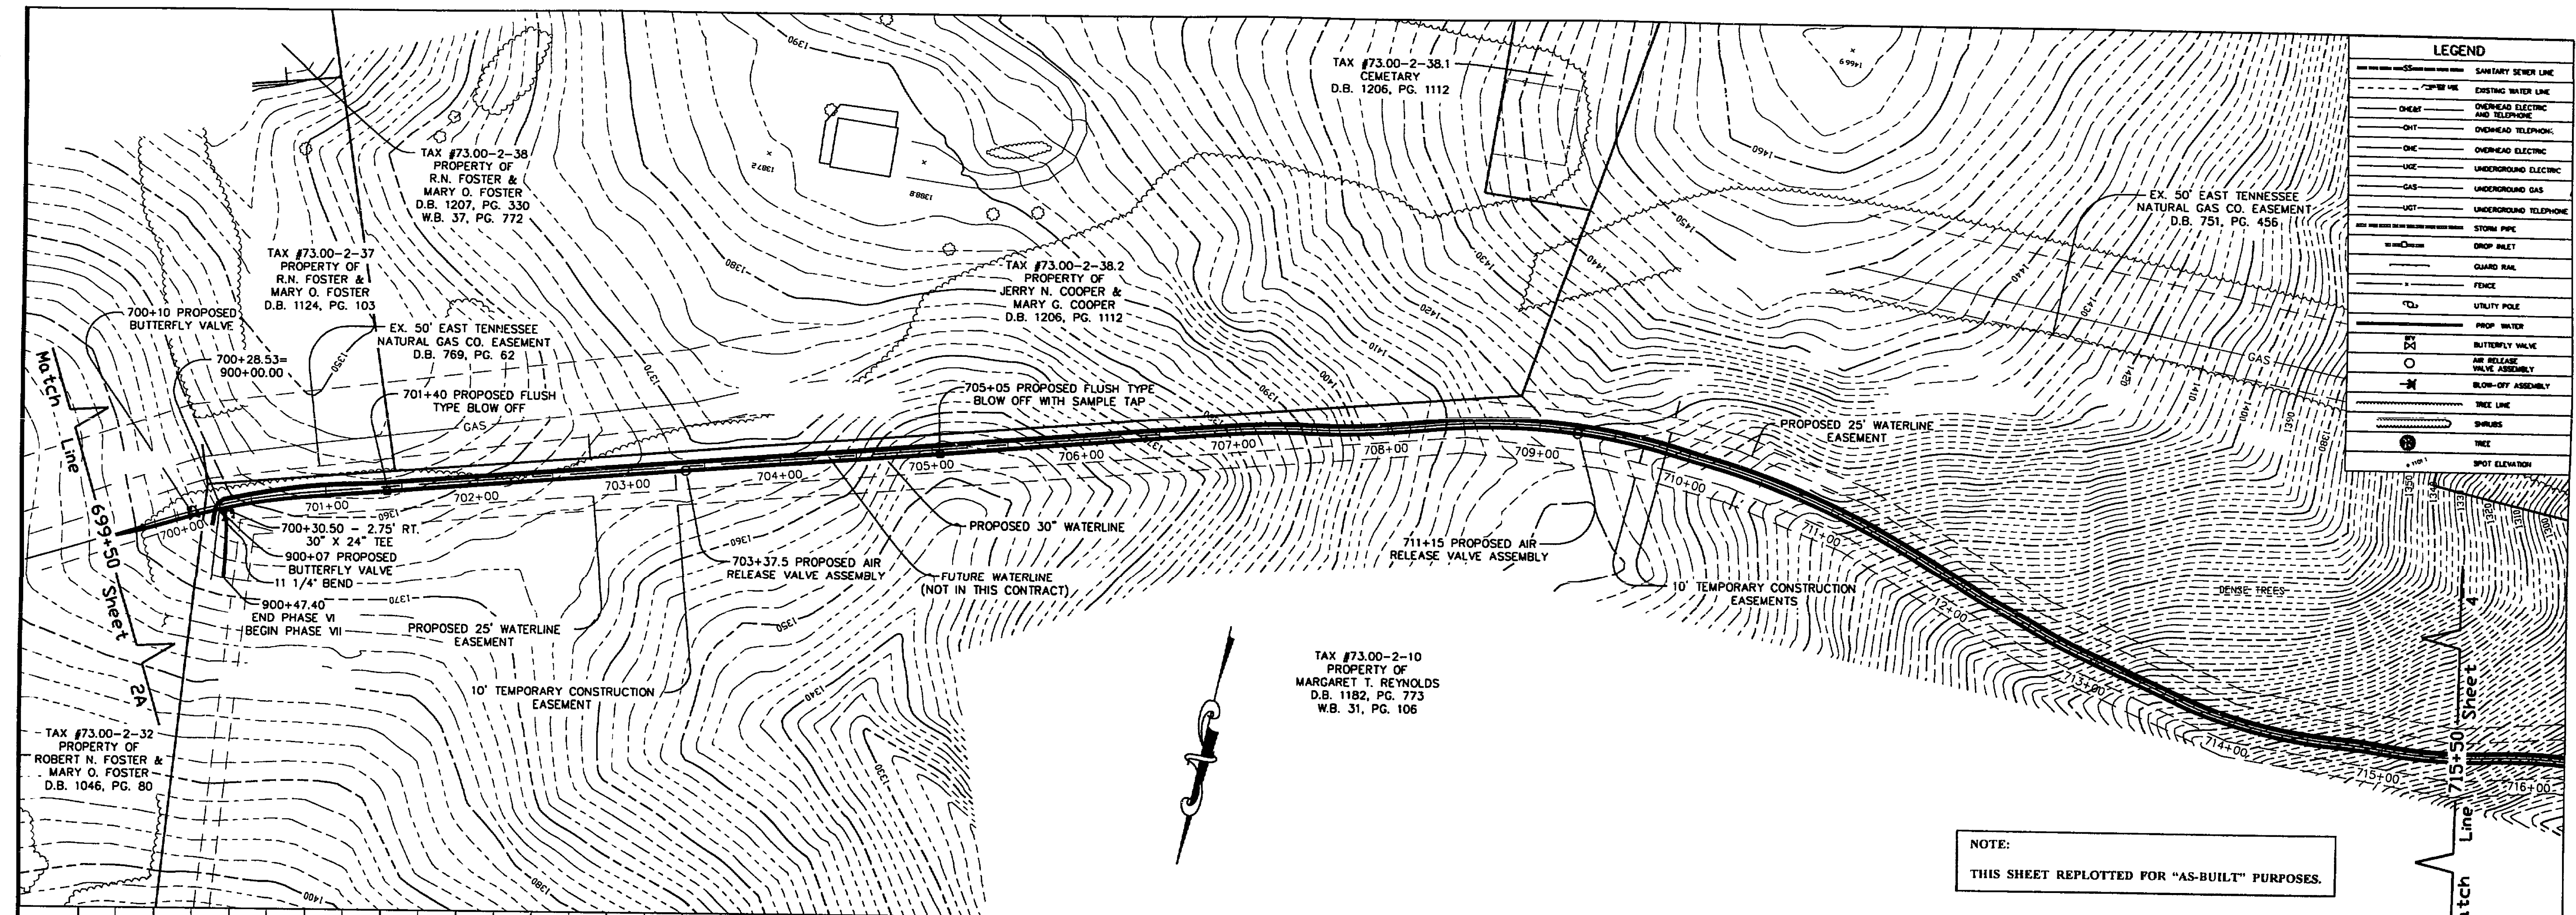