
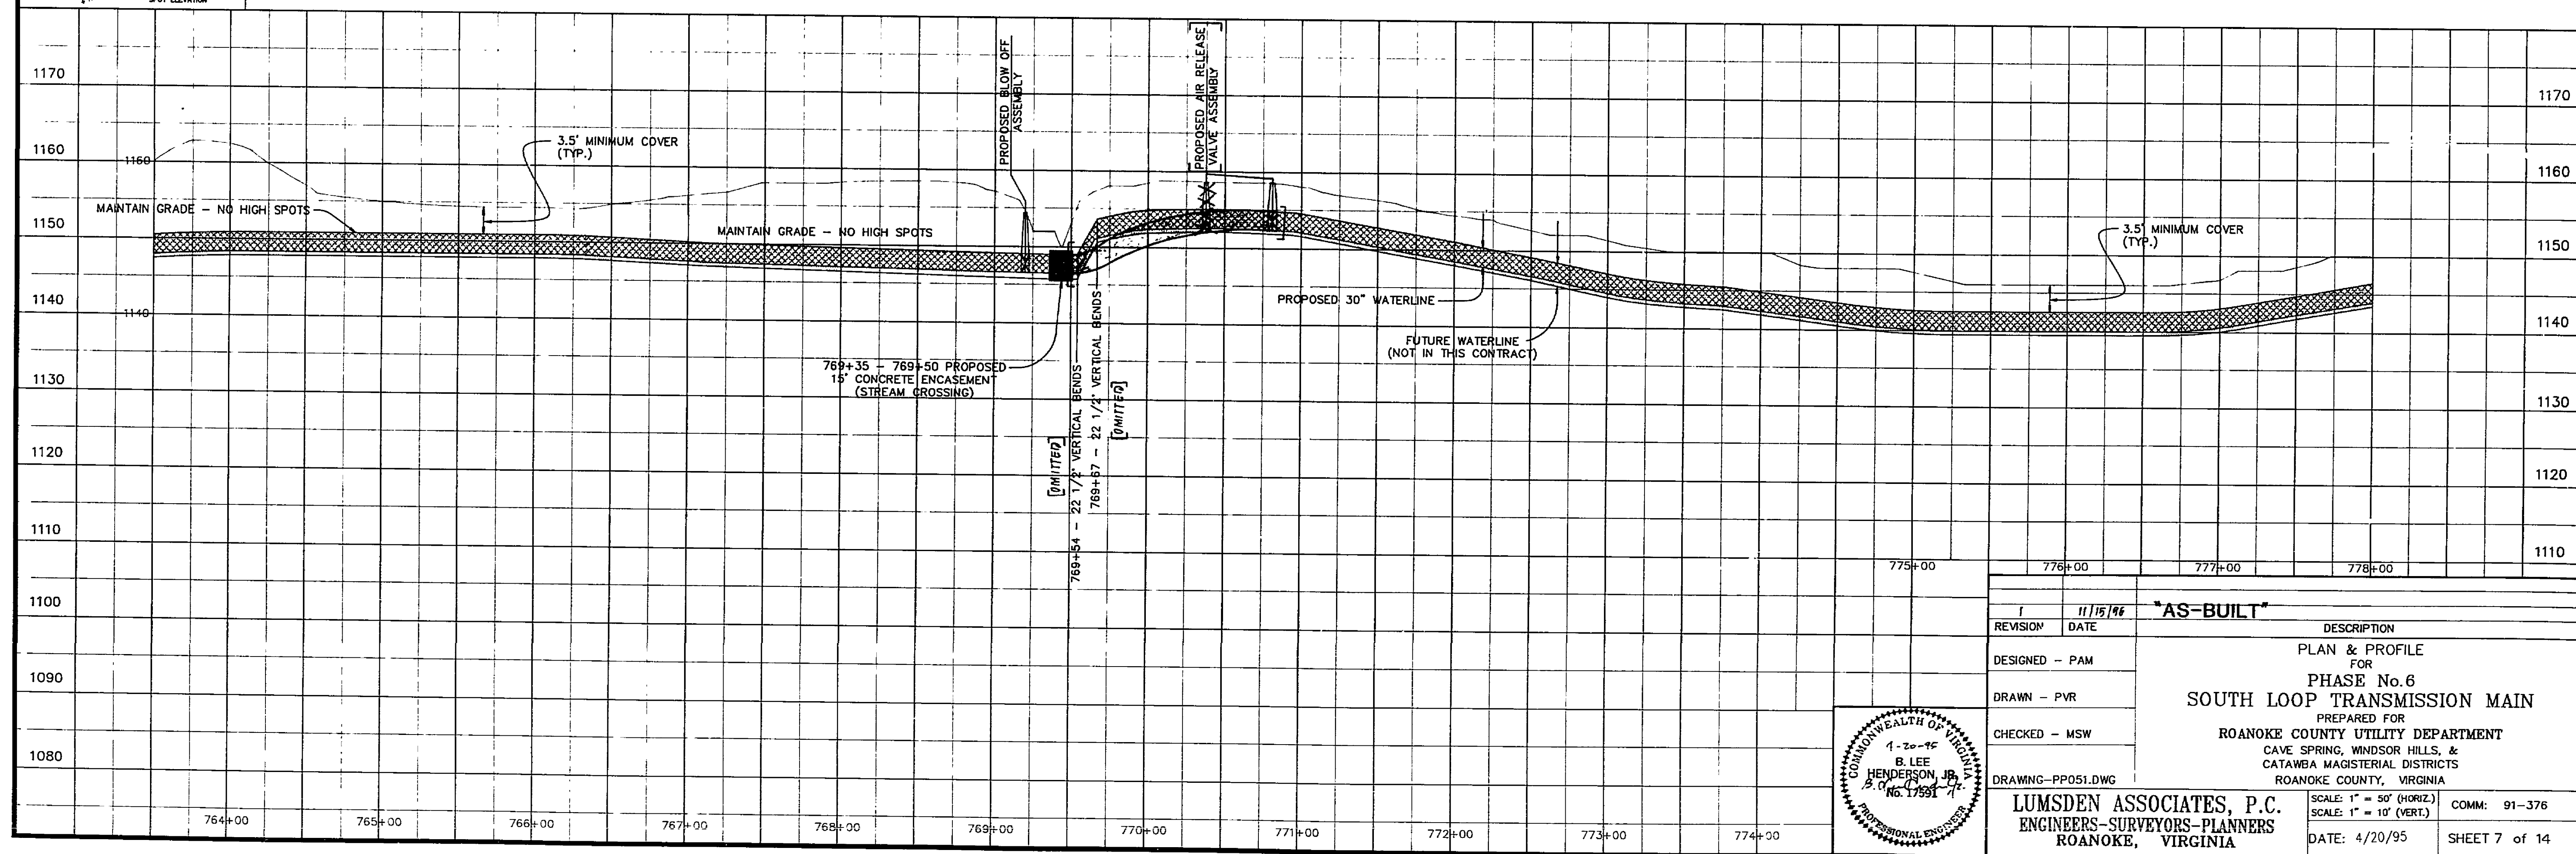


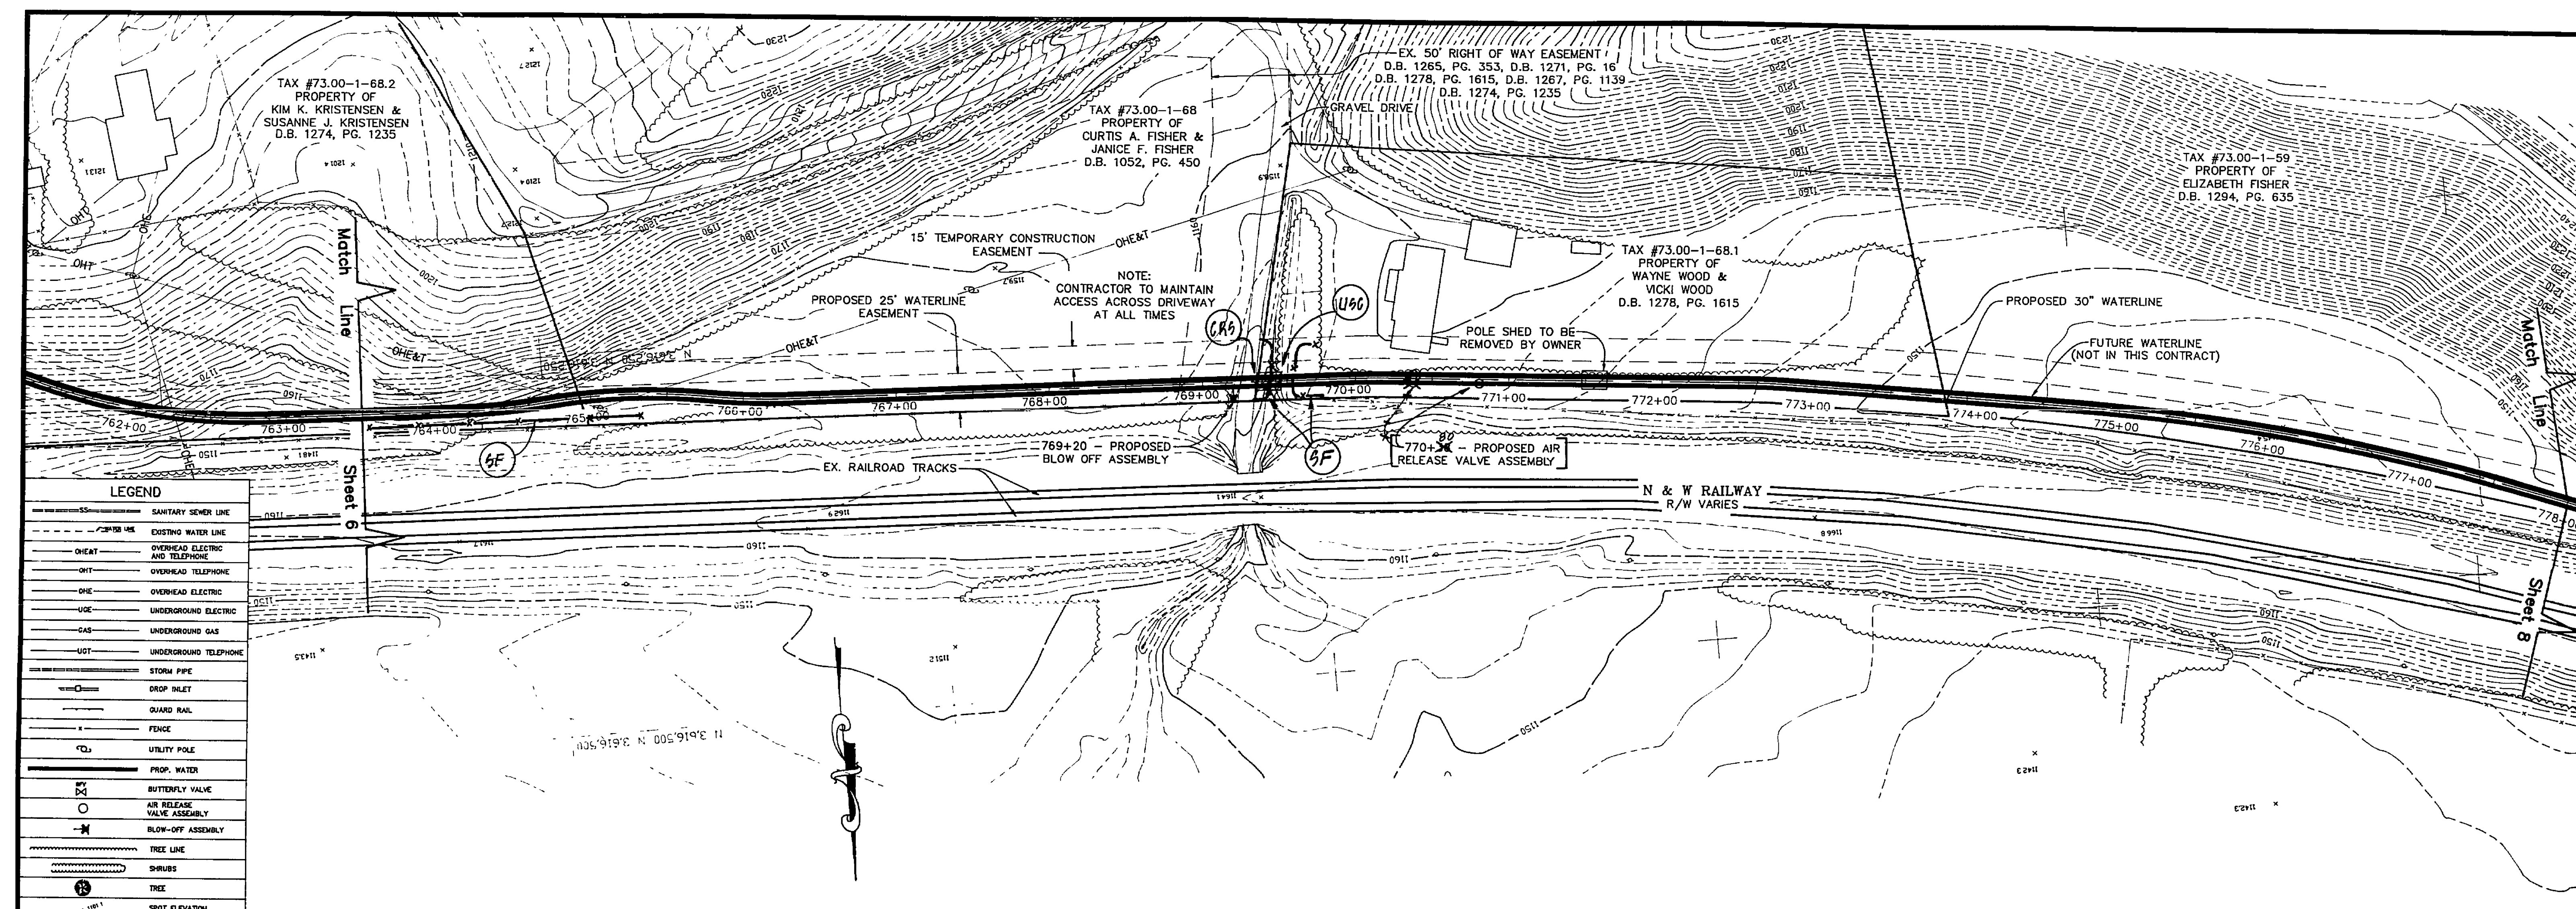

REVISION		DATE	DESCRIPTION
1		11/15/96	AS-BUILT
DESIGNED - PAM			
DRAWN - PVR			
CHECKED - MSW			
DRAWING - PP051.DWG			
LUMSDEN ASSOCIATES, P.C. ENGINEERS-SURVEYORS-PLANNERS ROANOKE, VIRGINIA			
SCALE: 1" = 50' (HORIZ.) SCALE: 1" = 10' (VERT.)		DATE: 4/20/95	
COMM: 91-376		SHEET 7 of 14	