

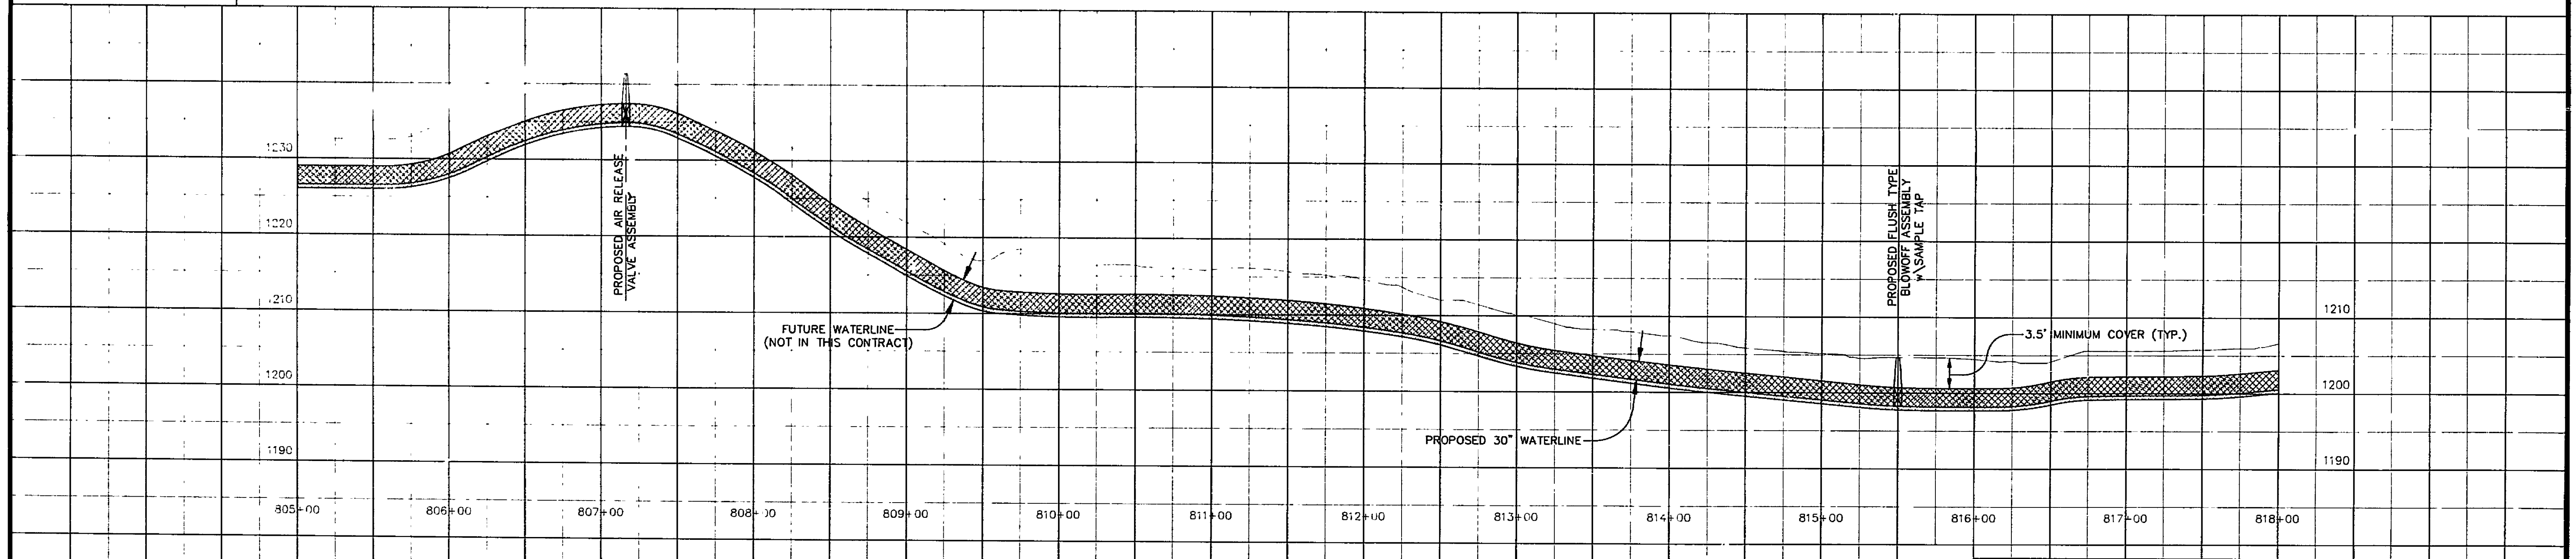


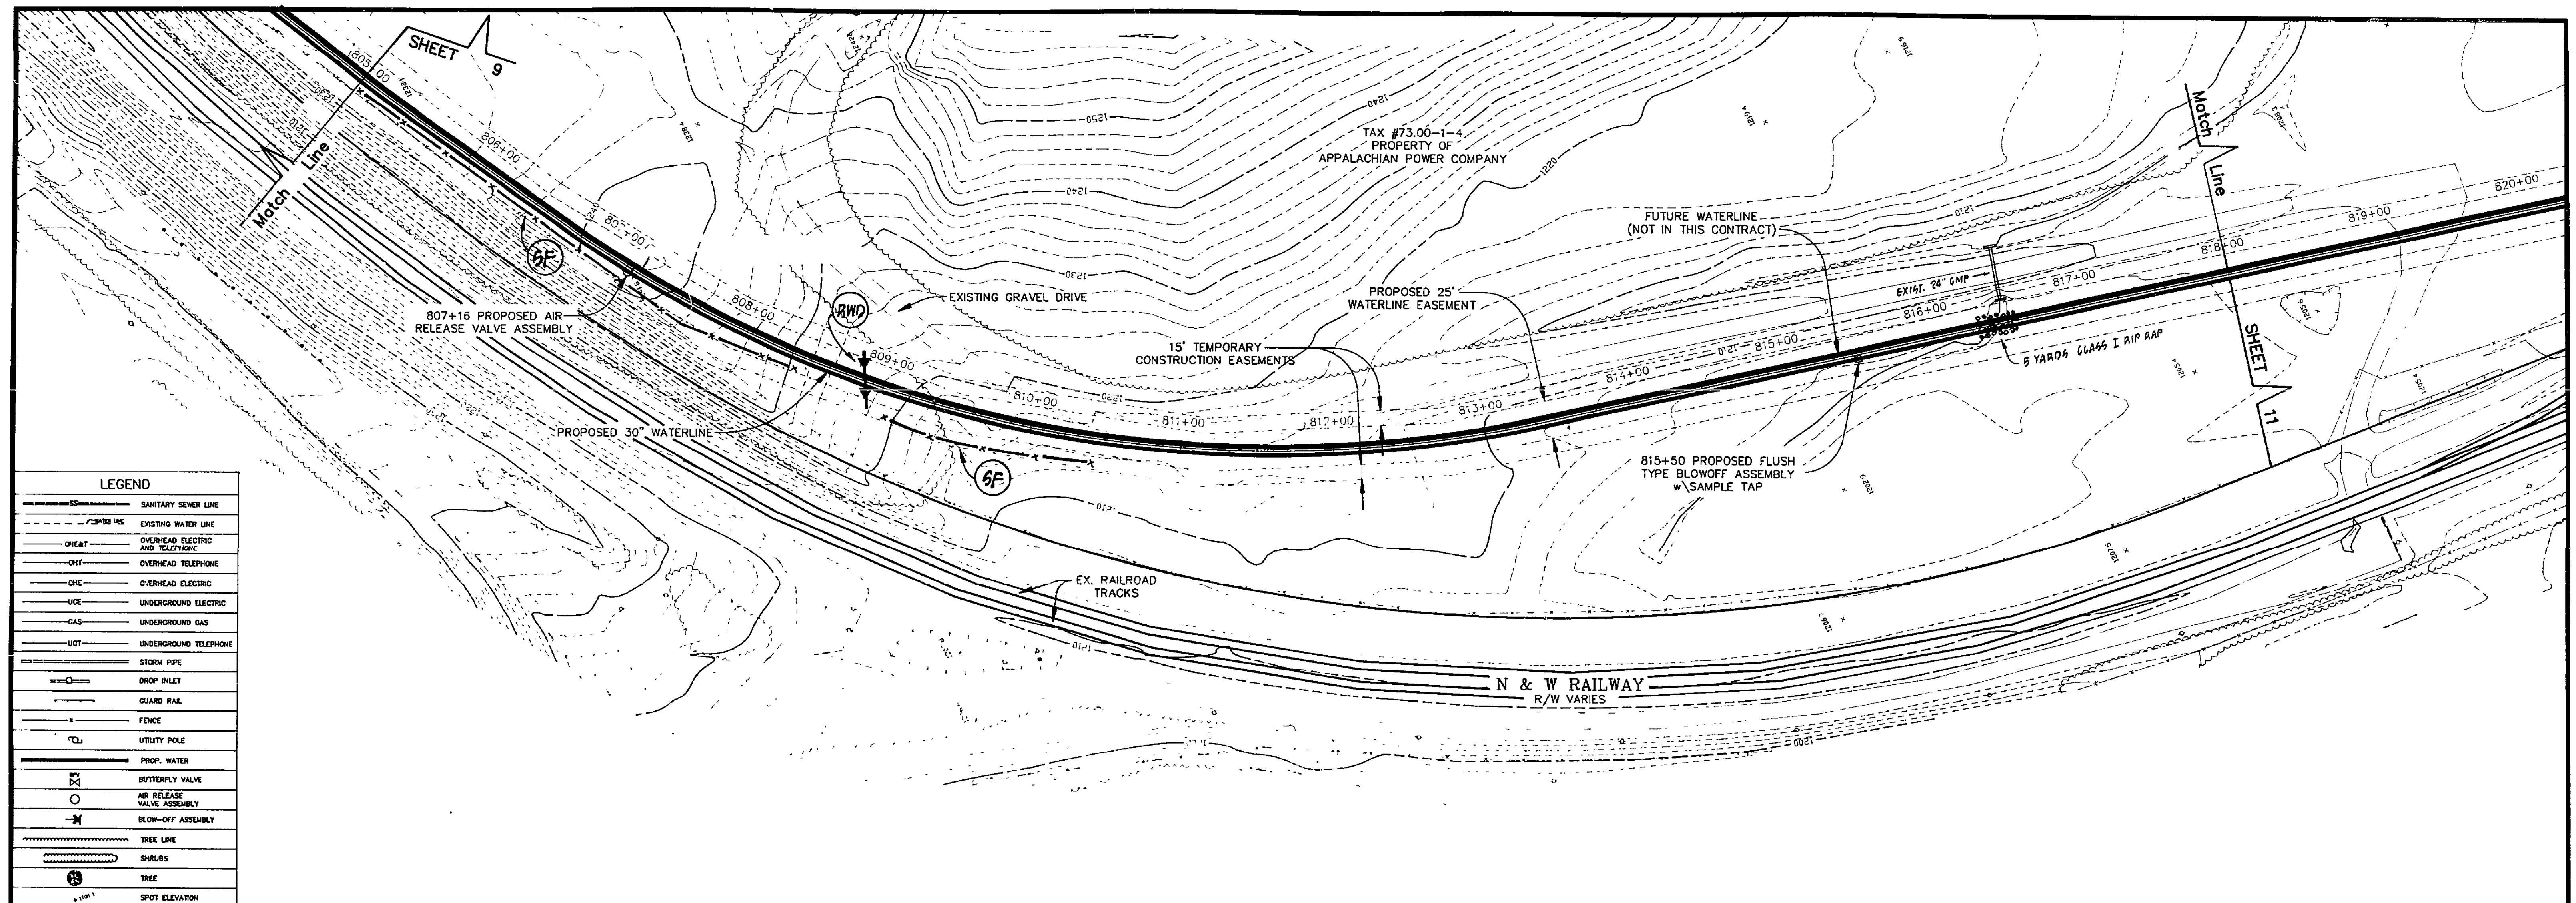

1	11/15/96	"AS-BUILT"	DESCRIPTION
REVISION	DATE		PLAN & PROFILE
DESIGNED - PAM			FOR
DRAWN - PVR/JNG			PHASE No.6
CHECKED - MSW			SOUTH LOOP TRANSMISSION MAIN
			PREPARED FOR
			ROANOKE COUNTY UTILITY DEPARTMENT
			CAVE SPRING, WINDSOR HILLS, &
			CATAWBA MAGISTERIAL DISTRICTS
			ROANOKE COUNTY, VIRGINIA
			SCALE: 1" = 50' (HORIZ.)
			SCALE: 1" = 10' (VERT.)
			DATE: 4/20/95
			COMM: 91-376
			SHEET 10 of 14

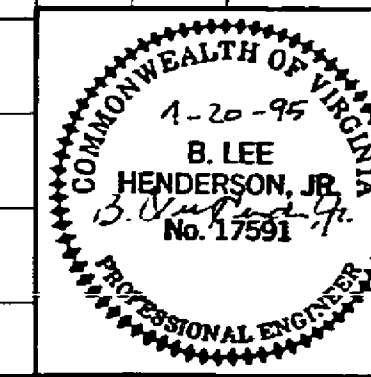

LUMSDEN ASSOCIATES, P.C.
ENGINEERS-SURVEYORS-PLANNERS
ROANOKE, VIRGINIA