
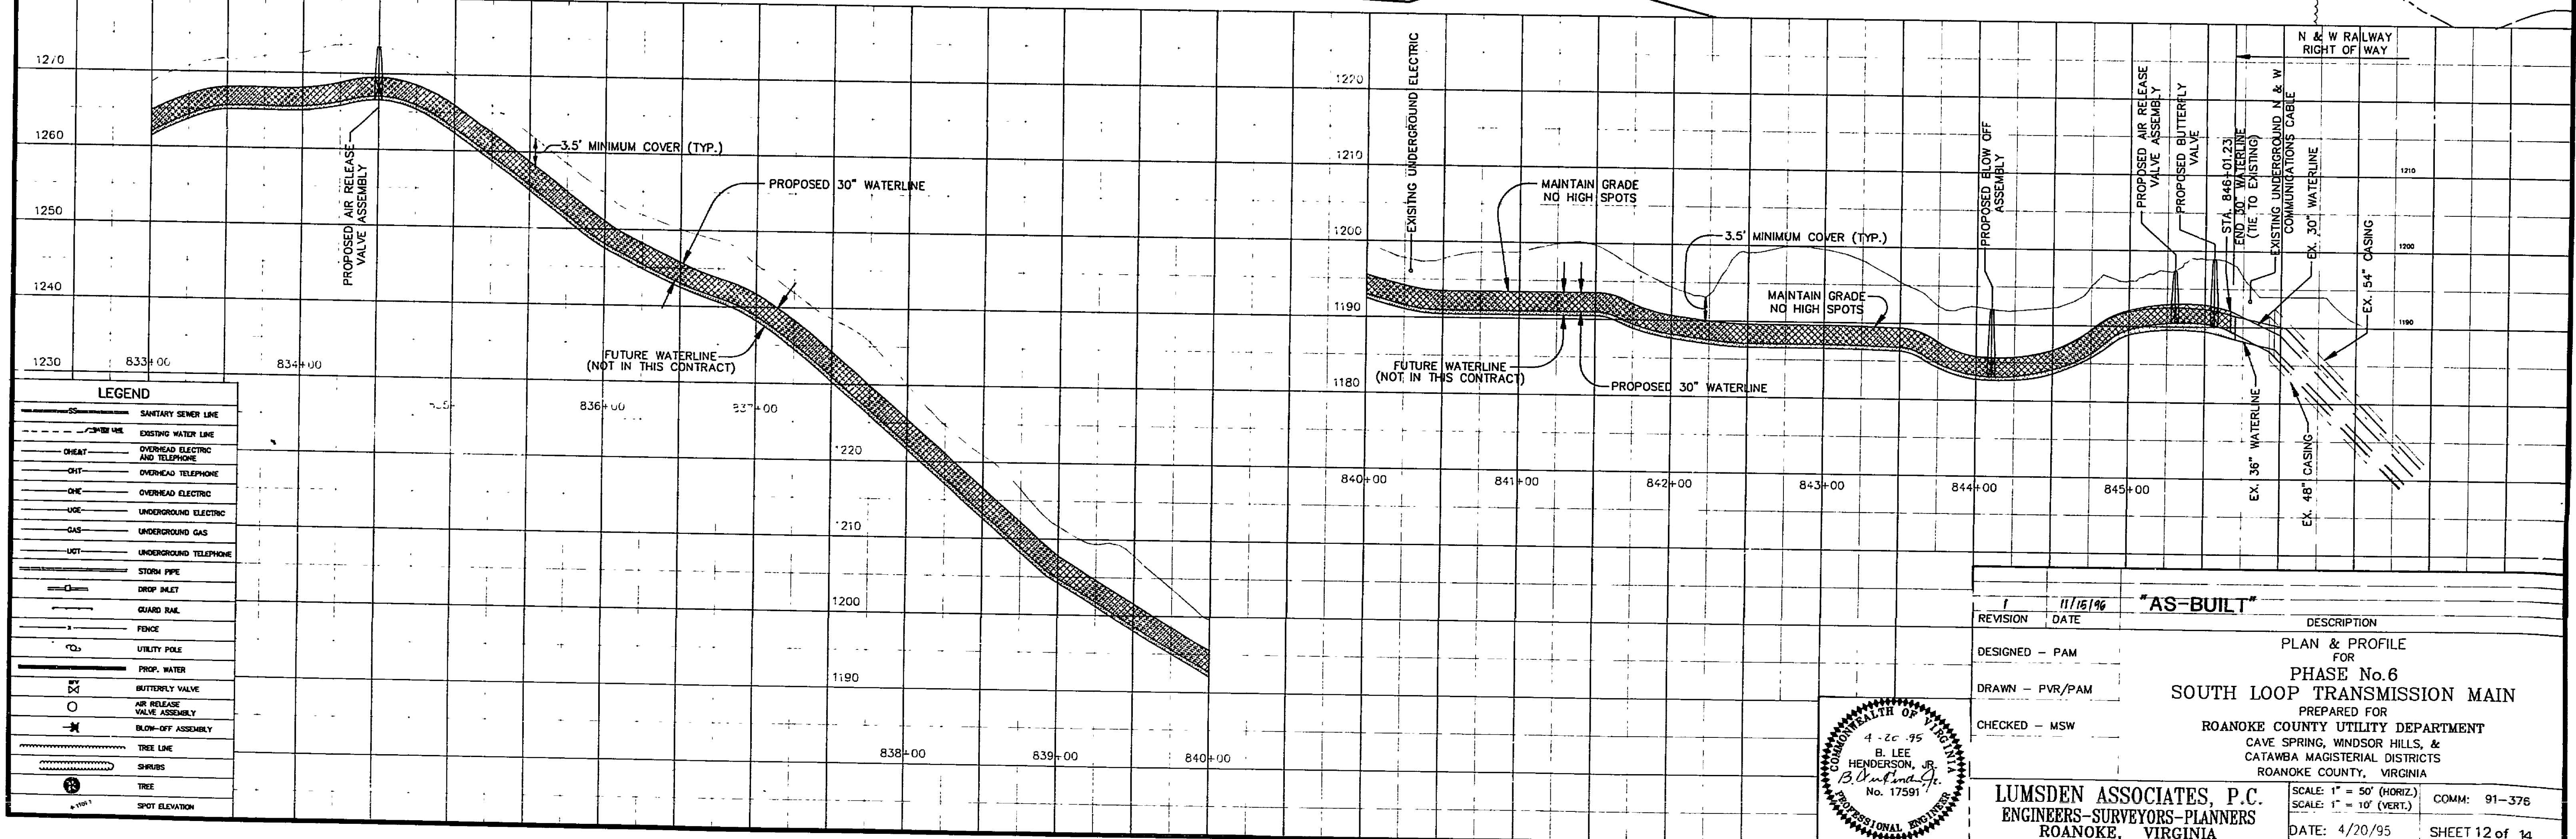


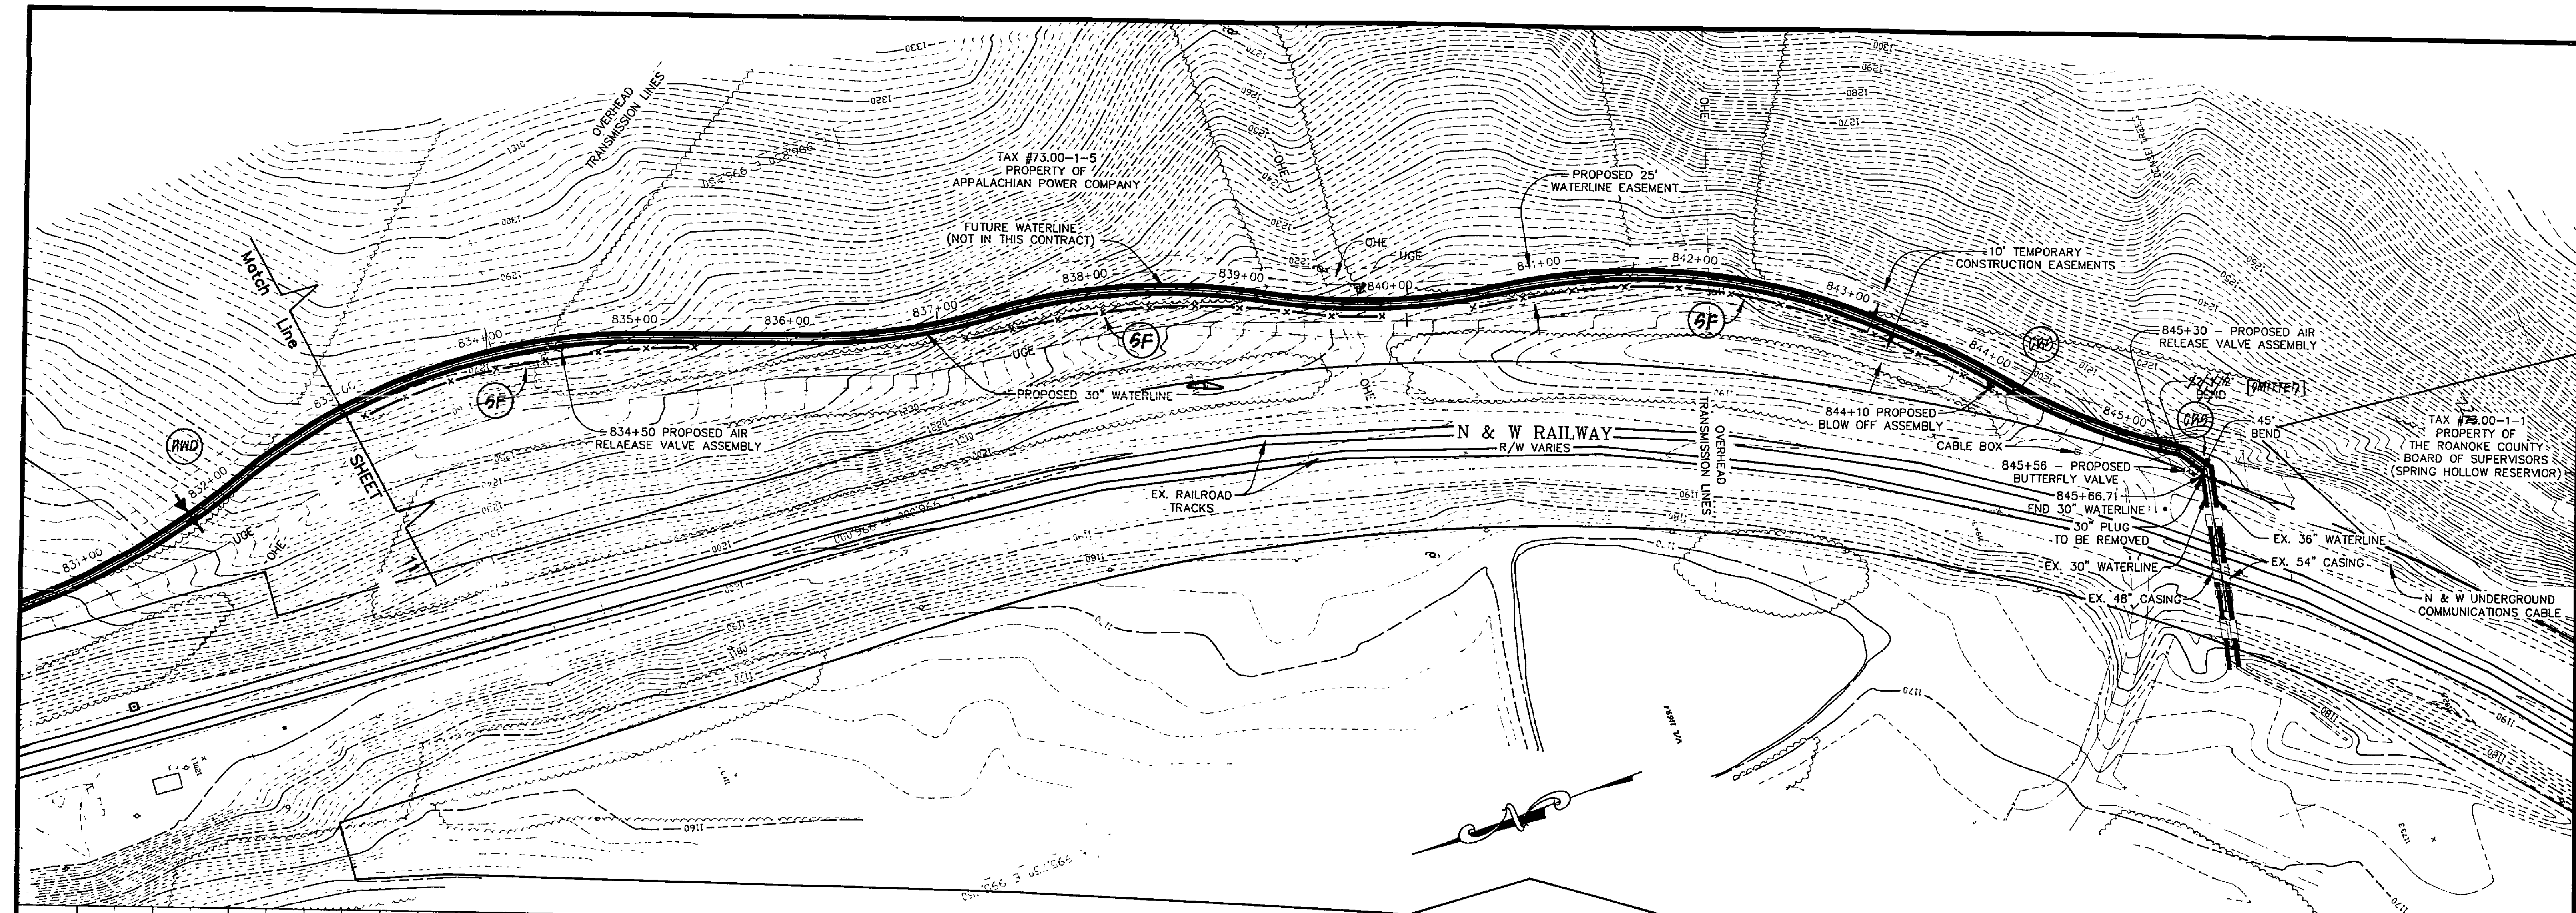

11/15/96		"AS-BUILT"	
REVISION	DATE	DESCRIPTION	
DESIGNED - PAM		PLAN & PROFILE FOR	
DRAWN - PVR/PAM		PHASE No. 6	
CHECKED - MSW		SOUTH LOOP TRANSMISSION MAIN	
		PREPARED FOR	
		ROANOKE COUNTY UTILITY DEPARTMENT	
		CAVE SPRING, WINDSOR HILLS, & CATAMBA MACISTERIAL DISTRICTS	
		ROANOKE COUNTY, VIRGINIA	
		LUMSDEN ASSOCIATES, P.C. ENGINEERS-SURVEYORS-PLANNERS ROANOKE, VIRGINIA	
SCALE: 1" = 50' (HORIZ.) SCALE: 1" = 10' (VERT.)		DATE: 4/20/95 COMM: 91-376 SHEET 12 of 14	

WT-0539