

"AS-BUILT" 15 NOVEMBER 1996
DEVELOPMENT PLAN

FOR

PHASE 7

SOUTH LOOP TRANSMISSION MAIN


SITUATED IN

CAVE SPRING, WINDSOR HILLS &
CATAWBA MAGISTERIAL DISTRICTS
ROANOKE COUNTY, VIRGINIA

DATE: 20 APRIL 1995

PROPERTY OF

ROANOKE COUNTY UTILITY DEPARTMENT

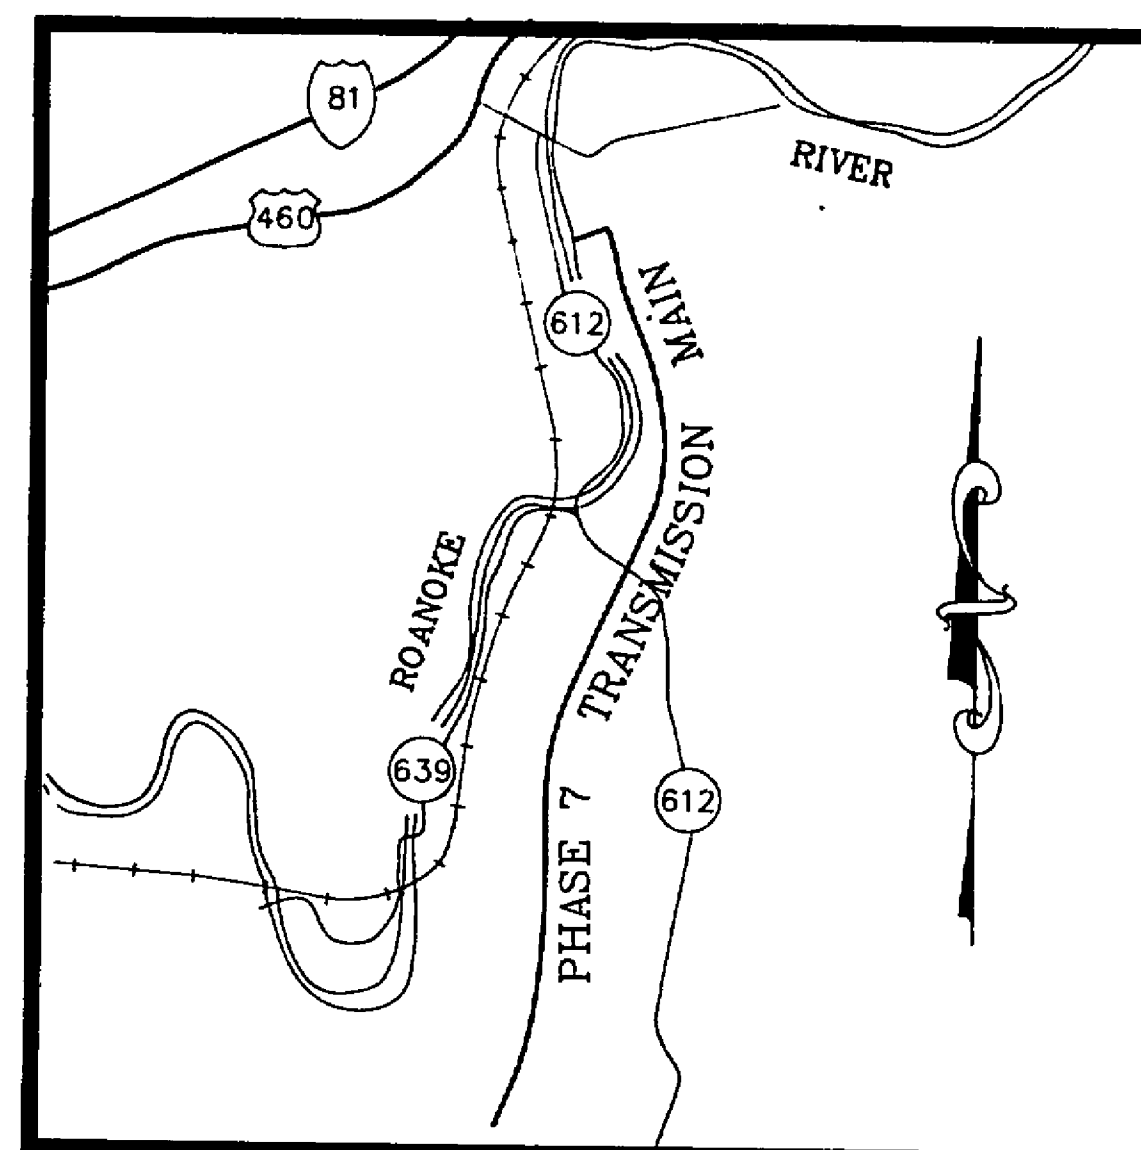

INDEX OF DRAWINGS

SHEET No.	DESCRIPTION
-----------	-------------

- | | |
|-------|---|
| 1. | LUMSDEN ASSOCIATES COVER SHEET |
| 2. | PLAN & PROFILE SHEET LAYOUT |
| 3.-9. | PLAN & PROFILE |
| 10. | WATER DETAILS |
| 11. | ROANOKE CO. STD. EROSION CONTROL DETAIL SHEET |

LUMSDEN ASSOCIATES, P.C.
ENGINEERS-SURVEYORS-PLANNERS
ROANOKE, VIRGINIA

"AS-BUILT"

NOTES:
1) "AS-BUILT" INFORMATION TAKEN FROM
PLANS FURNISHED BY ROANOKE COUNTY.
2) "AS-BUILT" DIMENSIONS SHOWN IN
BRACKETS.

WT-0542