


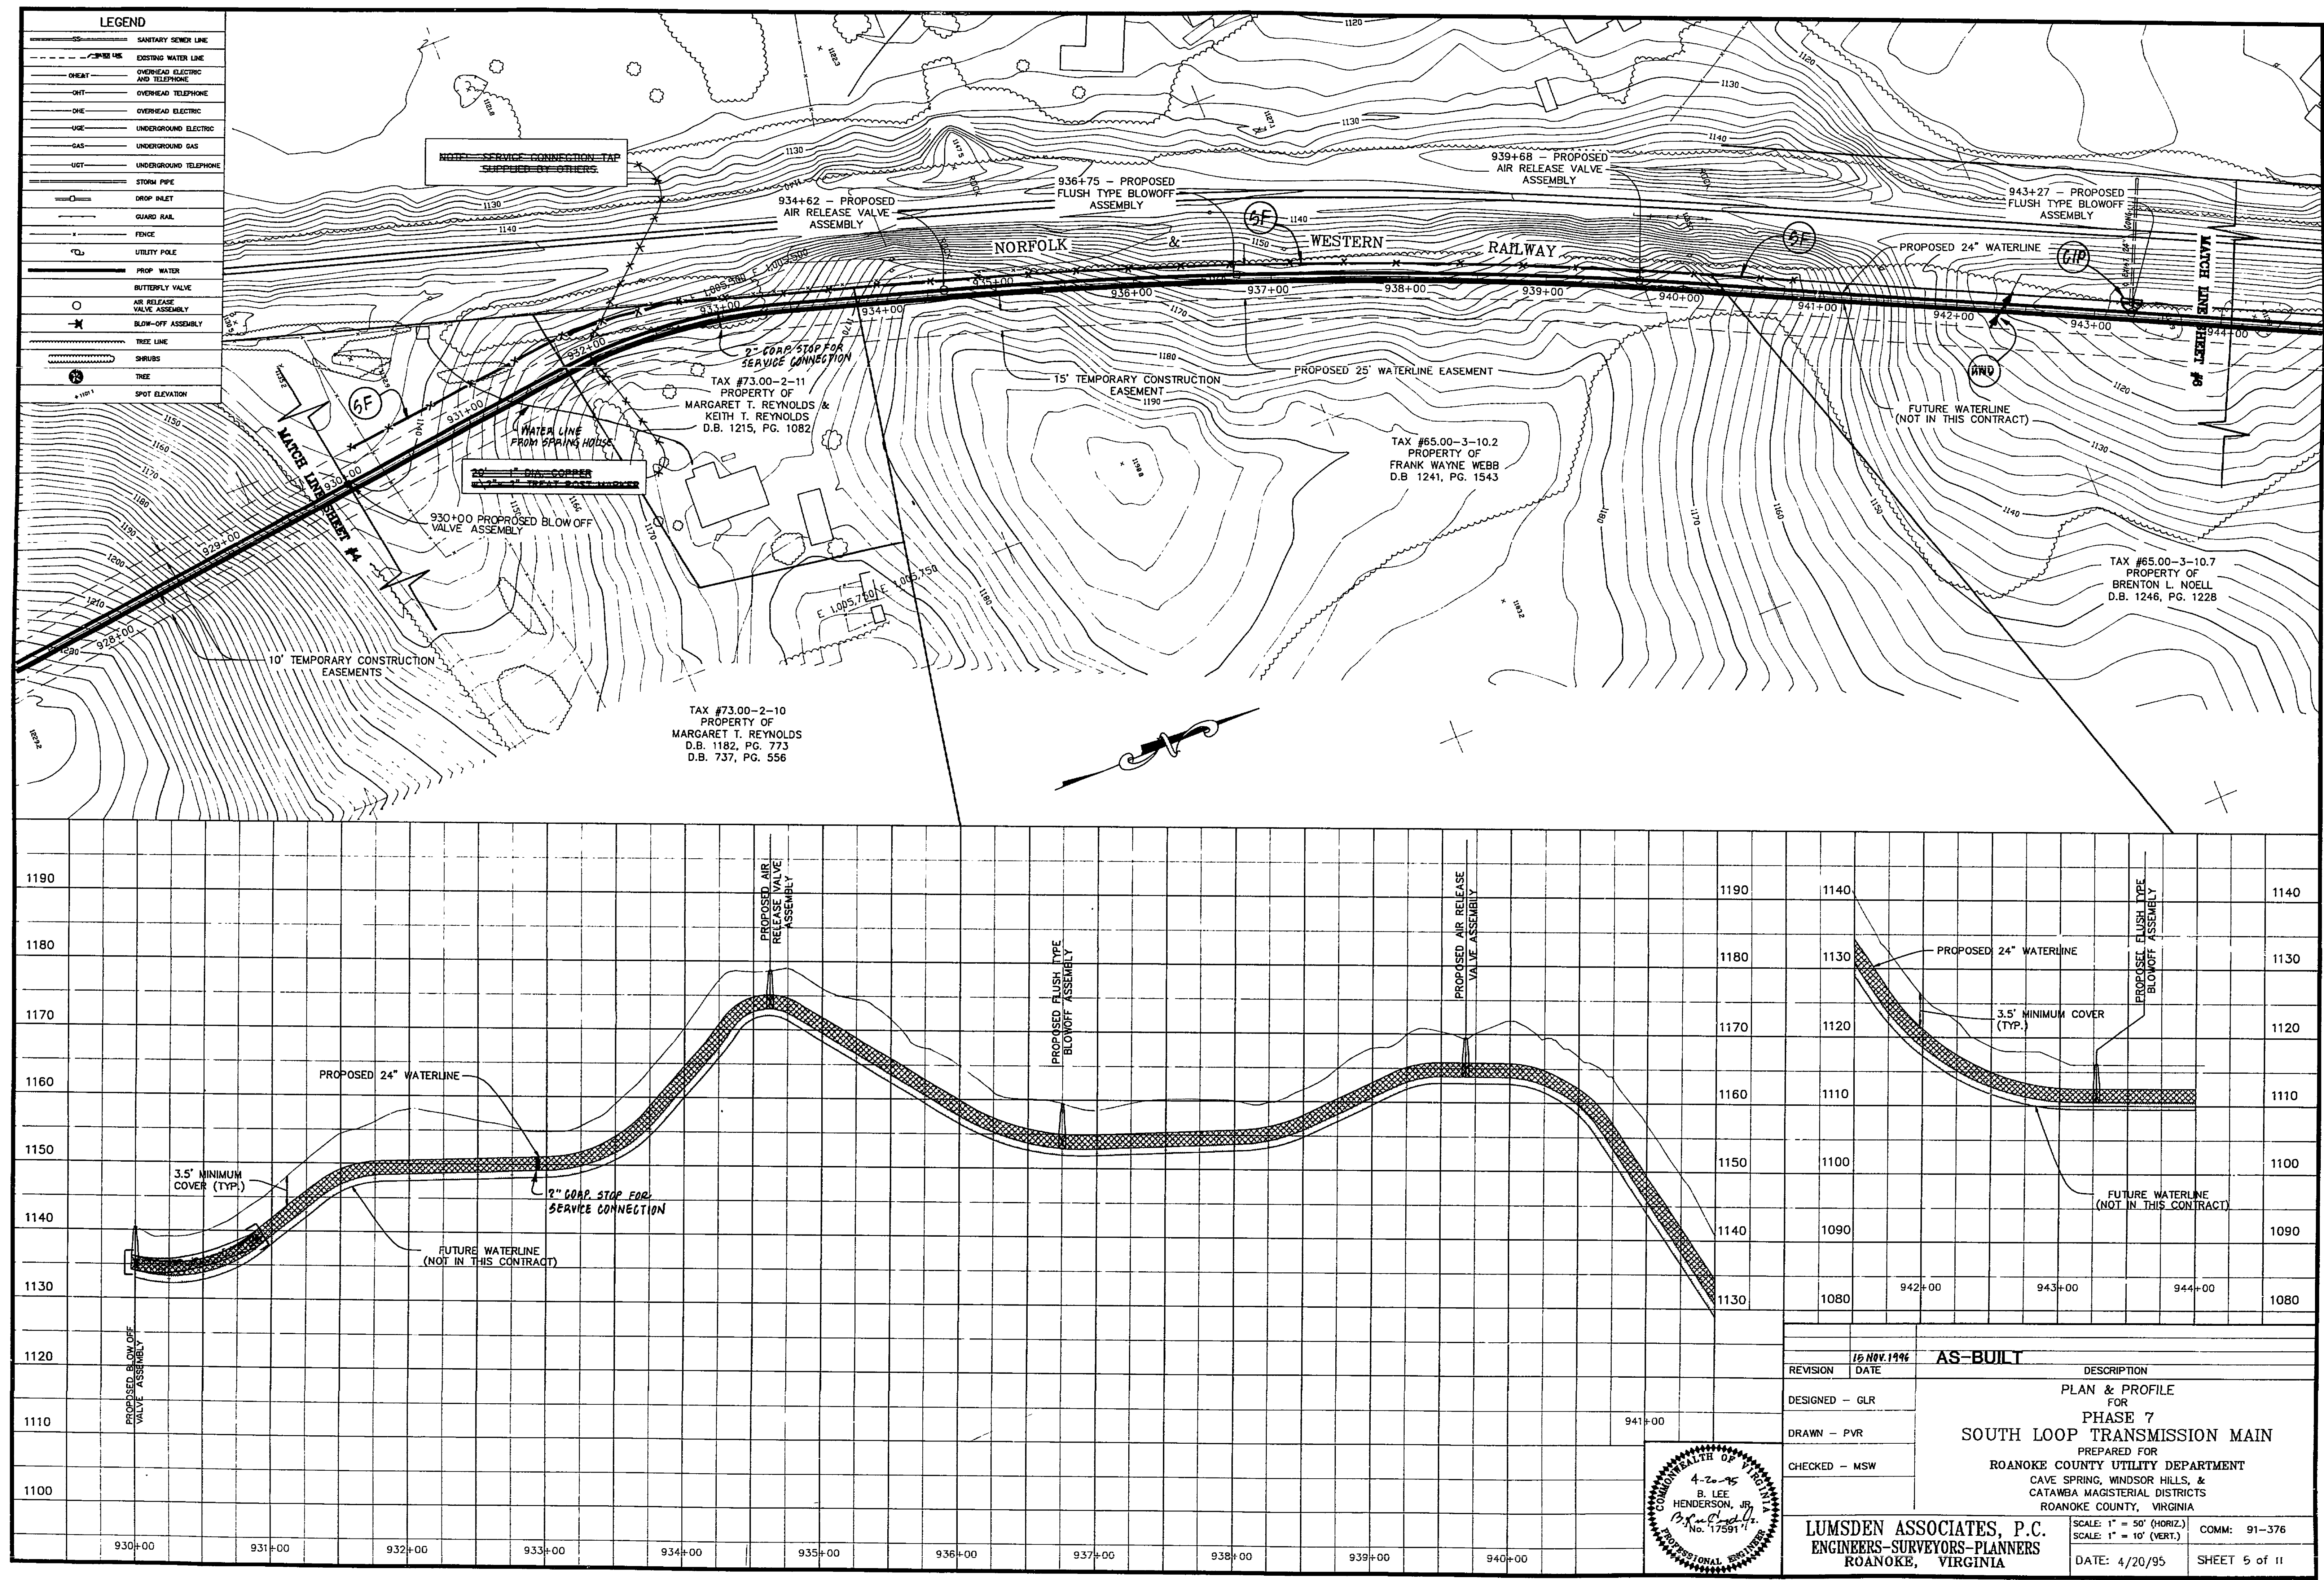

REVISION	15 NOV 1996	DATE	AS-BUILT
DESIGNED	GLR	DESCRIPTION	PLAN & PROFILE FOR PHASE 7 SOUTH LOOP TRANSMISSION MAIN
DRAWN	PVR	PREPARED FOR	ROANOKE COUNTY UTILITY DEPARTMENT
CHECKED	MSW	CAVE SPRING, WINDSOR HILLS, & CATAWBA MAGISTERIAL DISTRICTS	ROANOKE COUNTY, VIRGINIA
LUMSDEN ASSOCIATES, P.C.		SCALE: 1" = 50' (HORIZ.)	COMM: 91-376
ENGINEERS-SURVEYORS-PLANNERS		SCALE: 1" = 10' (VERT.)	DATE: 4/20/95
ROANOKE, VIRGINIA			SHEET 5 of 11

WT-0546