


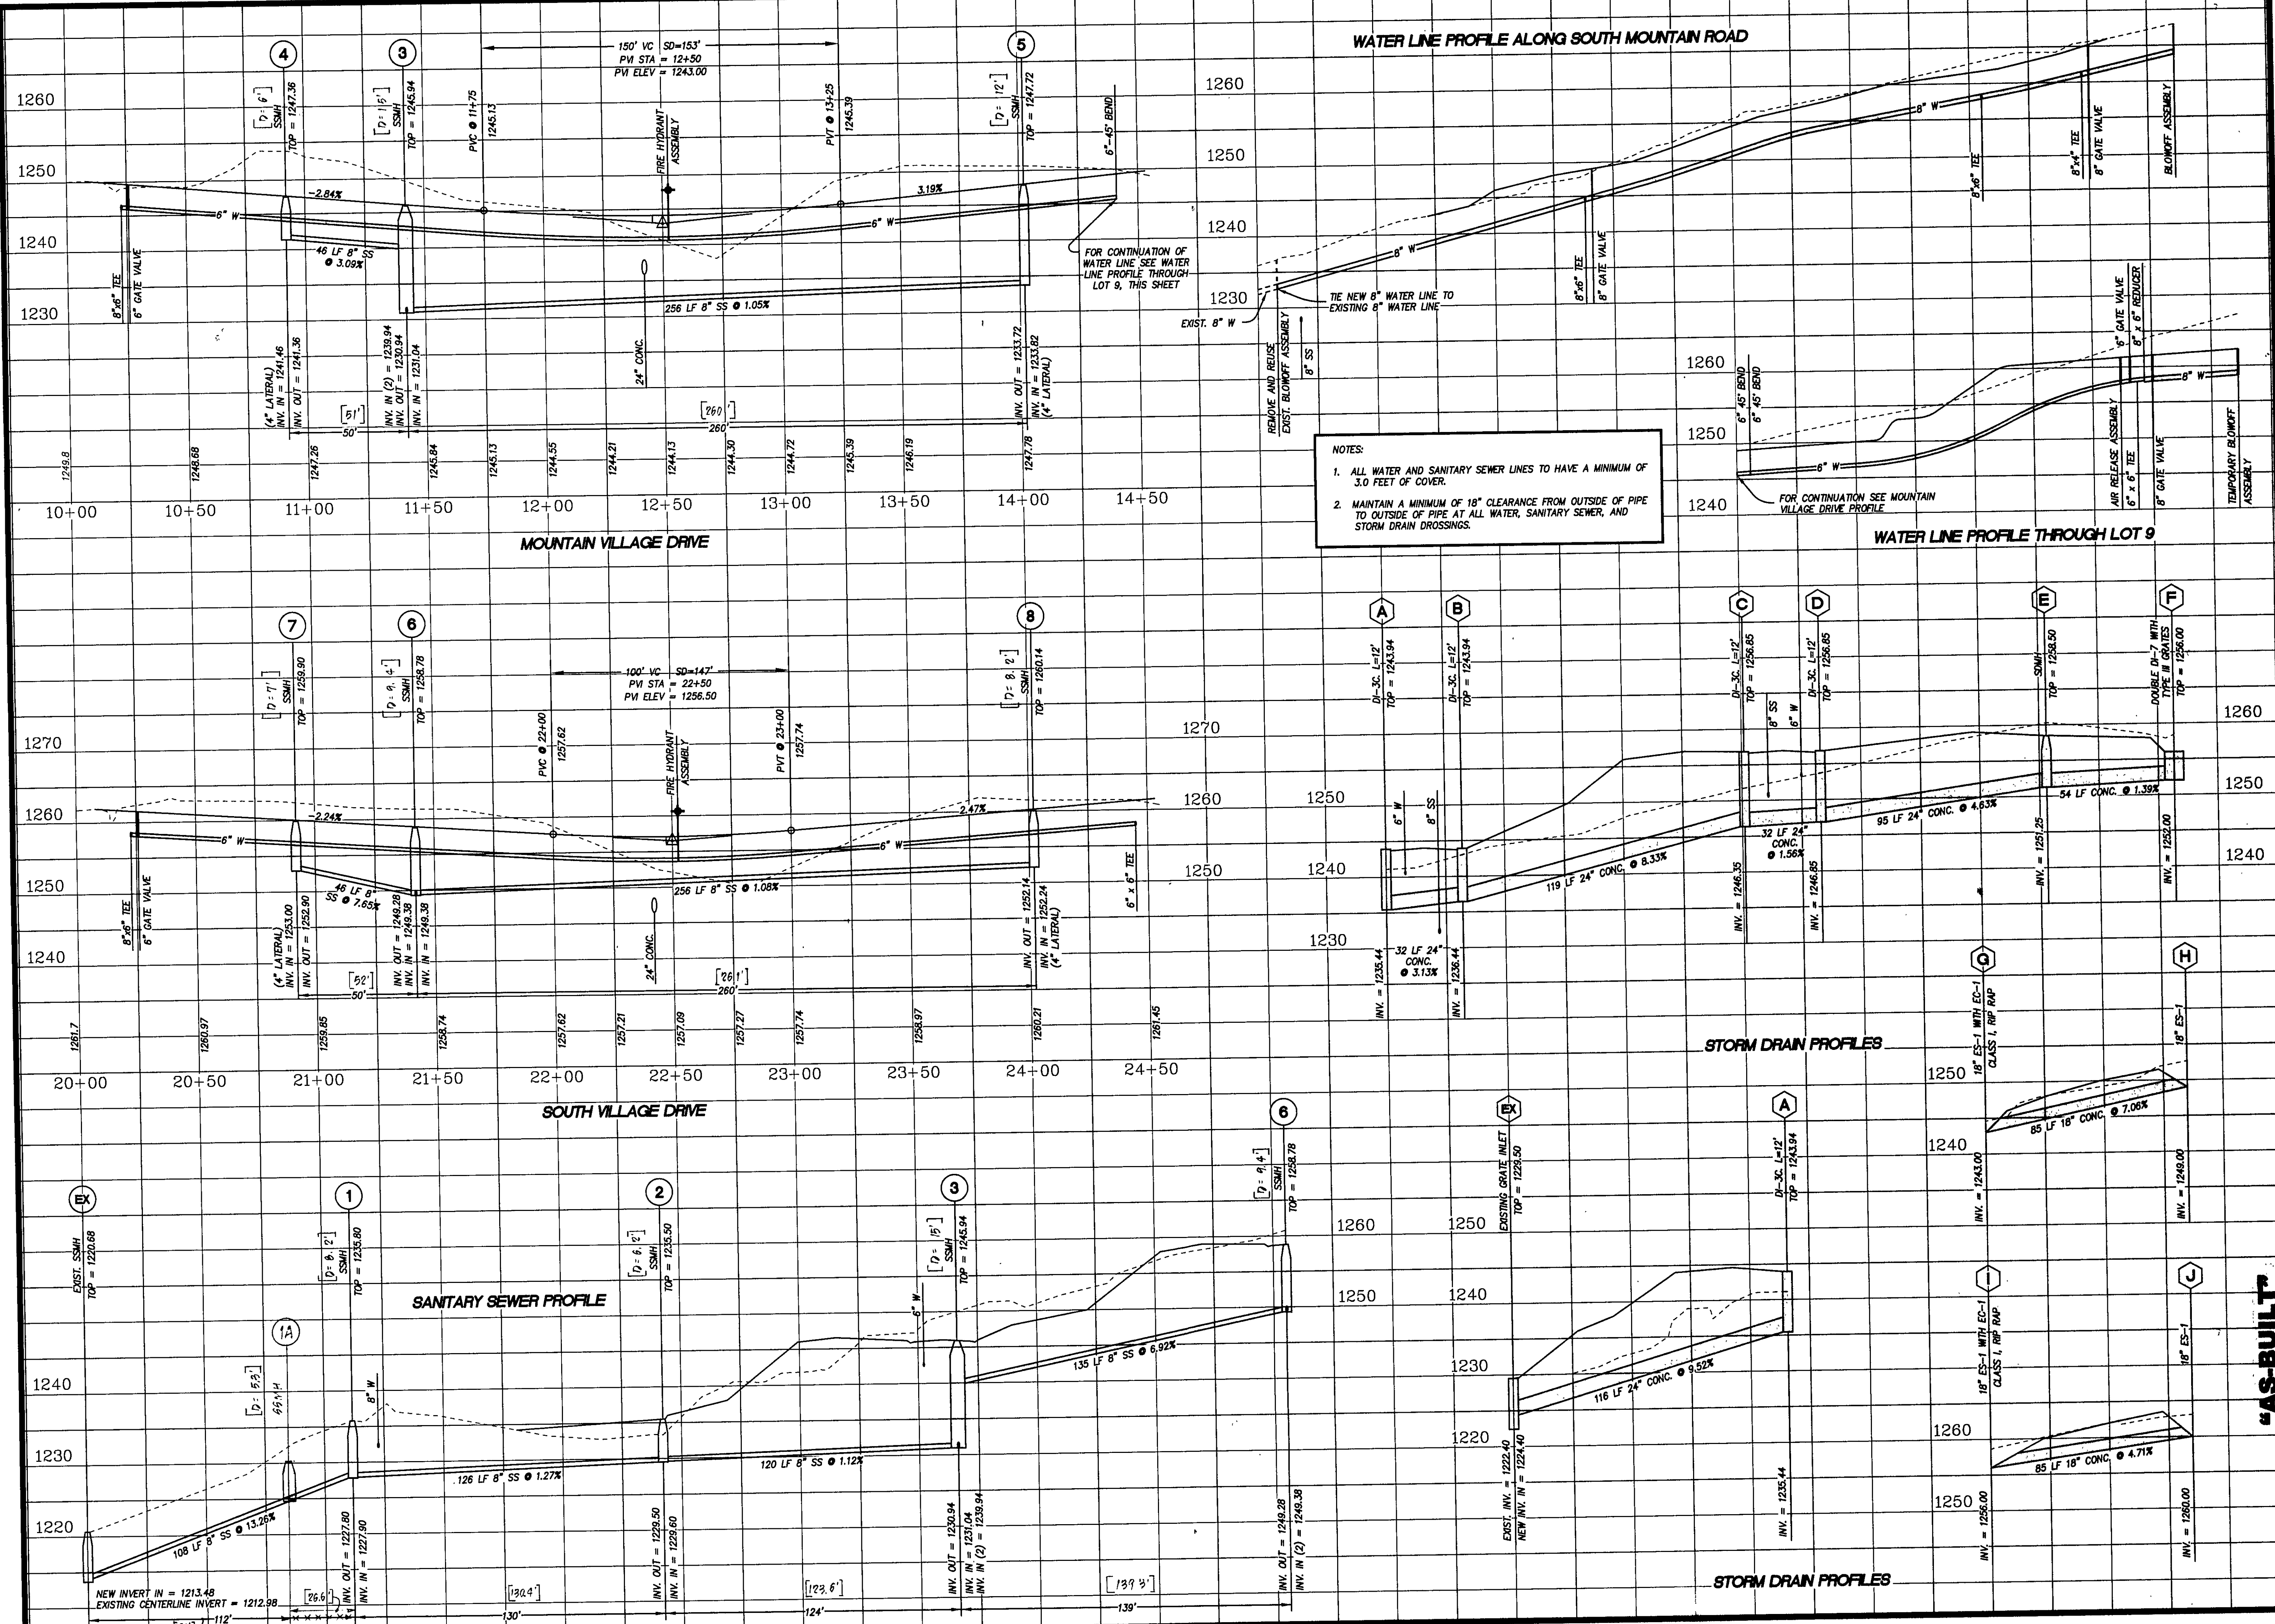

LUMSDEN ASSOCIATES, P.C.
ENGINEERS-SURVEYORS-PLANNERS
ROANOKE, VIRGINIA

4664 BRAMBLETON AVENUE
P.O. BOX 20669
ROANOKE, VIRGINIA 24018
PHONE (540) 774-4411
FAX (540) 774-2505
E-MAIL: MAIL@LUMSDENPC.COM

COMMONWEALTH OF VIRGINIA
No. 033002
9/25/02
PROFESSIONAL ENGINEER

PROFILES

SOUTH MOUNTAIN VILLAGE

PREPARED FOR
RADFORD & COMPANY
CAVE SPRING MAGISTERIAL DISTRICT
ROANOKE COUNTY, VIRGINIA

"AS-BUILT"

NO.	DATE	DESCRIPTION
1	10-01-03	AS-BUILT SANITARY SEWER
2		
3		
4		
5		

DATE: SEPTEMBER 25, 2002
SCALE: 1" = 30'
COMMISSION NO.: 2002-053
SHEET 7 OF 9